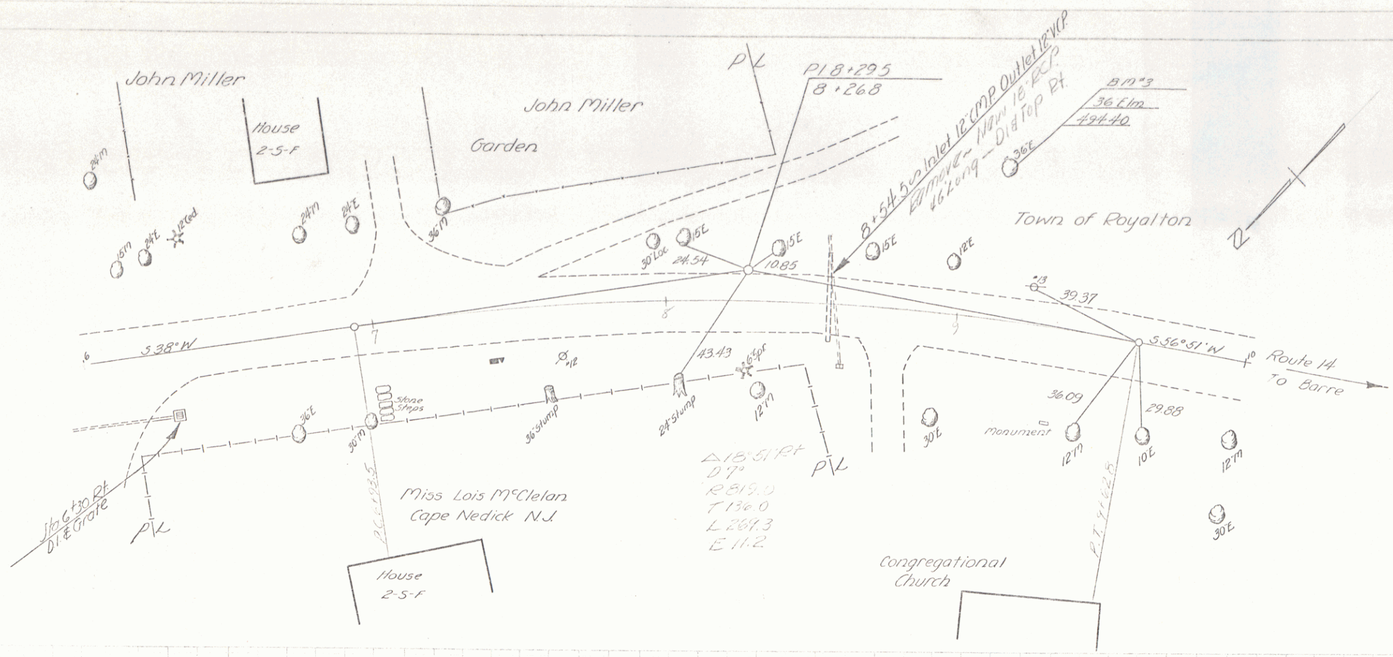

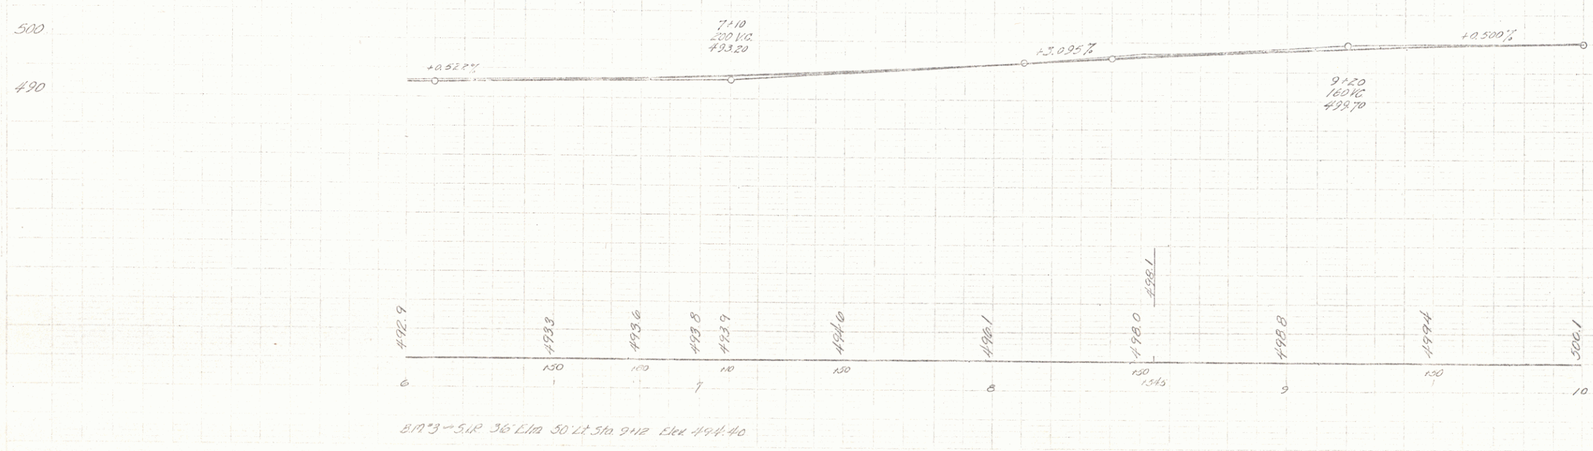

ROYALTON VILLAGE
ST. 94
SHEET 2

2