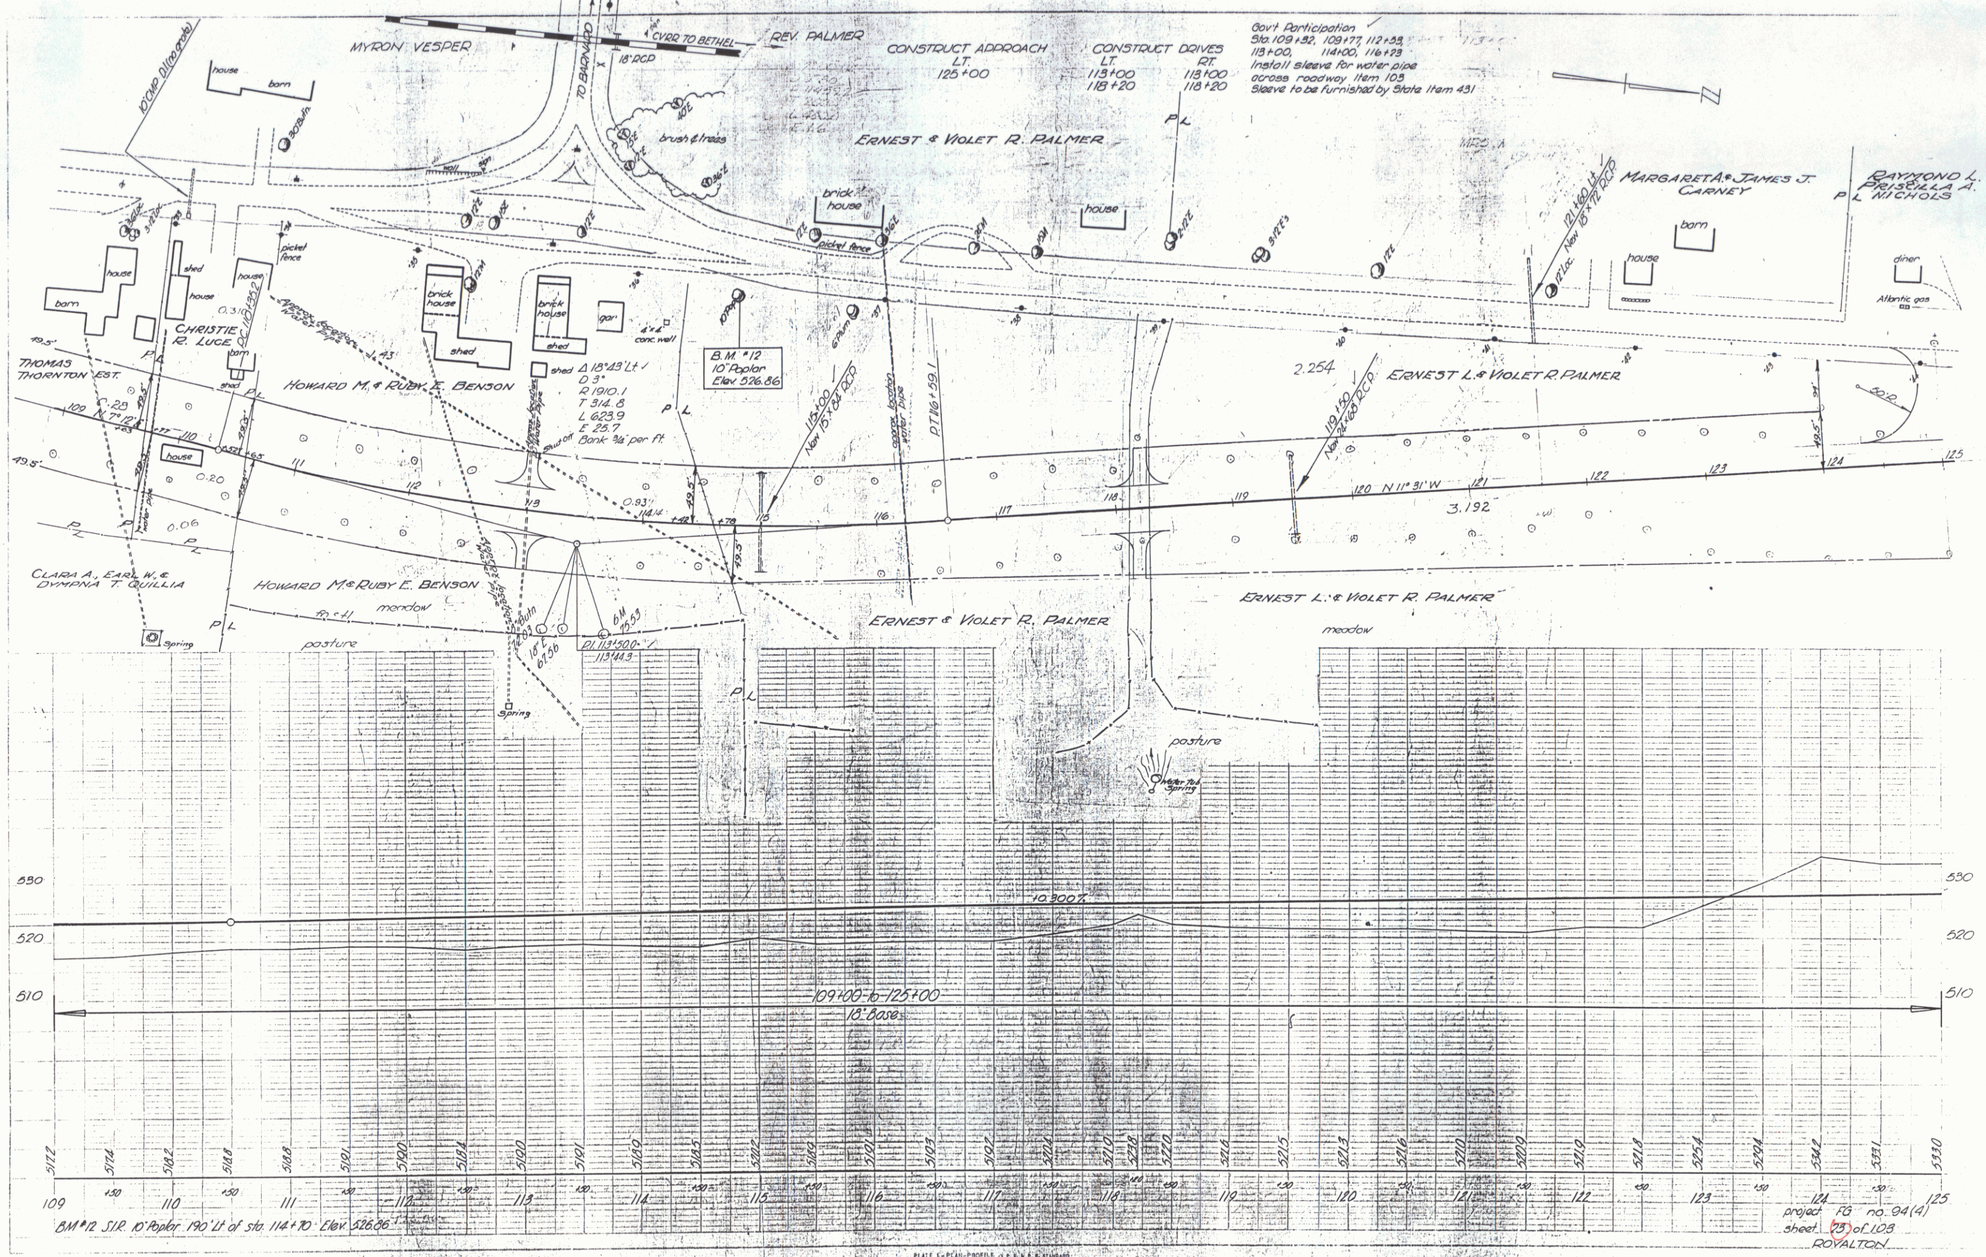
MYRON VESPER
CVRR TO BETHEL
REV. PALMER
TO BROMLEY
CONSTRUCT APPROACH
LT. 125+00
CONSTRUCT DRIVES
LT. 113+00 118+20
RT. 113+00 118+20
Gov't Participation
Sta. 109+52, 109+77, 112+58
113+00, 114+00, 116+23
Install sleeve for water pipe
across roadway Item 103
Sleeve to be furnished by State Item 431
ERNEST & VIOLET R. PALMER
MARGARET A. & JAMES J. CARNEY
RAYMOND L. PRISCILLA A. P.L. NICHOLS
CHRISTIE R. LUCE
THOMAS THORNTON EST.
HOWARD M. & RUBY E. BENSON
ERNEST L. & VIOLET R. PALMER
CLARA A., EARL W. & DYMPNA T. QUILLIA
HOWARD M. & RUBY E. BENSON
ERNEST & VIOLET R. PALMER
ERNEST L. & VIOLET R. PALMER
meadow
pasture
B.M. #12
10" Poplar
Elev. 526.86
109+00 to 125+00
18" Base
BM #12 S.I.R. 10" Poplar 190' Lt of sta. 114+70 Elev. 526.86
project FG no. 94(4)
sheet 73 of 108
ROYALTON

3