FED. AID. PROJ. NO.	STATE	FED. RD. DIV.	FISCAL YEAR	SHEET NO.	TOTAL SHEETS
[illegible]		1	[illegible]	[illegible]	[illegible]

WOOD GUARD RAIL REQUIRED

LEFT

STA. 61+00 TO STA. 61+12 - LENGTH 12 FT.

RIGHT

STA. 61+00 TO STA. 61+12 - LENGTH 12 FT.
" 65+73 " " 66+97 " 24 "
" 71+00 " " 72+12 " 24 "

TOTAL FOR SHEET → 72 FT.

CABLE GUARD RAIL REQUIRED

LEFT

STA. 65+30 TO STA. 67+24 - LENGTH 144'
" 68+80 " " 70+24 " 144'
" 71+20 " " 73+84 " 264'

TOTAL FOR SHEET → 552 FT.

PIPE CULVERTS REQUIRED

STA. 66+[illegible] - 15" REINF. CONCRETE PIPE - LENGTH 38'
Concrete Class B(1-1½-3) - 1.9 cu. yds.
Reinforcing Steel - 33 lbs.

STA. 72+00 - 15" REINF. CONCRETE PIPE - LENGTH 30'
Concrete Class B(1-2½-3) - 1.5 cu. yds.
Reinforcing Steel - 33 lbs.

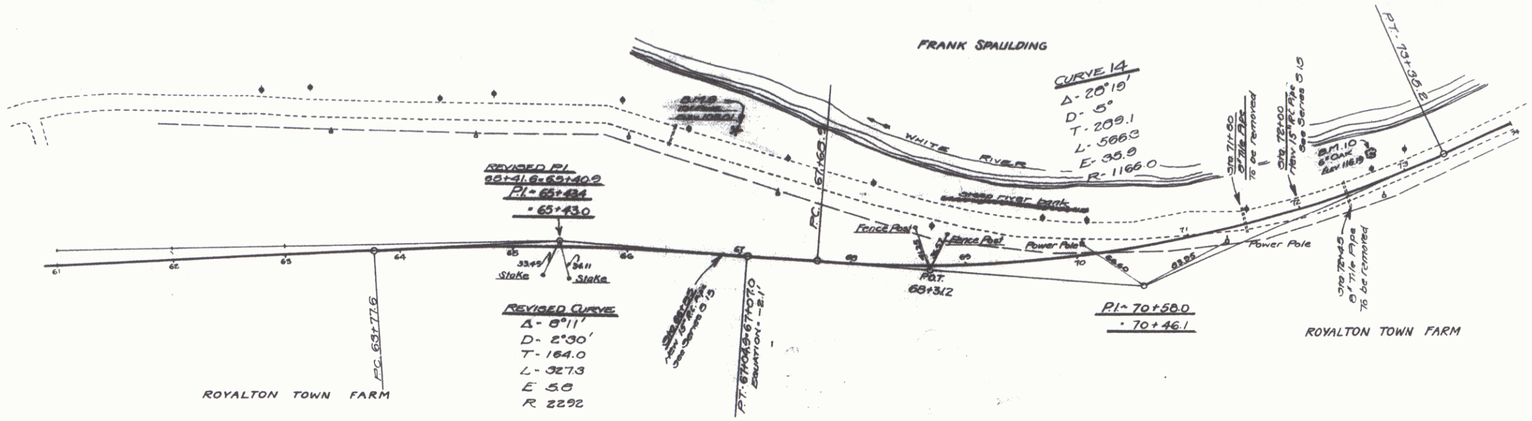

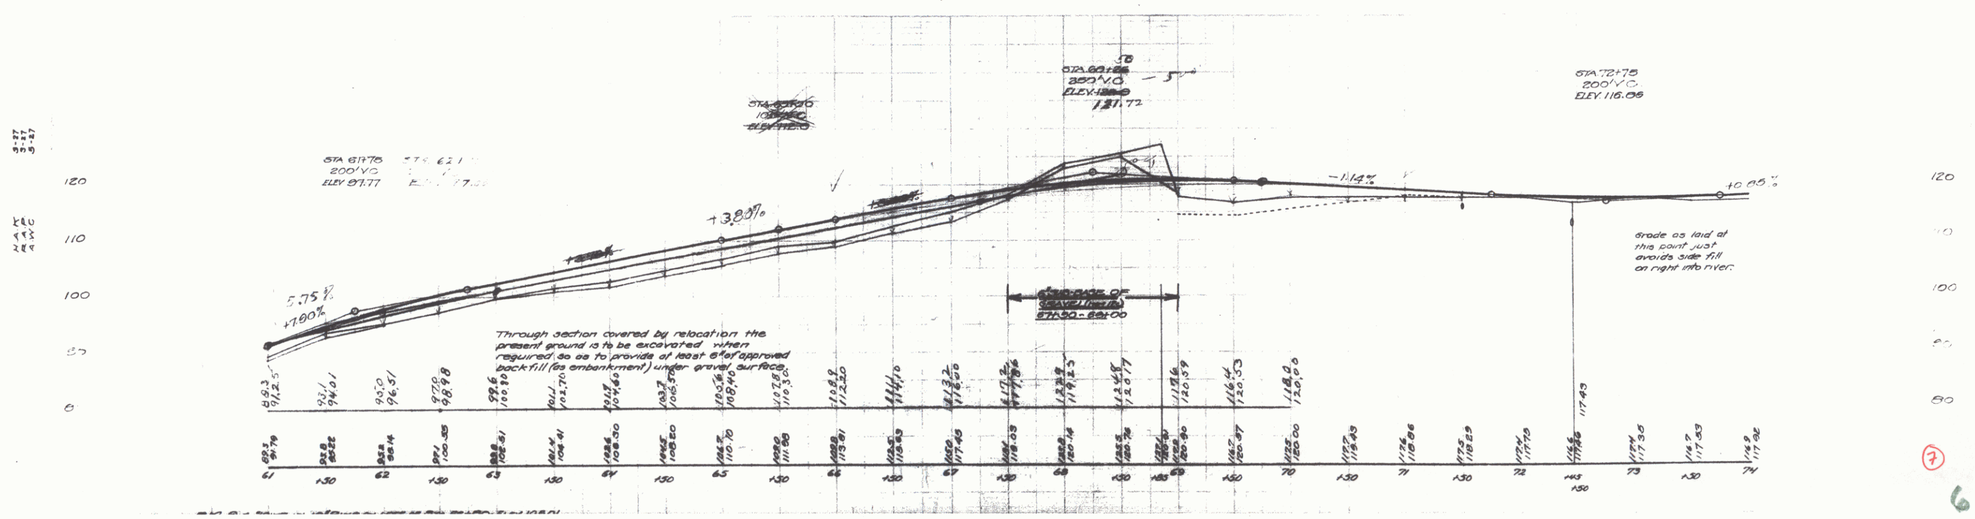

7

6