Sta. 273+60 - 2x2 Reinf. Conc. Box Culvert
Concrete Class A(F-E-A) - 109 cu. yds.
Reinf. Steel - 709 lbs.

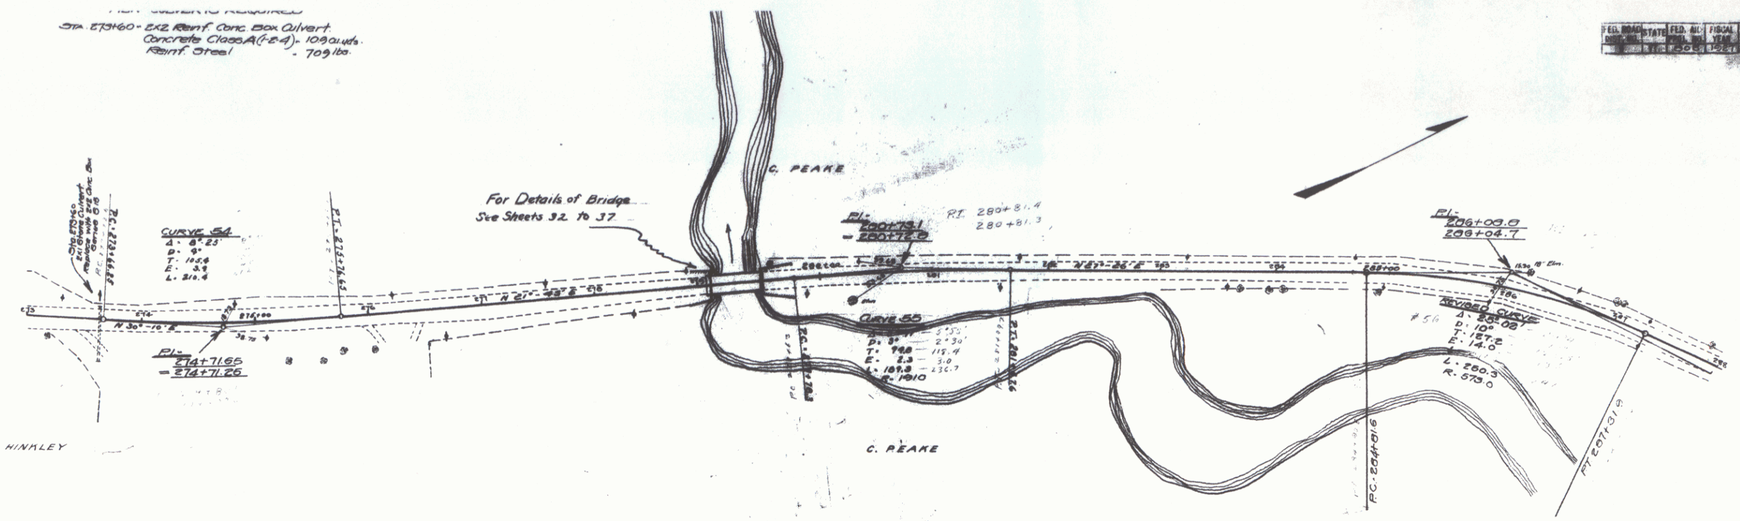

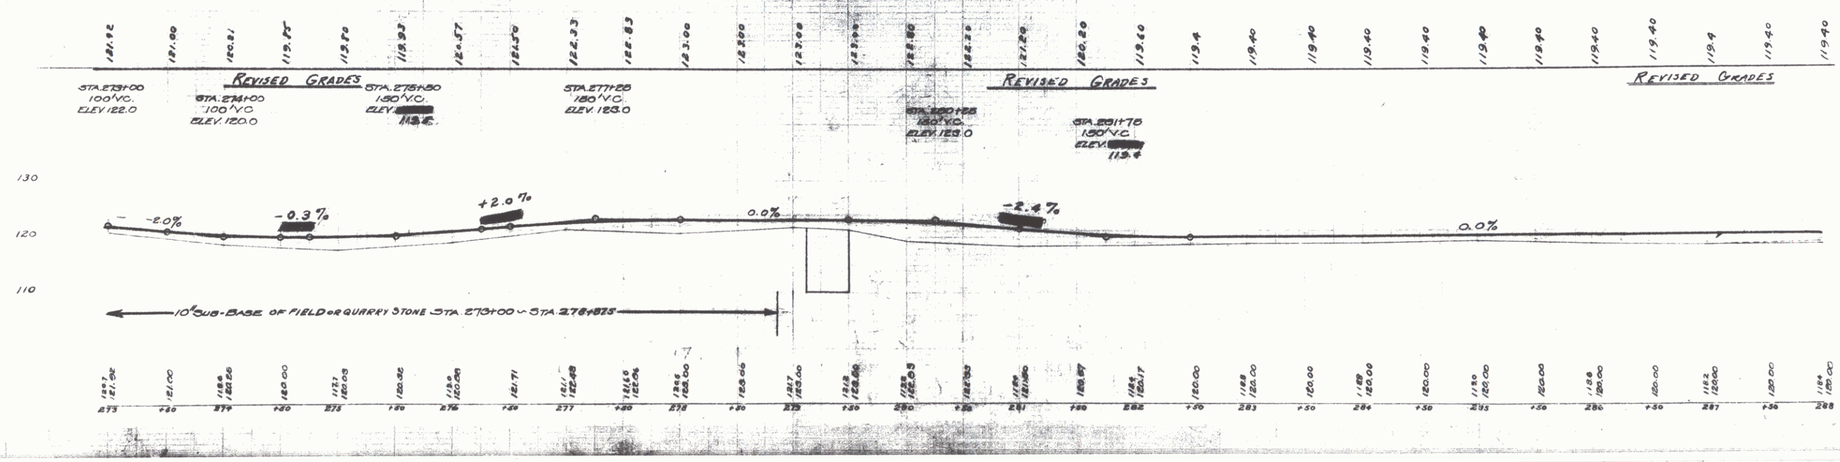

21