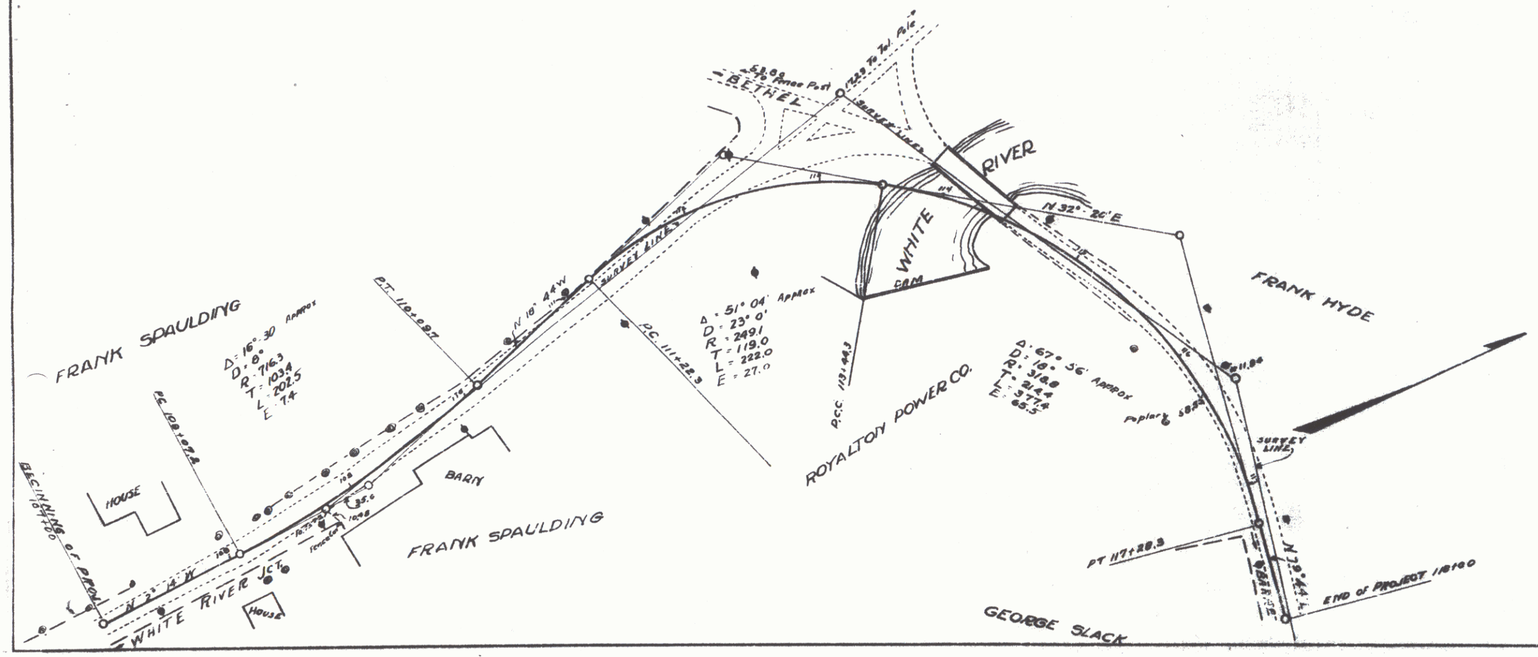
BETHEL
RIVER
WHITE
FRANK SPAULDING
FRANK HYDE
ROYALTON POWER CO.
HOUSE
BARN
FRANK SPAULDING
WHITE RIVER JCT.
GEORGE SLACK
SURVEY LINE
END OF PROJECT 1+81.00

SHEET 3A

3