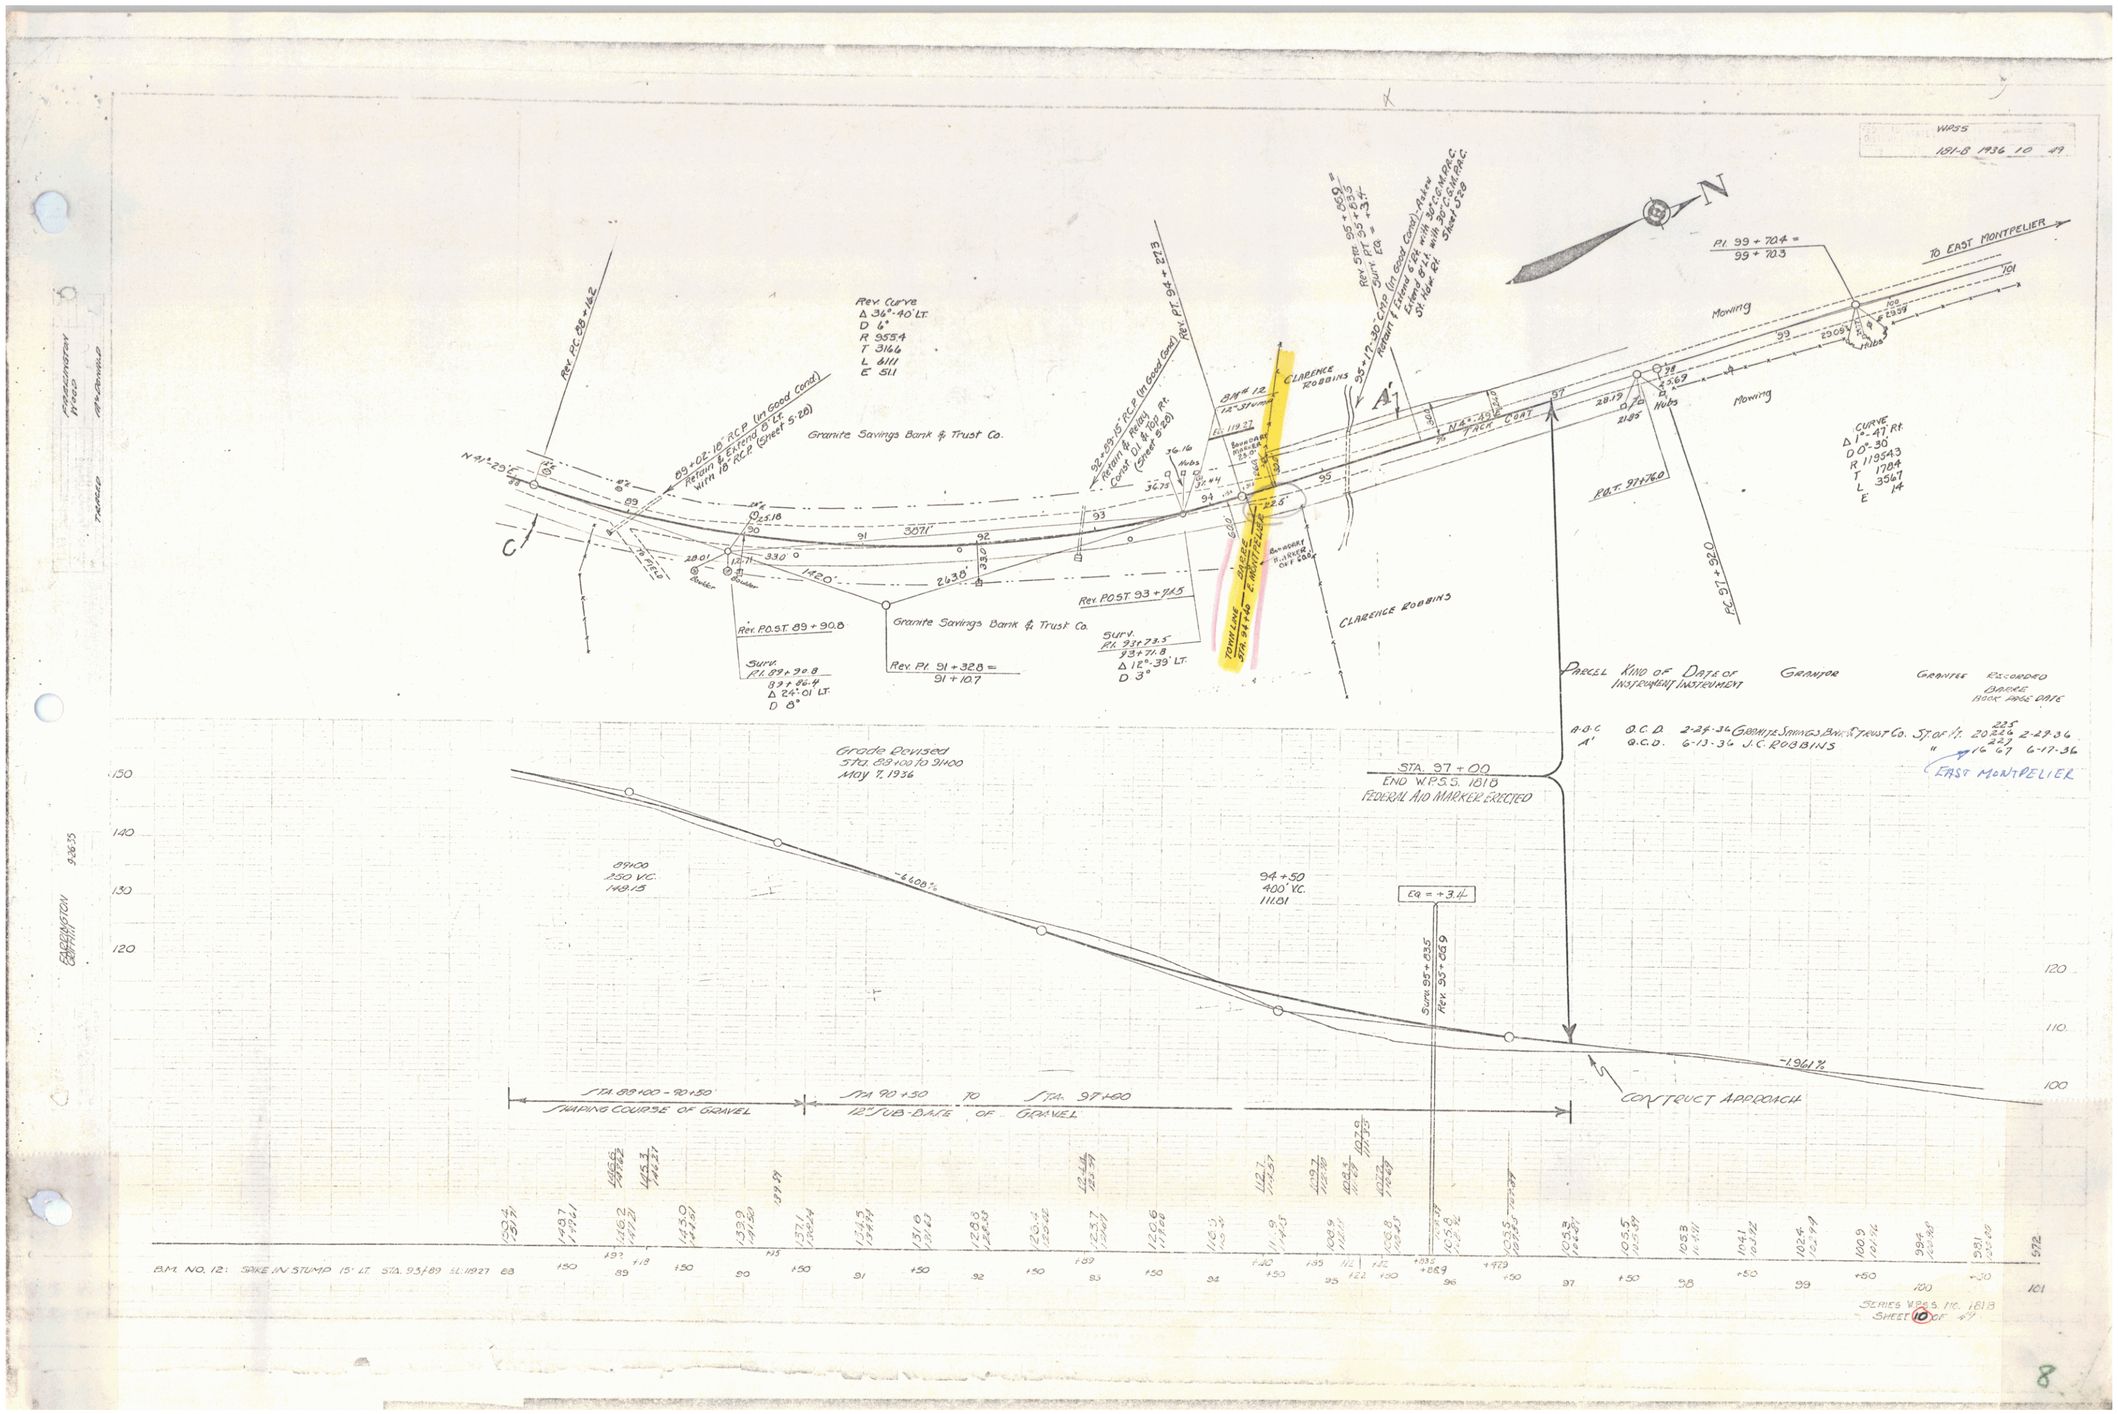

Parcel	Kind of Instrument	Date of Instrument	Grantor	Grantee	Recorded Book	Page	Date
A-B-C	Q.C.D.	2-24-36	Granite Savings Bank & Trust Co.	State of Vt.	20	225	2-27-36
A'	Q.C.D.	6-13-36	J.C. Robbins	"	16	225 67	6-17-36

EAST MONTPELIER