


PLUM
 DRAWN BY: NADOLSKI 8/24
 DATE: 8/24
 CHECKED BY: D. W. CASCHL 8/24
 TRACED

PROFILE
 DRAWN BY: NADOLSKI 8/24
 DATE: 8/24
 CHECKED BY: D. W. CASCHL 8/24
 TRACED

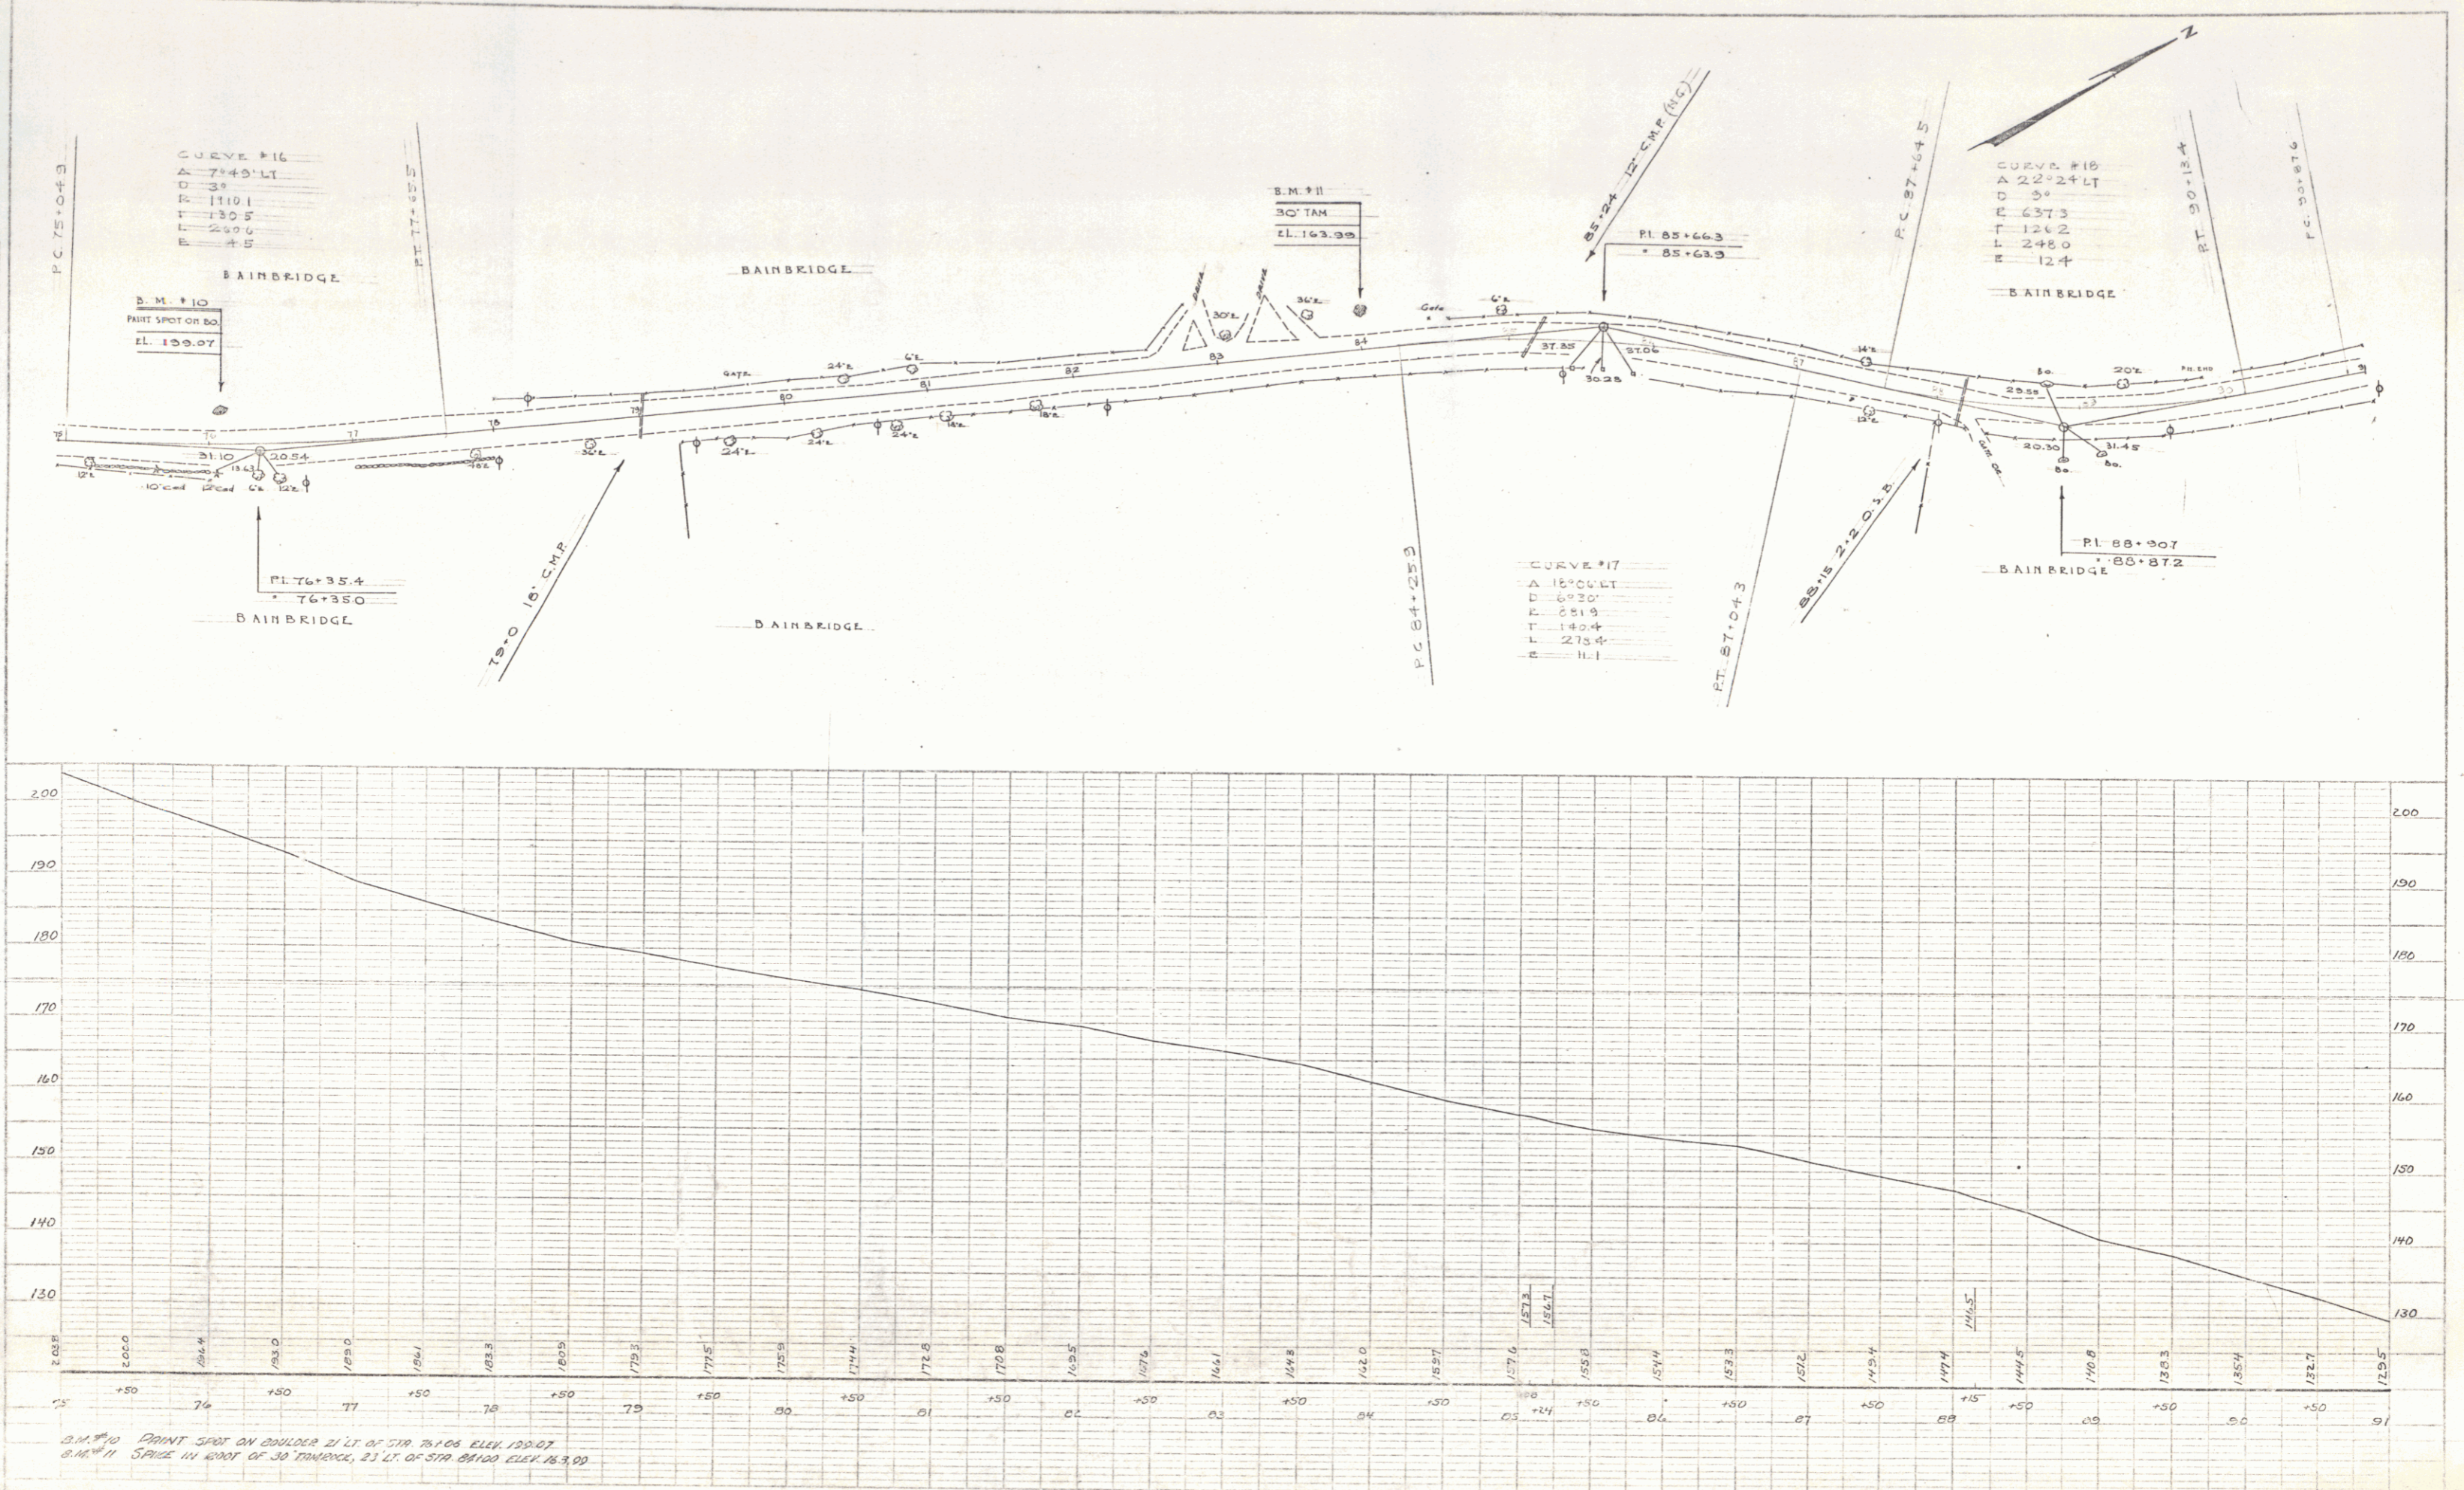



SHEET 9

11