


TQF 037-2(2)



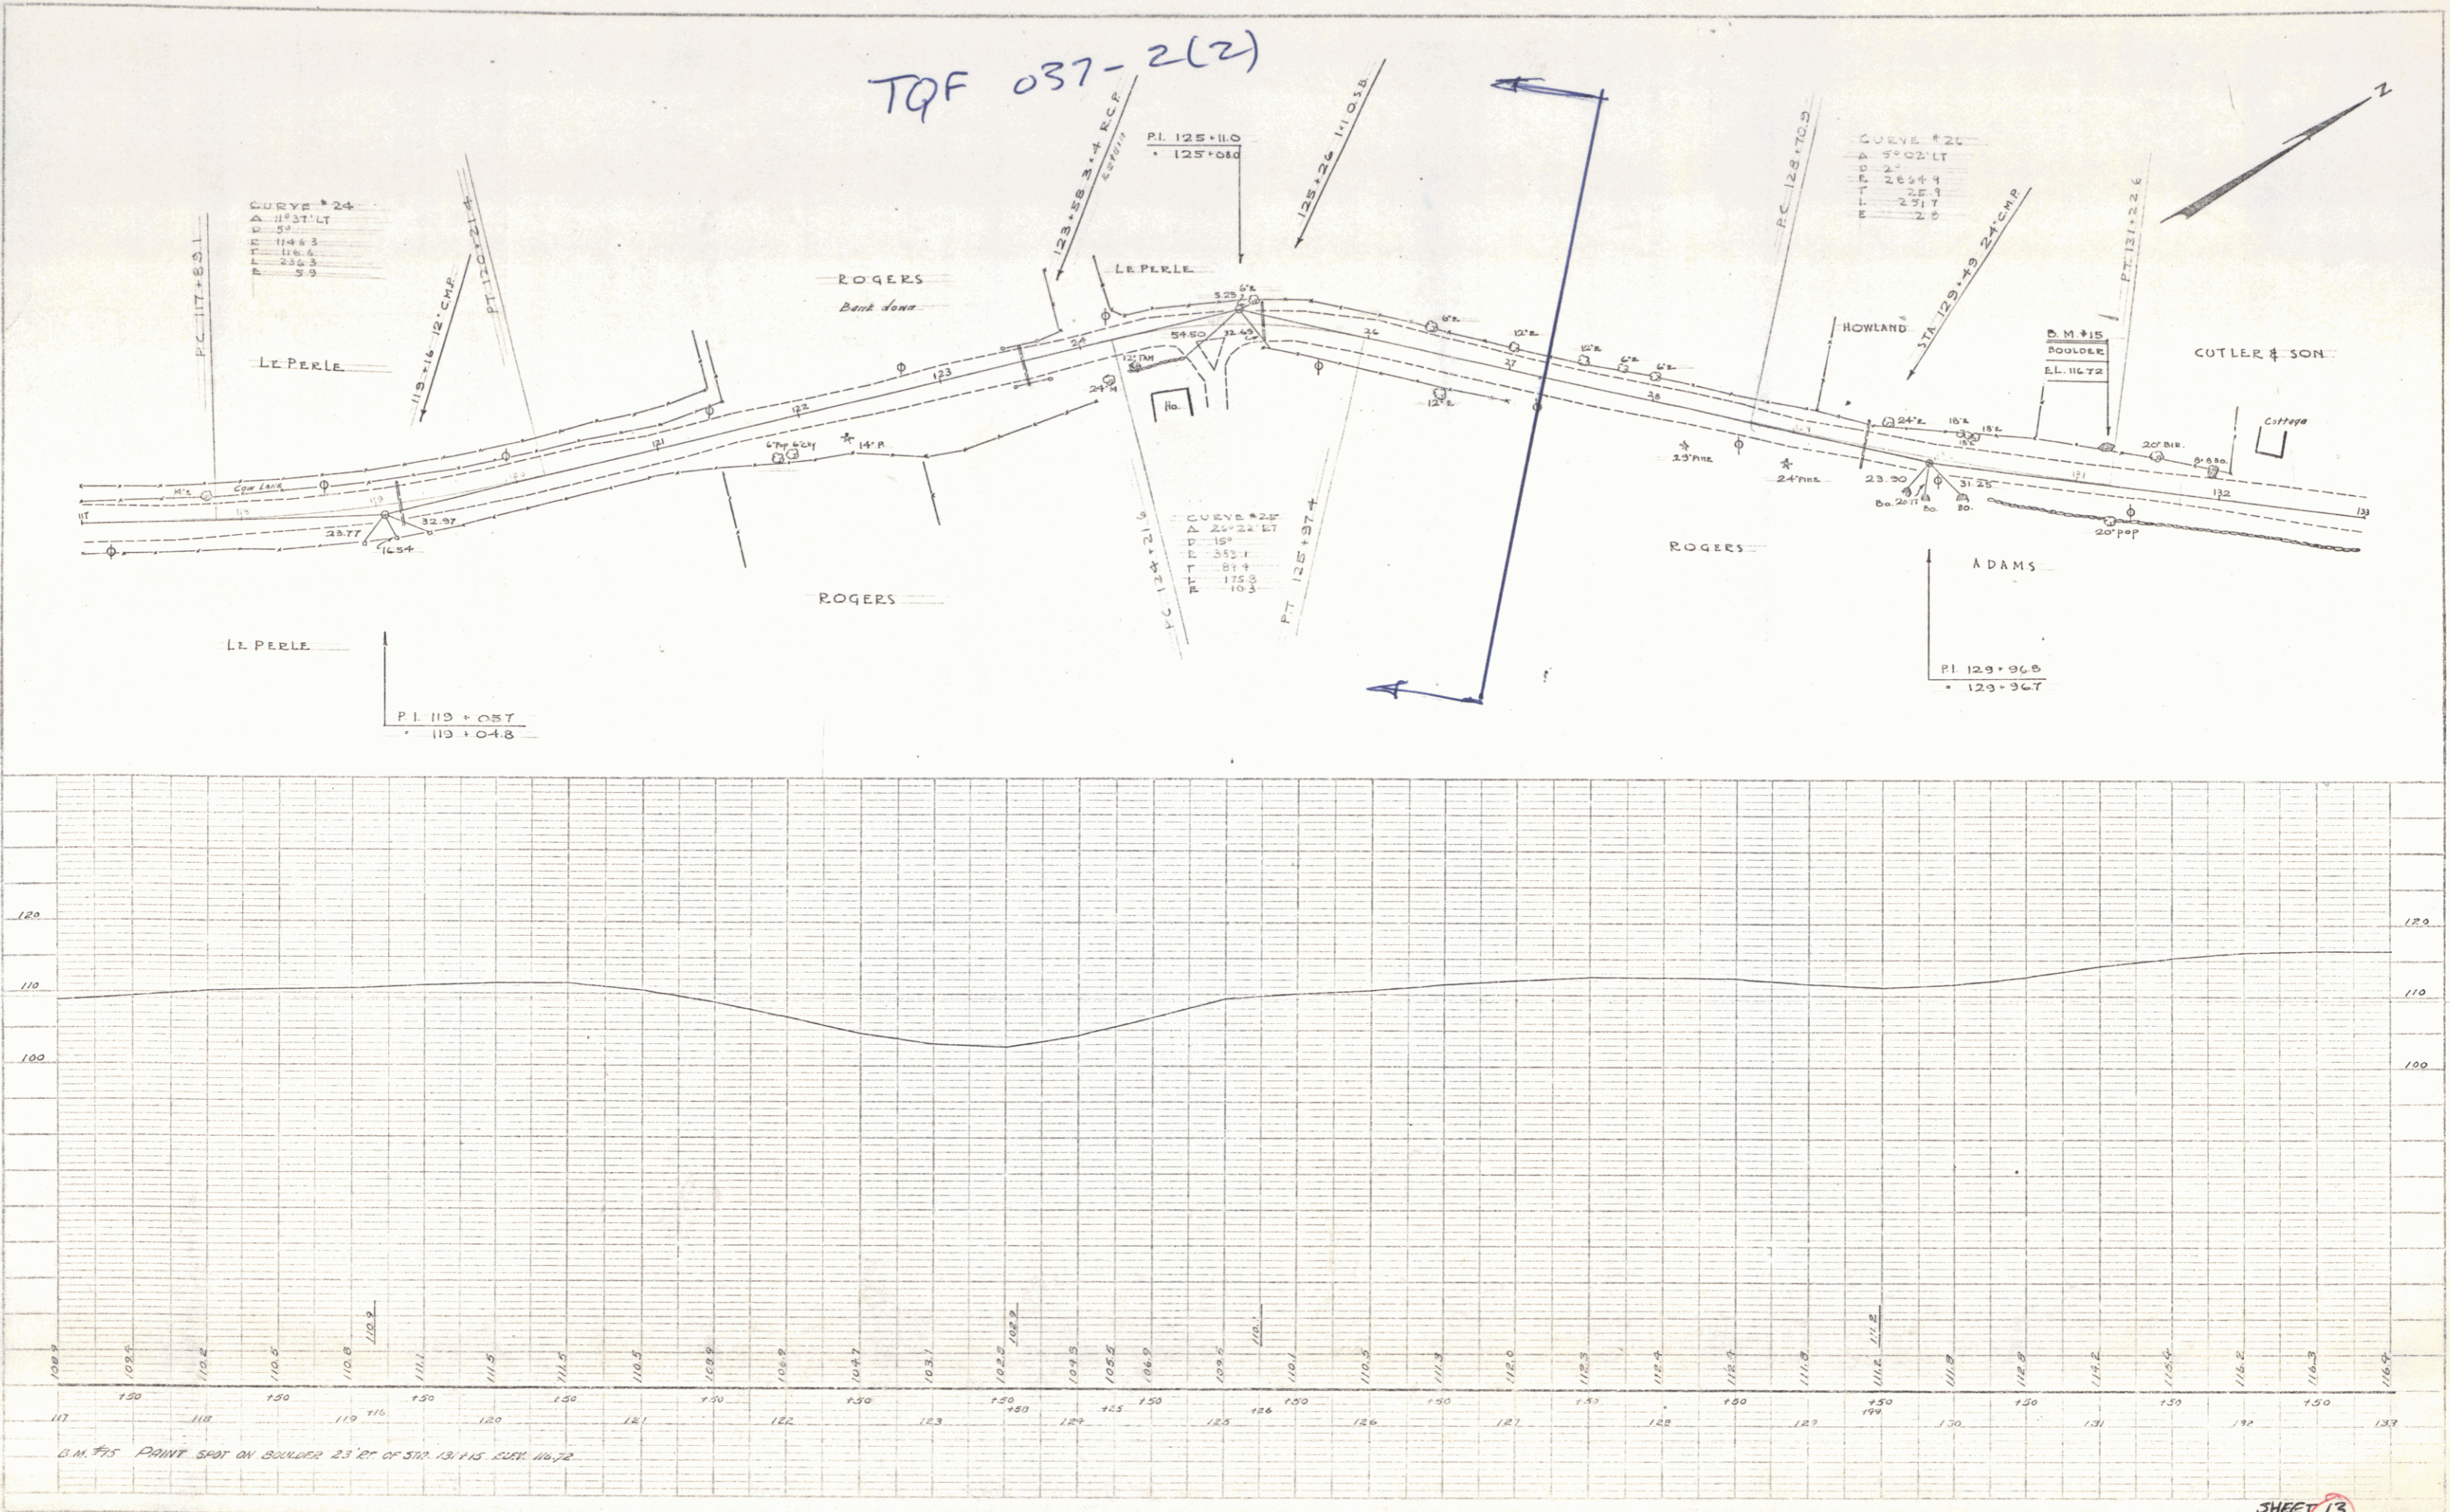



SHEET 13

15