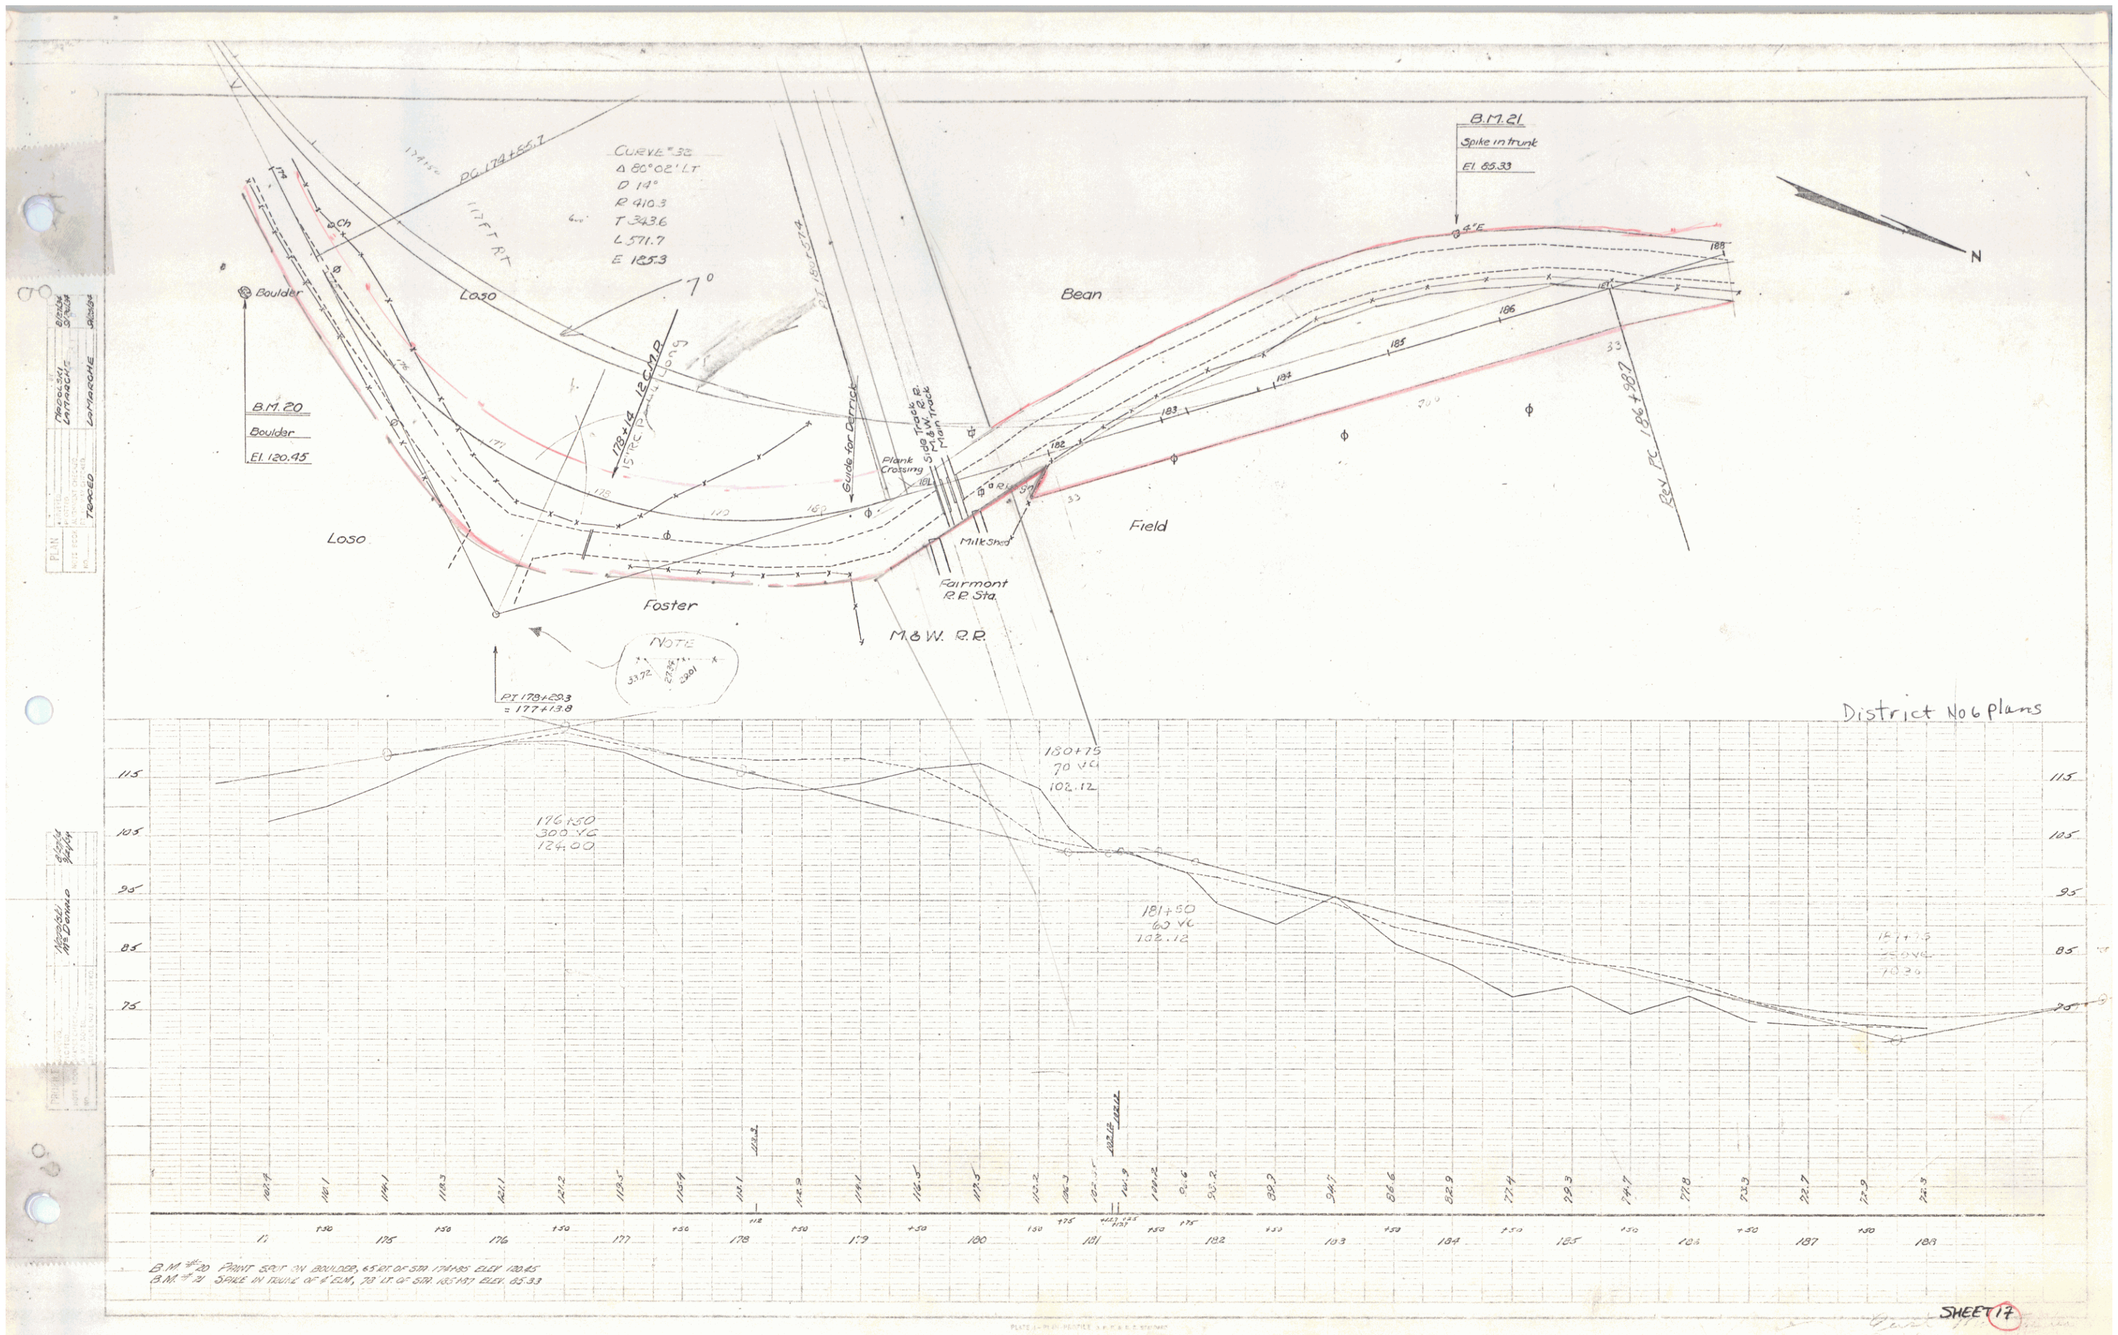
CURVE #32
Δ 80°02' LT
D 14°
R 410.3
T 343.6
L 571.7
E 125.3
PG 174+66.7
137 FT RT
7°
Boulder
B.M. 20
Boulder
El. 120.45
Loso
Loso
Foster
Bean
Field
178+14 12 CMP
Guide for Patrick
Plank Crossing
S.P. Track
M.&W. R.R.
Main Track
Milk Shed
Fairmont
R.R. Sta.
M.&W. R.R.
B.M. 21
Spike in trunk
El. 85.33
N
NOTE
PT 178+293
= 177+13.8
Rev PC 186+98.7
District No 6 plans
176+50
300 VC
124.00
180+75
70 VC
102.12
181+50
60 VC
102.12
B.M. #20 PAINT SPOT ON BOULDER, 65 RT OF STA 174+85 ELEV 120.45
B.M. #21 SPIKE IN TRUNK OF 8" ELM, 70' LT. OF STA. 185+97 ELEV. 85.33

SHEET 17

19