


PLAN  
 DRAWN BY: NAROLSKI  
 LAMAR, 11/27/54  
 CHECKED BY: D. WACCHI, 3/5/54

Vertical  
 Change  
 4/26/54

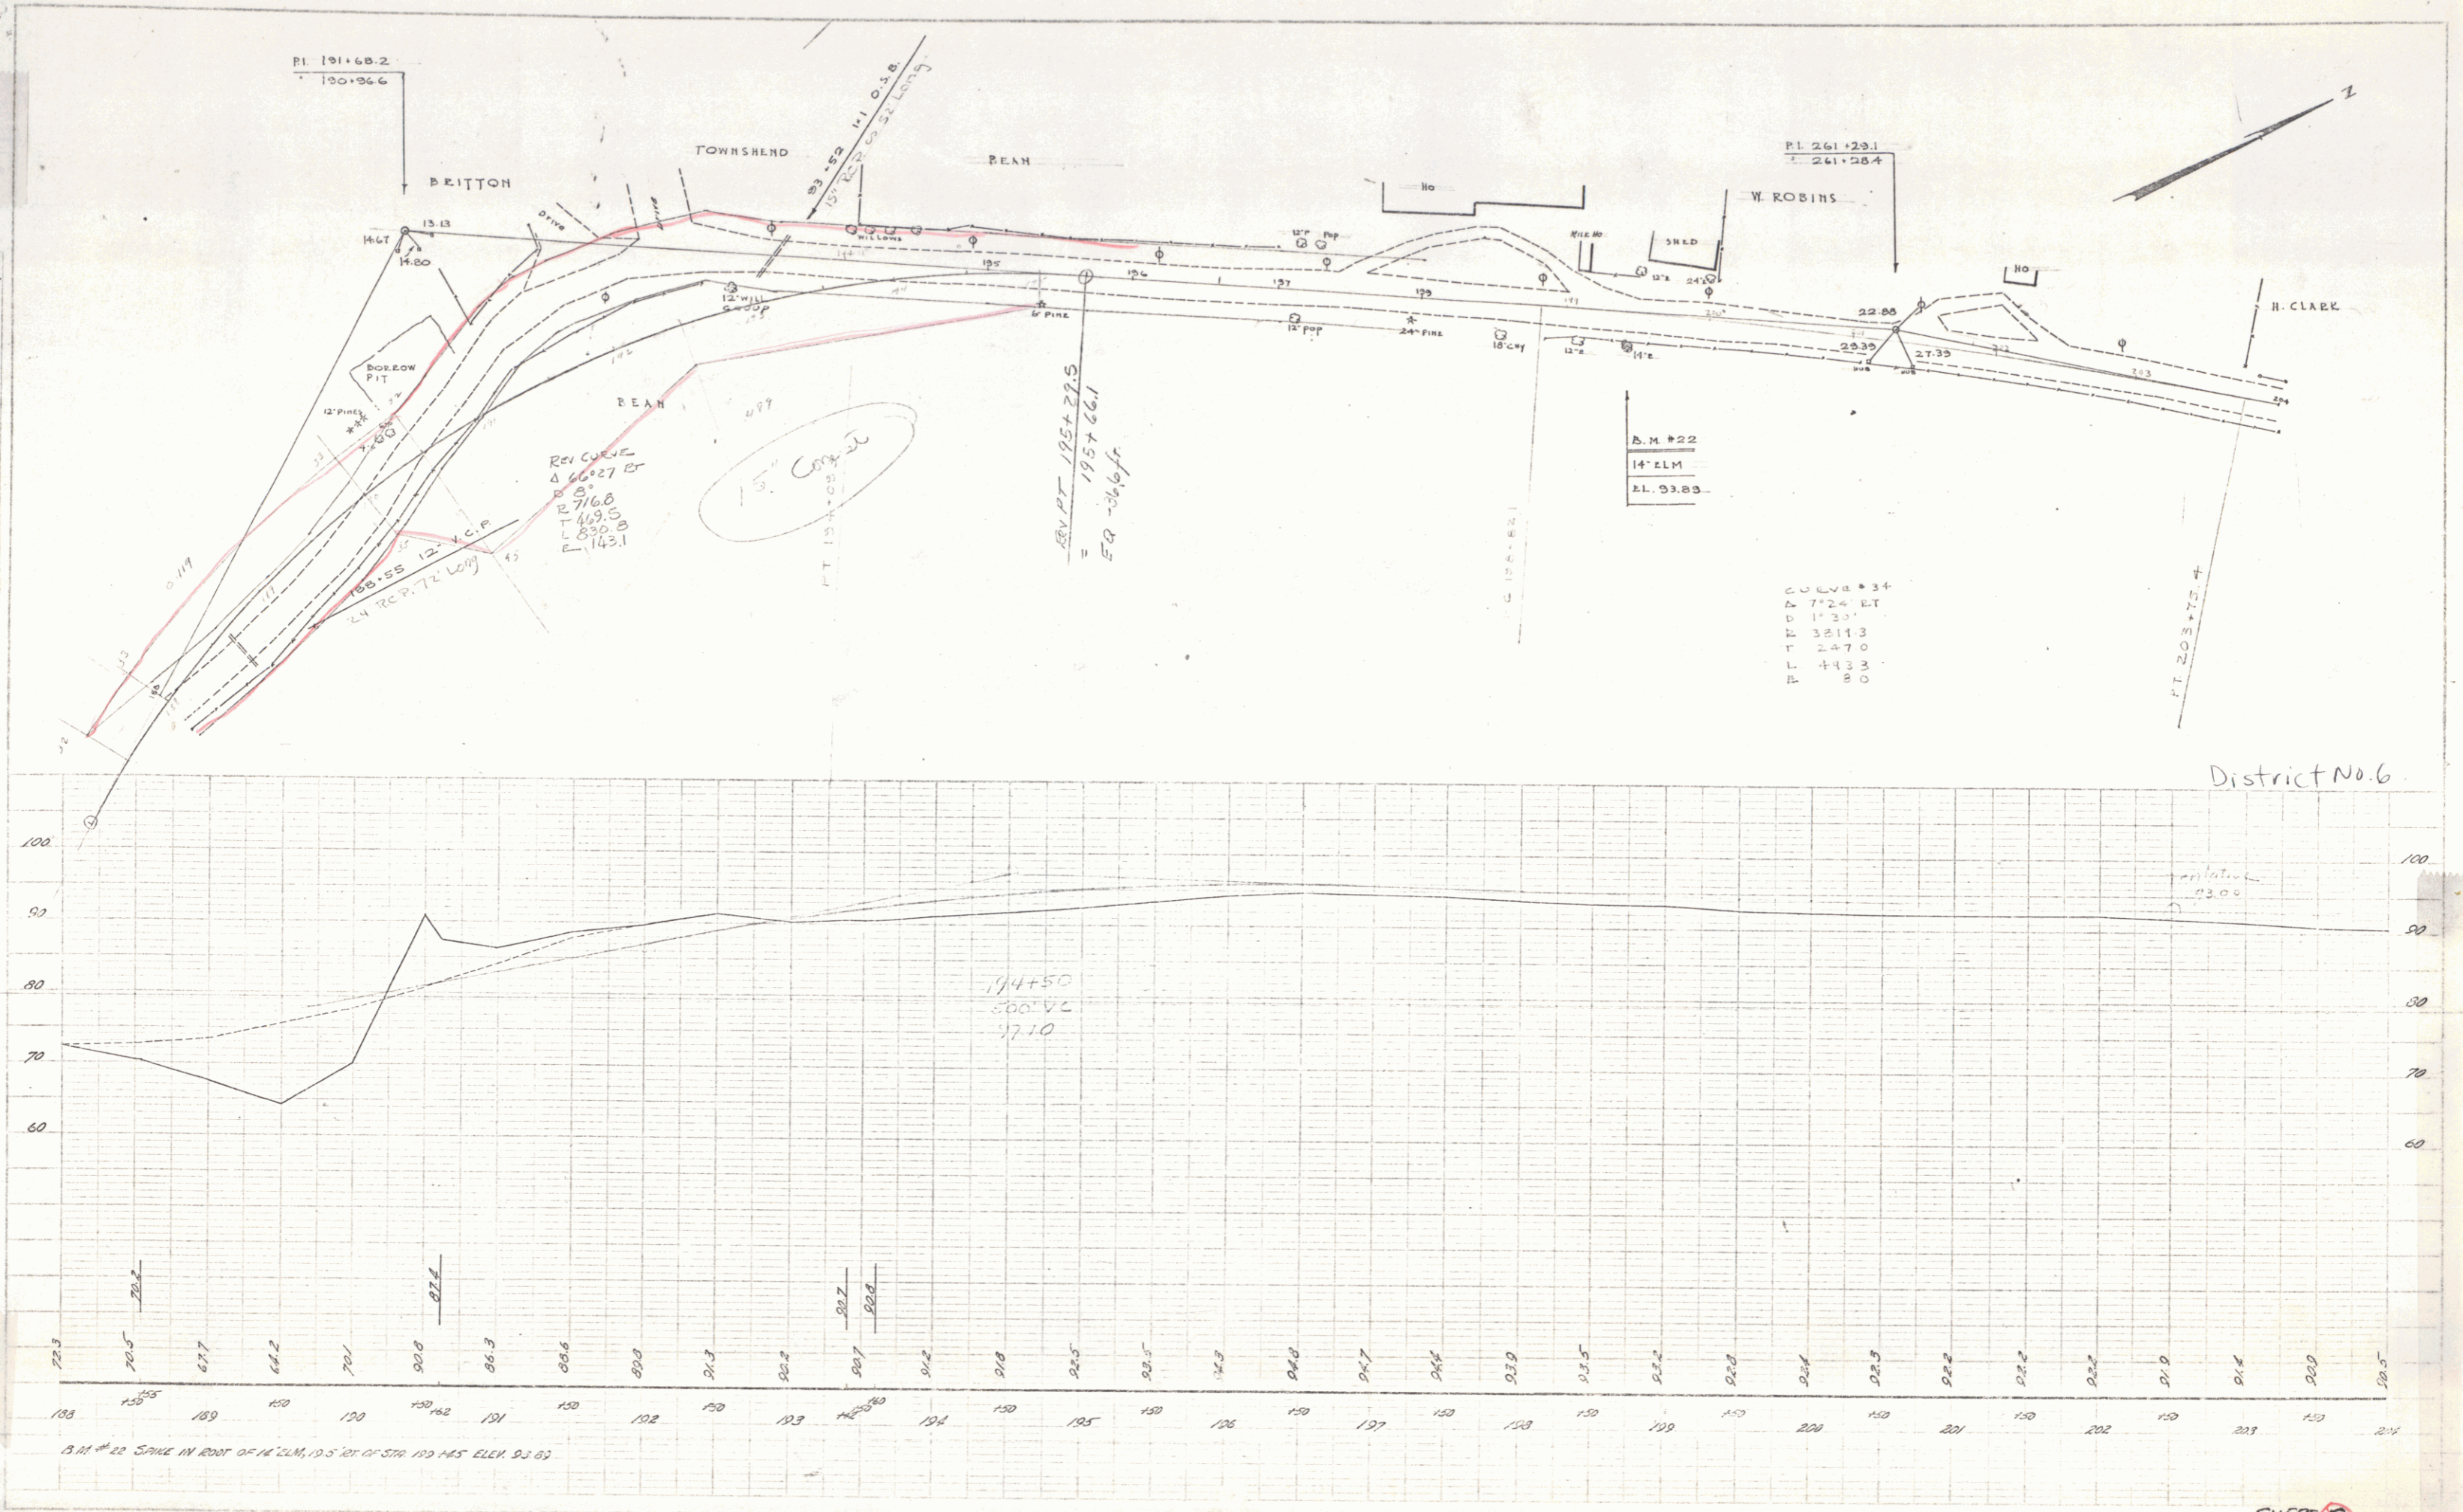

SHEET 18

20