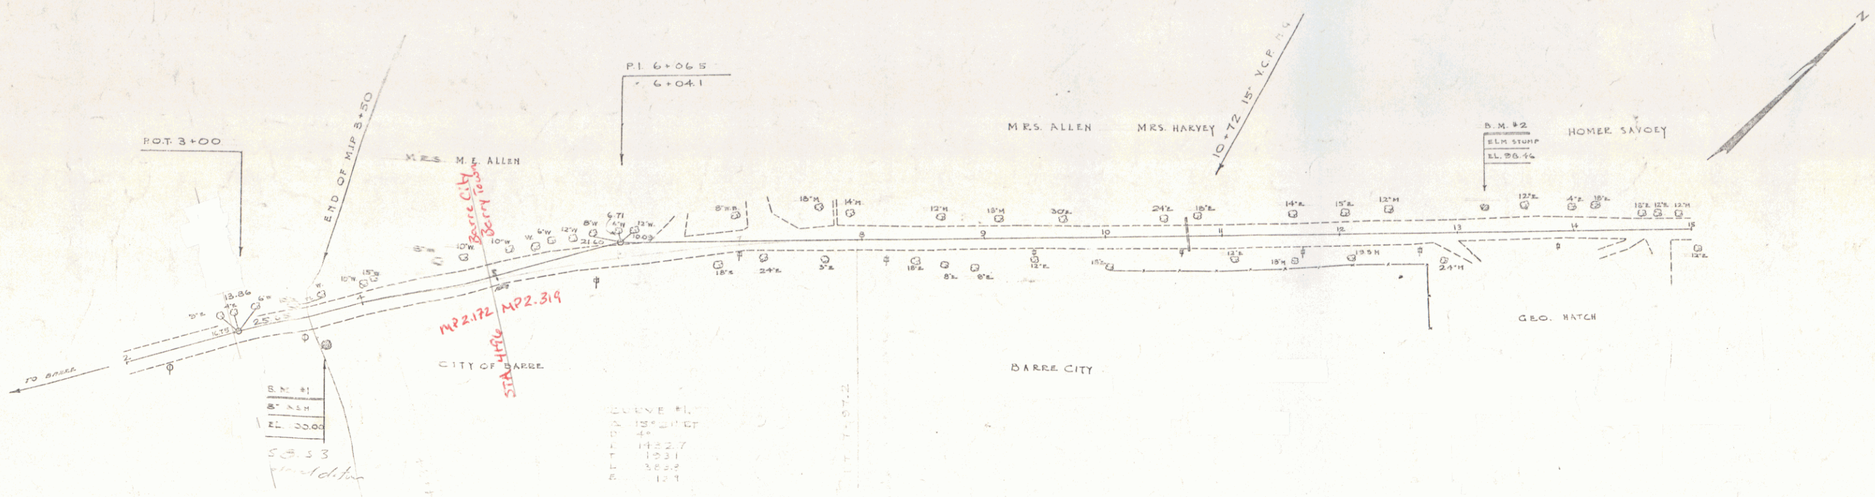

Town: Barre Town
Project No: 181A
Date: 9/1/34
Rte. UT 14
Pin # 00R753
MP 2.319-3.115

RIGHT-OF-WAY DIVISION
TOWN FILE
PERPETUAL
~~Town~~ Rte of UT14
(To Be Returned To R.O.W. Division)

SHEET 1

STEARNS R. JENKINS

UT14 1