NOTE: Fill placed under base over old Road to be of approved Excavation or Borrow, free from clay, silt or clay loam

N.P.S. 144 1933 4 28

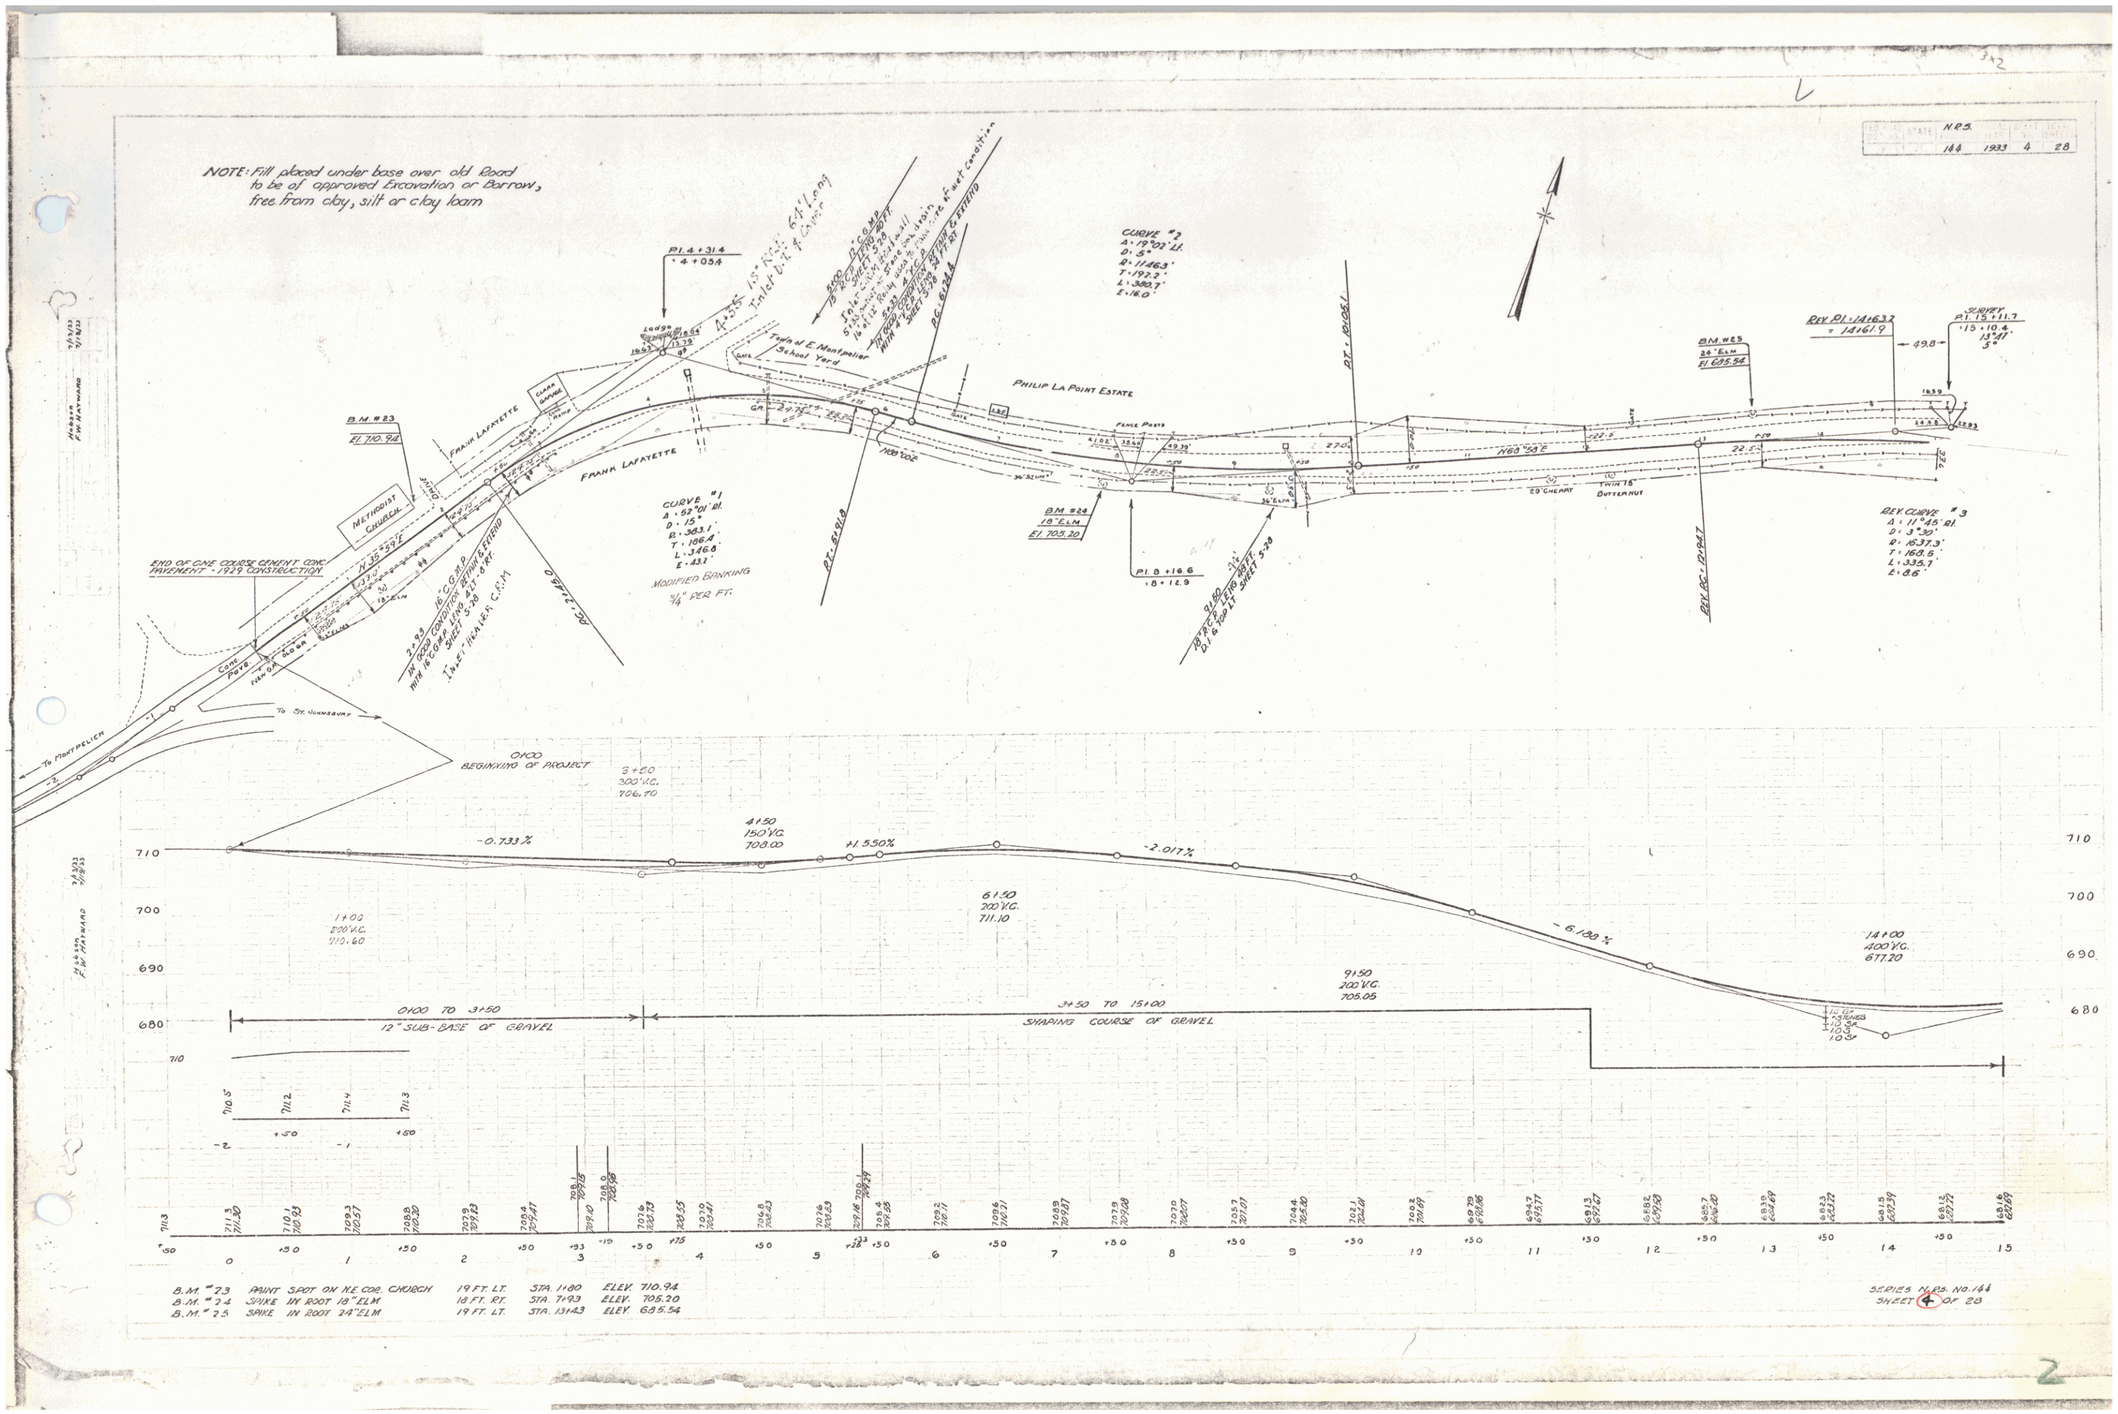

Series N.P.S. No. 144
Sheet 4 of 28