FED. ROAD DIST. NO.	STATE	N.R.S. PROJ. NO.	FISCAL YR.	SHEET NO.	TOTAL SHEETS
3	VT.	144	1933		

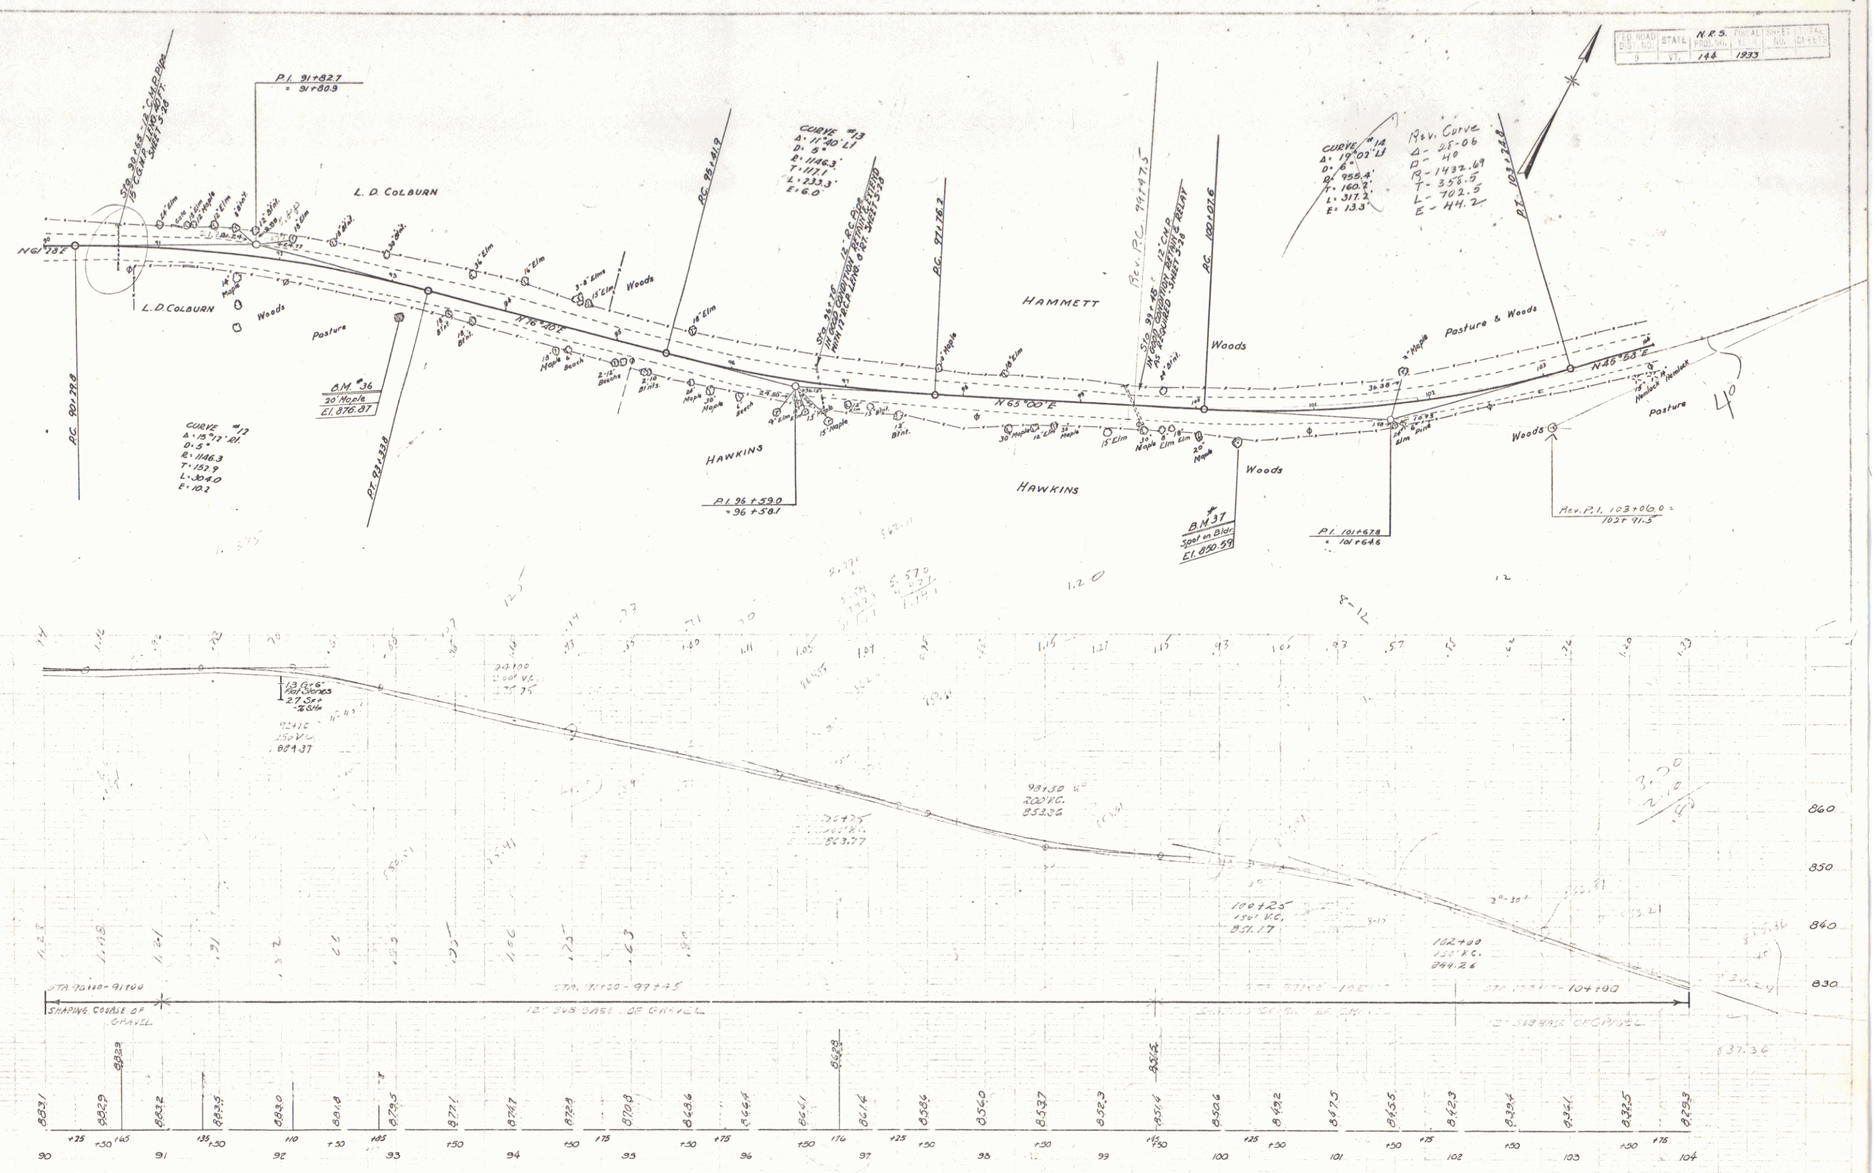

B.M. # 36 SPIKE IN ROOT 20" MAPLE 26 FT. R.T. STA. 93+10 ELEV. 876.87
B.M. # 37 PAINT SPOT ON BOULDER 23.5 FT. R.T. STA. 100+35 ELEV. 850.59

SERIES N.R.S. NO 144
SHEET 16 OF

8