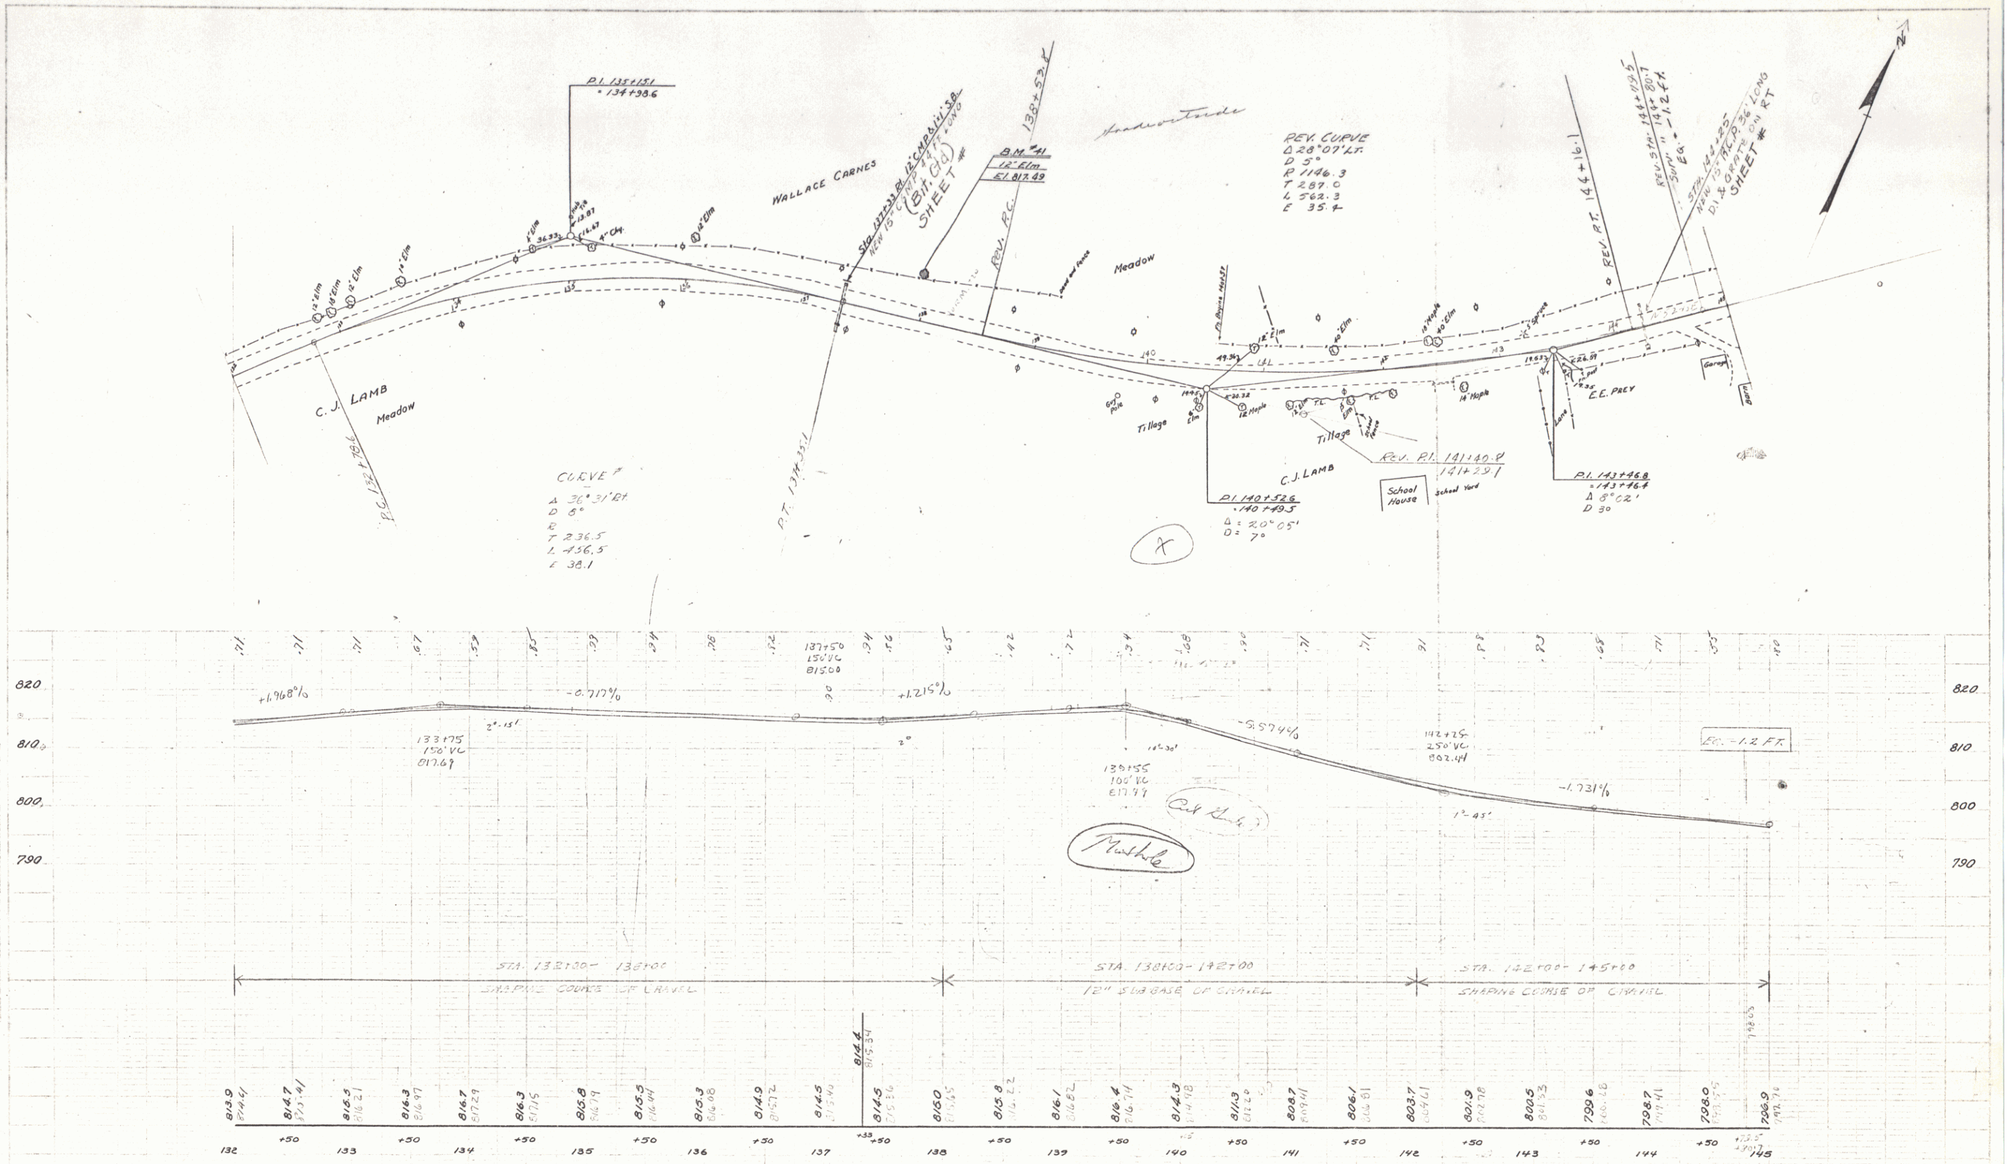

B.M. #41 Spike in root of 12" Elm. 35 Ft. Lt. of Sta. 137+94 Elev. 817.49

SHEET 13