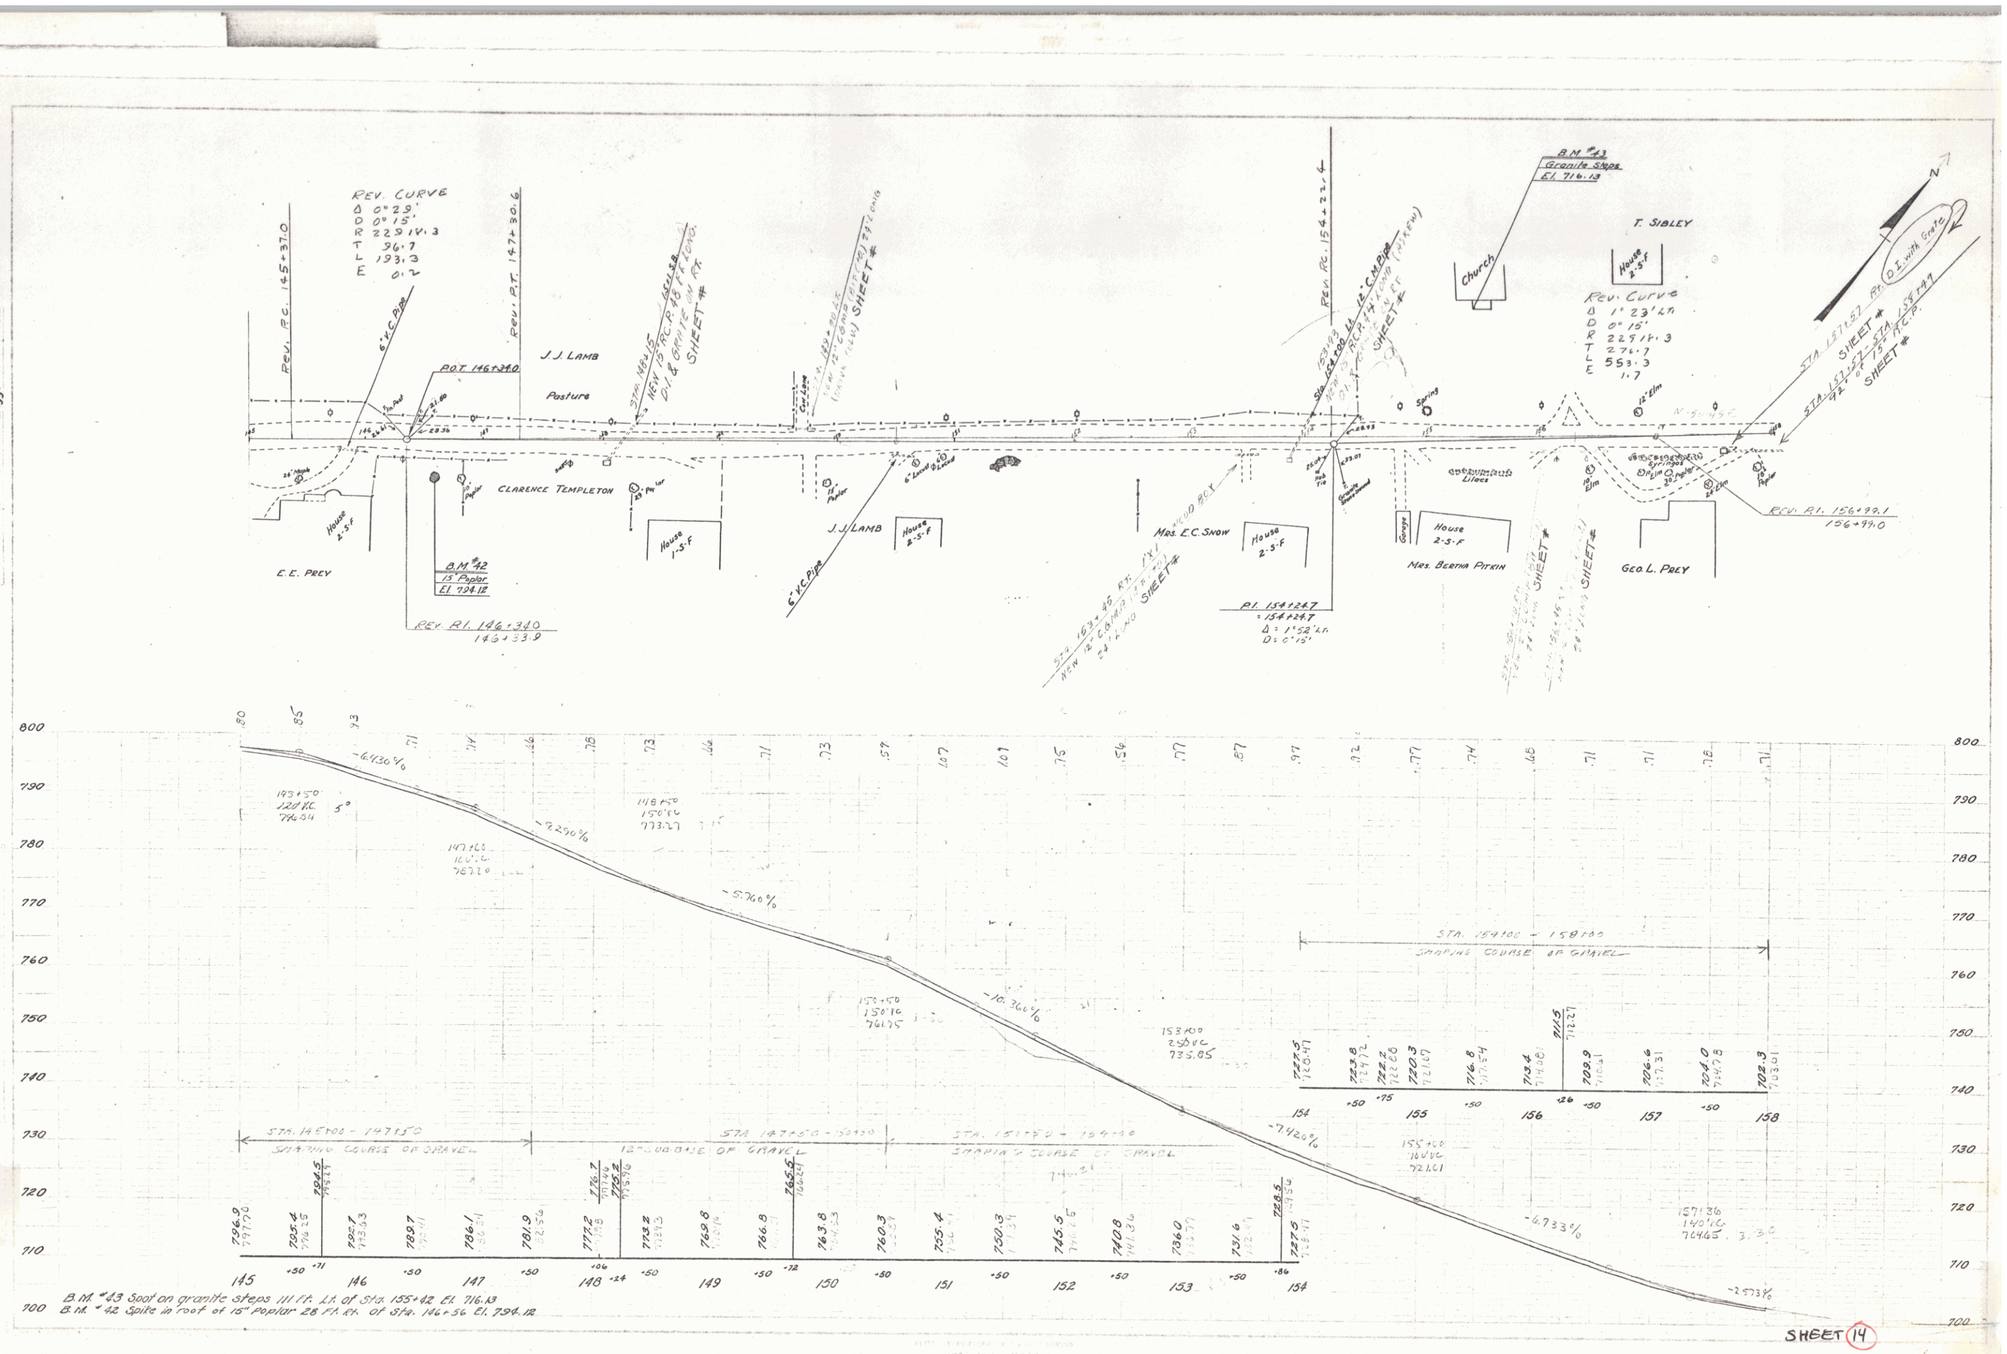
REV. CURVE
Δ 0°29'
D 0°15'
R 229 14.3
T 36.7
L 193.3
E 0.2
REV. P.C. 145+37.0
REV. P.T. 147+30.6
6" V.C. Pipe
P.O.T. 146+34.0
J. J. LAMB
Pasture
CLARENCE TEMPLETON
E. E. PREY
House 2-3-F
House 1-3-F
B.M. #42
15" Poplar
El. 794.12
REV. P.I. 146+34.0
146+33.9
J. J. LAMB
House 2-3-F
6" V.C. Pipe
Mrs. E.C. SNOW
House 2-3-F
P.I. 154+24.7
Δ = 1°52' Lt.
D = 0°15'
Church
B.M. #43
Granite Steps
El. 716.13
T. SIBLEY
House 2-3-F
Rev. Curve
Δ 1°23' Lt.
D 0°15'
R 229 14.3
T 27.7
L 553.3
E 1.7
Garage
House 2-3-F
Mrs. BERTHA PITKIN
GEO. L. PREY
REV. P.I. 156+99.1
156+99.0
N
SHEET 14
STA. 145+00 - 147+50
SHAPING COURSE OF GRAVEL
STA. 147+50 - 150+50
12" SUB-BASE OF GRAVEL
STA. 150+50 - 154+00
SHAPING COURSE OF GRAVEL
STA. 154+00 - 158+00
SHAPING COURSE OF GRAVEL
-6.4130%
-7.2590%
-5.7460%
-10.3660%
-7.4260%
-6.4733%
-2.5733%
B.M. #43 Spot on granite steps 111 ft. Lt. of Sta. 155+42 El. 716.13
B.M. #42 Spike in root of 15" Poplar 28 ft. Rt. of Sta. 146+56 El. 794.12

SHEET 14

12