POOR ORIGINAL COPY

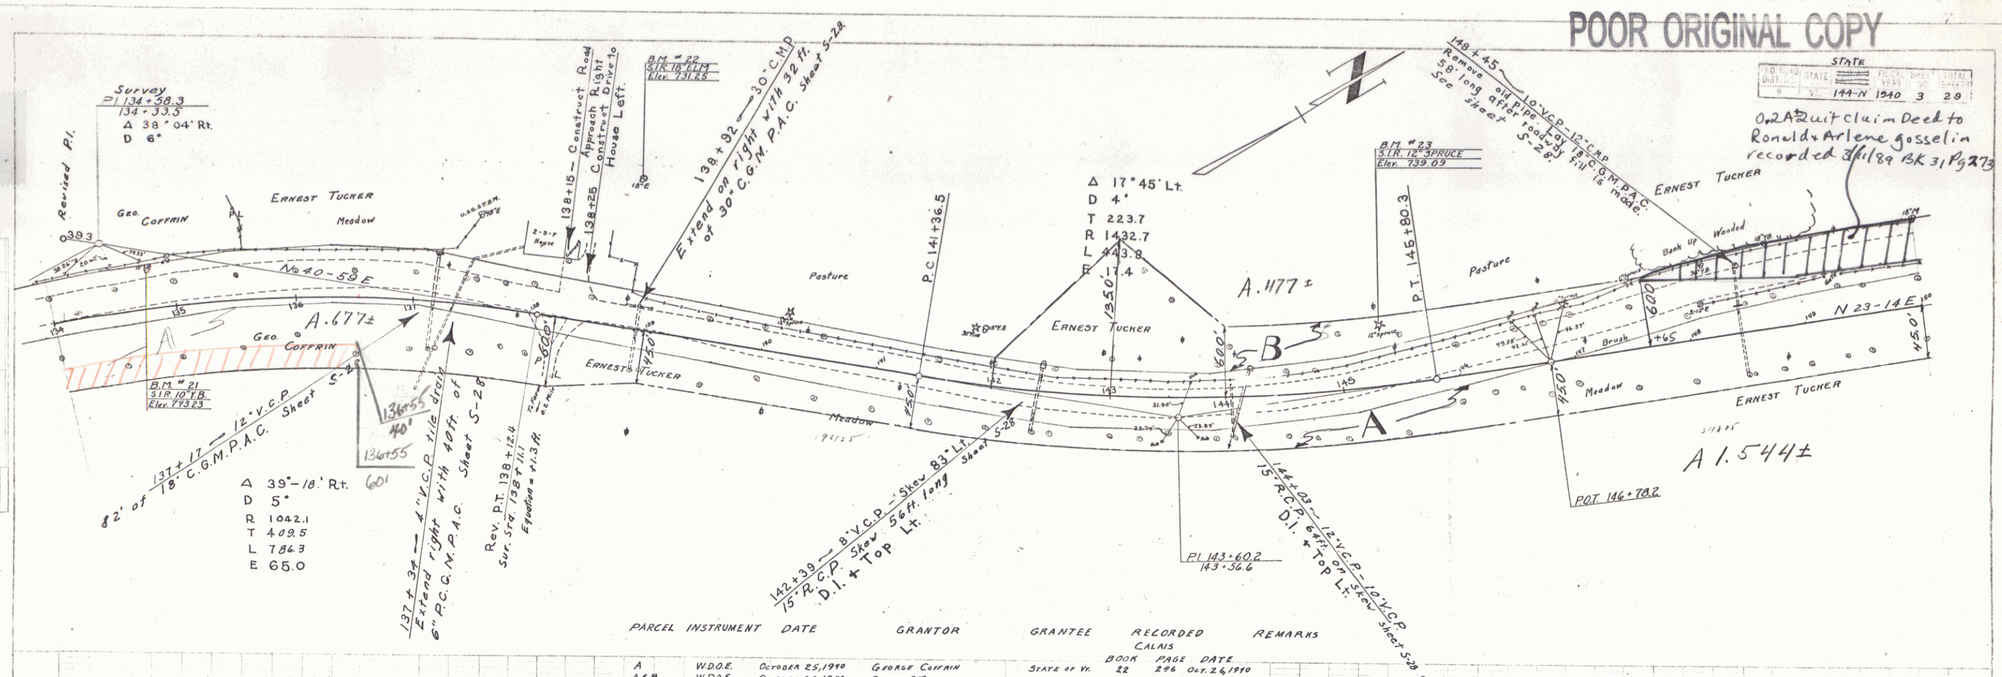

PARCEL	INSTRUMENT	DATE	GRANTOR	GRANTEE	RECORDED CALAIS BOOK	PAGE	DATE	REMARKS
A	W.D.O.E.	October 25, 1940	George Coffin	State of Vt.	22	296	Oct. 26, 1940	
A & B	W.D.O.E.	October 25, 1940	Ernest E. Tucker	State of Vt.	22	292	Oct. 26, 1940	

Sta. 145+0 to 155+0 Top soil and sod to be removed and stock-piled before fills are made; and, after fills are completed, top soil to be spread over fill slopes.

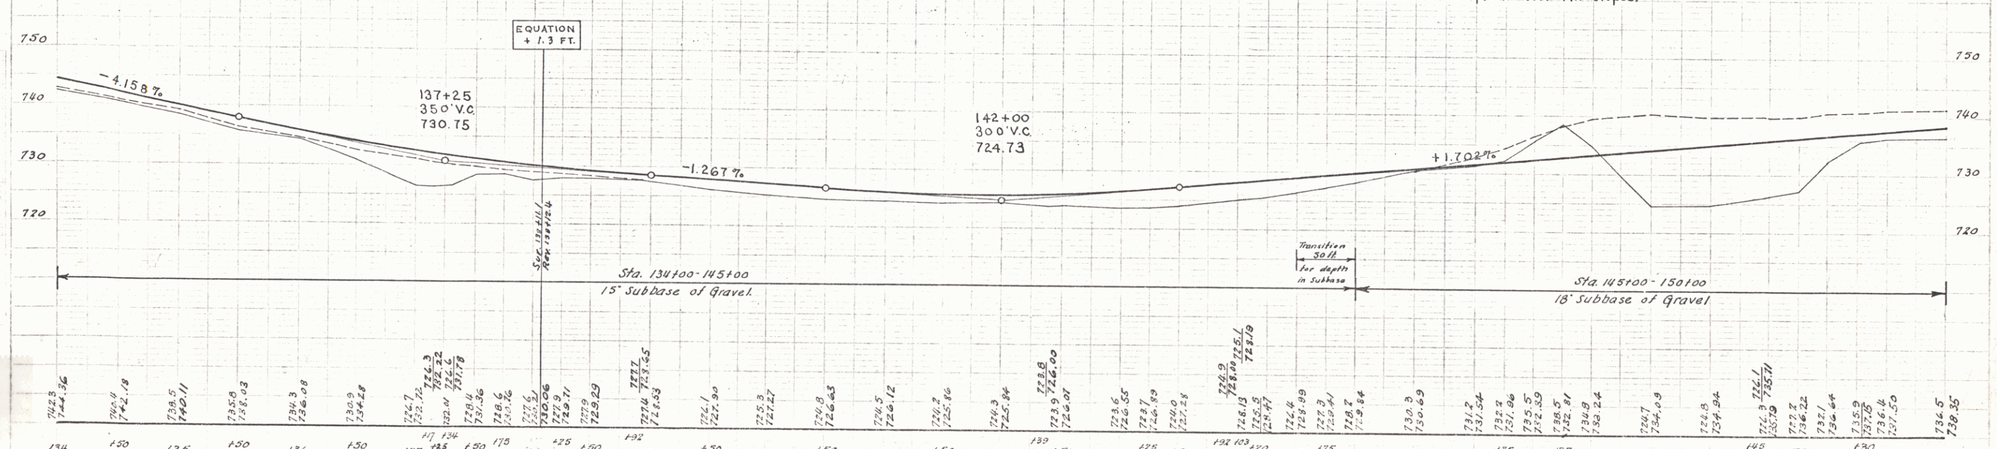

B.M. # 21. S.I.R. 10" Yellow Birch 23.5' Lt. of Sta. 134+78. Elev. 743.23.
B.M. # 22. S.I.R. Twin 18" Elm 126.0' Lt. of Sta. 138+77. Elev. 731.25.
B.M. # 23. S.I.R. 12" Spruce 48.0' Lt. of Sta. 145+37. Elev. 739.09.

SHEET 3 of 29

Calais 144N

3