FED. ROAD DIST. NO.	STATE	PROJ. NO.	FISCAL YEAR	SHEET NO.	TOTAL SHEETS
9	VT.	144(2)	1946	4	83

Note: The contractors attention is called to the existing sewer lines and water pipe lines which are shown on the plans as close to their correct location as it is possible to obtain data.
No work is to be done on the sewer lines or water pipe lines, as part of this contract, unless noted.
From sta 2+00 to sta 4+00 the crown of the surface is to be 3½ inches in 18 feet

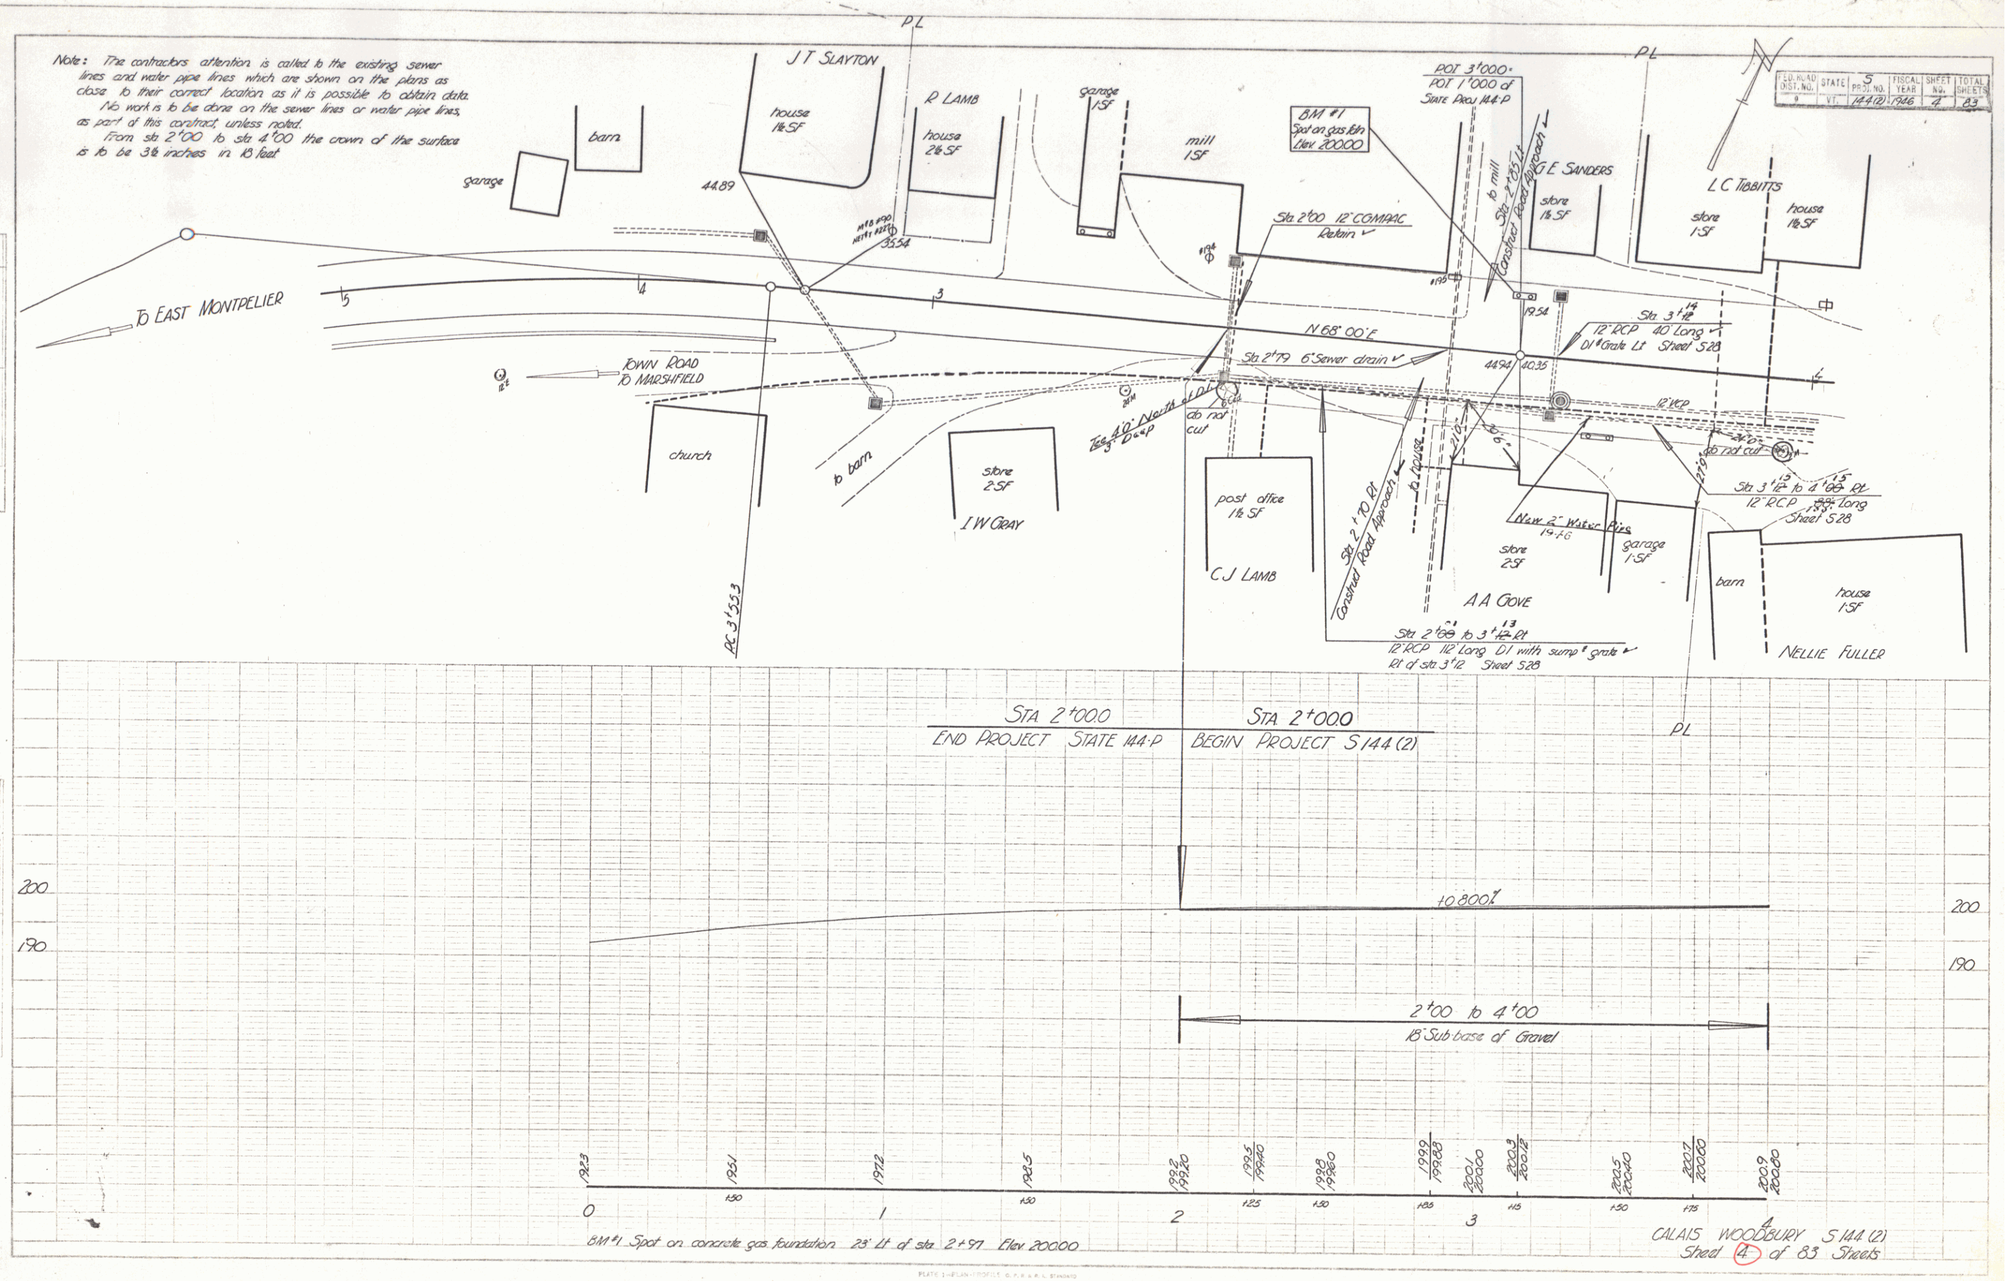

CALAIS WOODBURY S 144 (2)
Sheet 4 of 83 Sheets

2