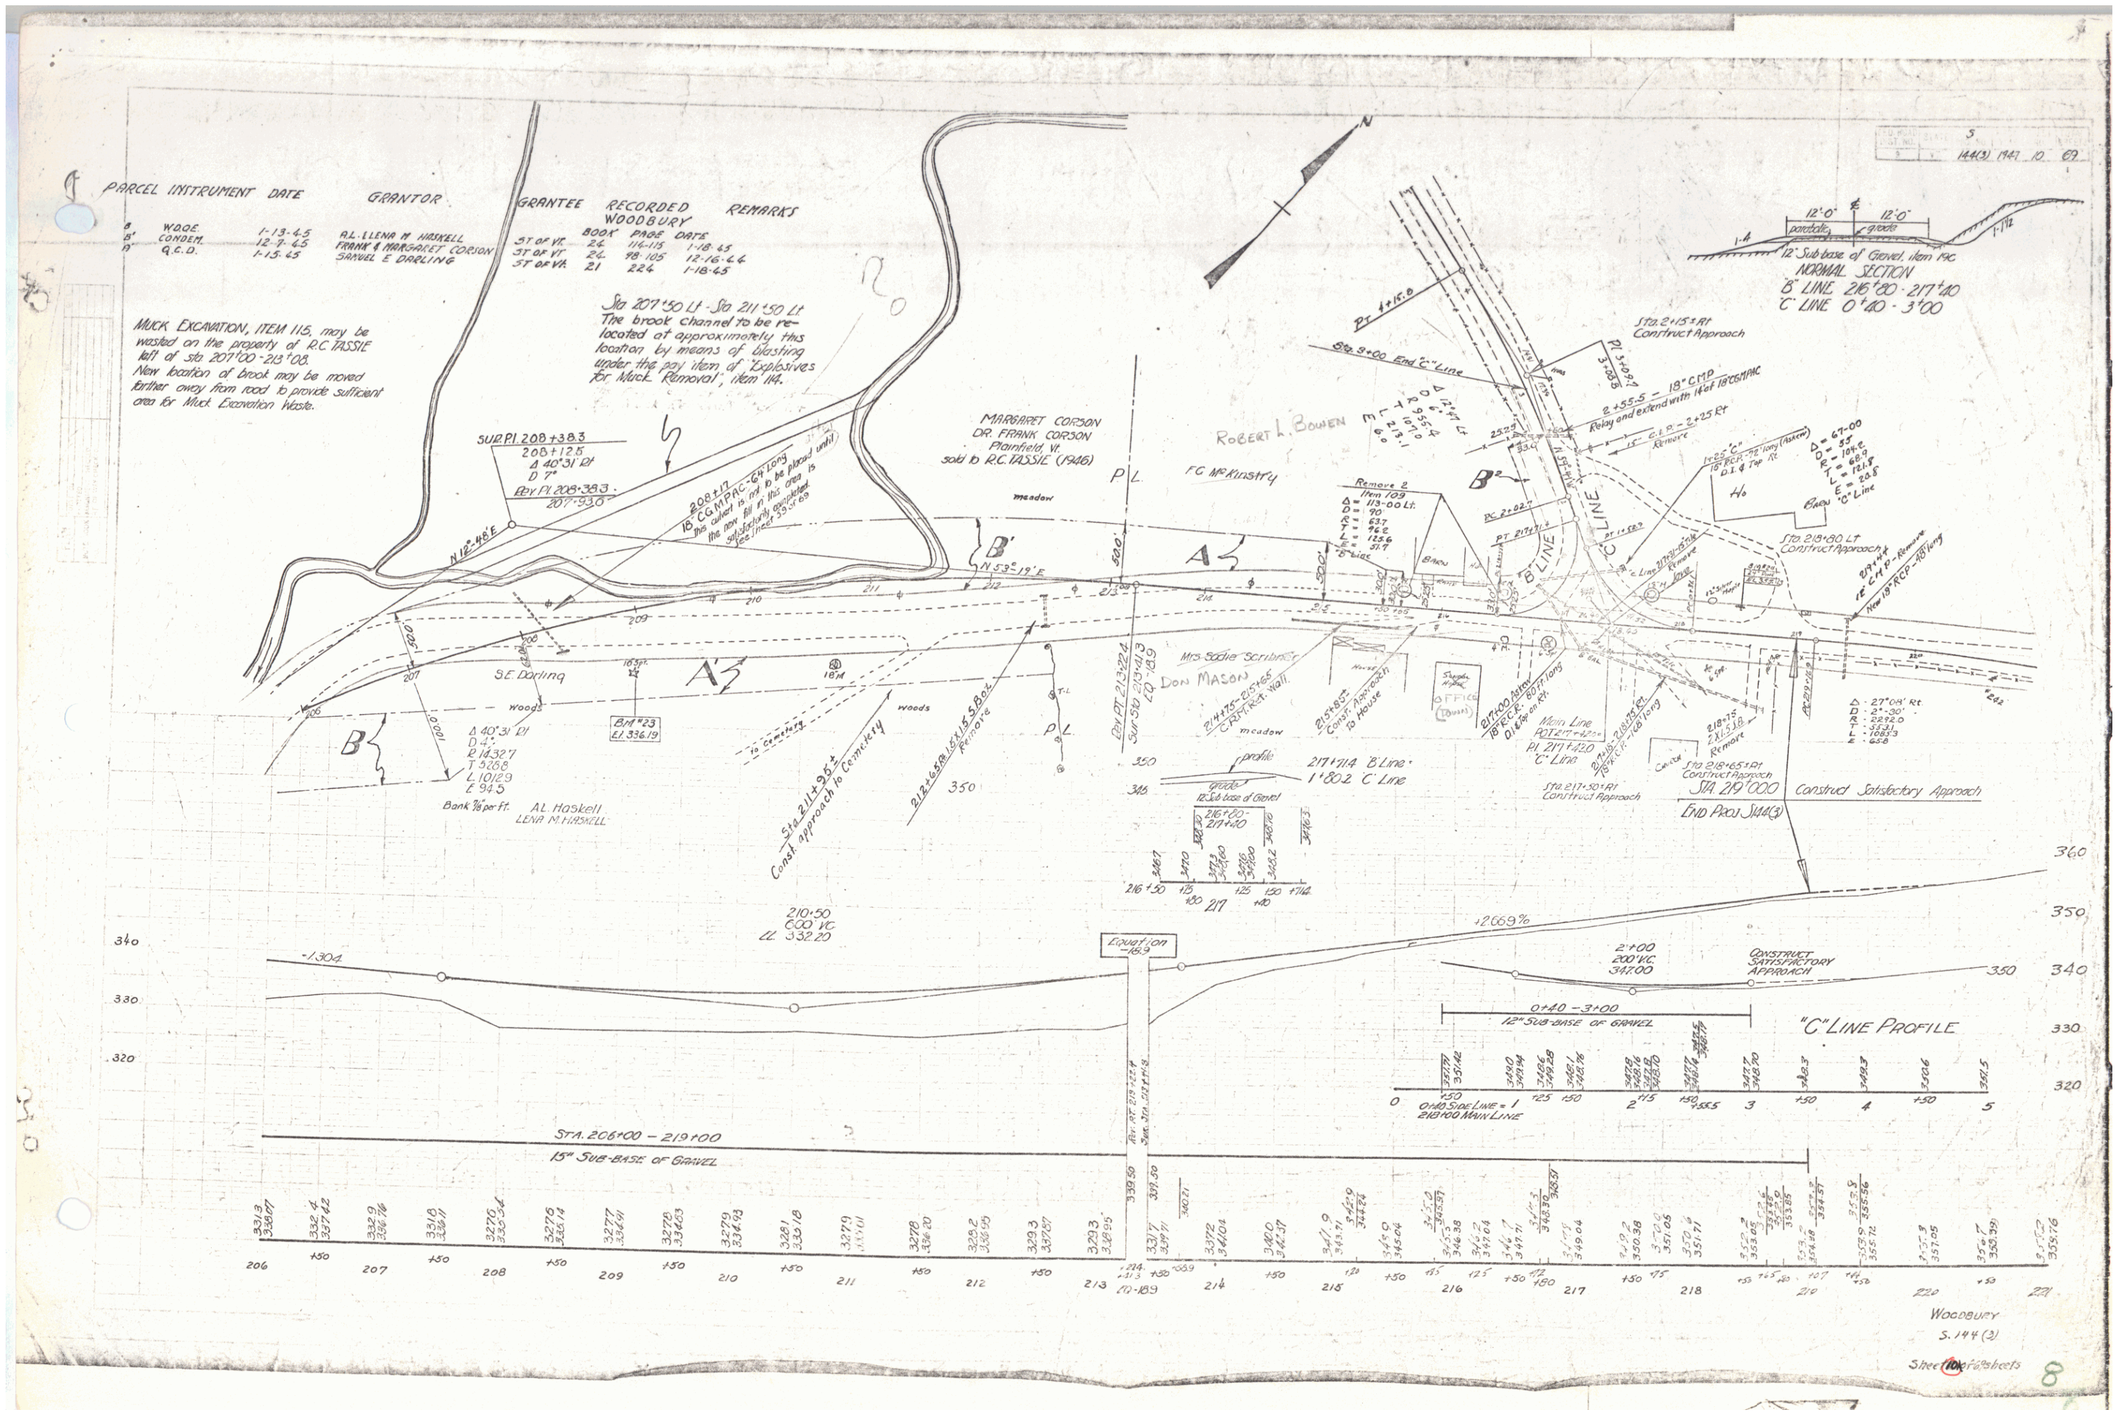
PARCEL INSTRUMENT DATE GRANTOR GRANTEE RECORDED WOODBURY
BOOK PAGE DATE REMARKS
A W.O.E. 1-13-65 A.L. LLENA M. HASKELL ST OF VT. 26 116-115 1-18-65
B' CONDEM. 12-7-65 FRANK & MARGARET CORSON ST OF VT. 24 98-105 12-16-64
B Q.C.D. 1-15-65 SAMUEL E. DARLING ST OF VT. 21 224 1-18-65
MUCK EXCAVATION, ITEM 115, may be wasted on the property of R.C. TASSIE left of Sta 207'00 - 213'08.
New location of brook may be moved further away from road to provide sufficient area for Muck Excavation Waste.
Sta 207'50 Lt - Sta 211'50 Lt
The brook channel to be relocated at approximately this location by means of blasting under the pay item of "Explosives for Muck Removal", item 114.
SUR PI 208+38.3
208+12.5
Δ 40°31' Rt
D 7°
Rev PI 208+38.3
207'+93.0
208+17
18" COMPAC - 64' long
this culvert is not to be placed until the new fill in this area is satisfactorily completed
Elevation 553.0
MARGARET CORSON
DR. FRANK CORSON
Plainfield, Vt.
sold to R.C. TASSIE (1946)
meadow
P.L.
FC McKinstry
ROBERT L. BOWEN
Remove 2
Item 109
Δ = 113-00 Lt.
D = 90
R = 63.7
T = 96.2
L = 125.6
E = 51.9
"B" Line
Barn
Woods
S.E. Darling
BM #23
El. 336.19
Δ 40°31' Rt
D 4°
R 143.27
T 58.66
L 101.29
E 9.45
Bank 7% per ft.
AL Haskell
LENA M. HASKELL
Mrs. Sadie Scribner
DON MASON
Sta. 211+35± Const approach to Cemetery
to Cemetery
Sta. 212+58 Remove
Rev PI 213+24
Sur Sta 213+41.3
LD 189
profile
grade
12" Sub base of Gravel
216+80 - 217+40
216+50 +15 +50 +125 +150 +140 217
217+114 "B" Line = 1'80.2 "C" Line
210+50
CCO' VC
EL 332.20
Equation -18.9
-1.304
+2.669%
2'+00
200' VC
347.00
CONSTRUCT SATISFACTORY APPROACH
0+40 - 3+00
12" SUB-BASE OF GRAVEL
"C" LINE PROFILE
0 +50 +25 150 2 +15 +50 +25.5 3 +50 4 +50 5
0+40 Side Line = 1
218+00 Main Line
STA. 206+00 - 219+00
15" SUB-BASE OF GRAVEL
206 +50 207 +50 208 +50 209 +50 210 +50 211 +50 212 +50 213 +50 214 +50 215 +50 216 +50 217 +50 218 +50 219 220 +50 221
Rev. PI 219+22.4
Sur. Sta. 219+19.8
Elevation 553.76
Woodburn
S. 144(3)
Sheet 10 of 10 sheets
8