


NON-GOV'T.  
 440+90 - Excavation for proposed  
 water pipe sleeve, Item 103.  
 Sleeve to be furnished by the property owner.

NON-GOV'T.  
 449+00 - Excavation for proposed  
 water pipe sleeve, Item 103.  
 Sleeve to be furnished by the property owner.

PARCEL INSTRUMENT DATE GRANTOR GRANTEE RECORDED  
 CONSTRUCT DRIVES 735 468 W.D.O.E. 6-24-49 FRANCESCO SMITH ST. OF VT. 24 520 9-18-49  
 441+00 LT  
 444+75 LT  
 451+00 LT & RT  
 441+90 RT

PLAN	2-28
DATE	2-28
BY	ADD
SCALE	1" = 40'

PLAN	2-28
DATE	2-28
BY	ADD
SCALE	1" = 40'

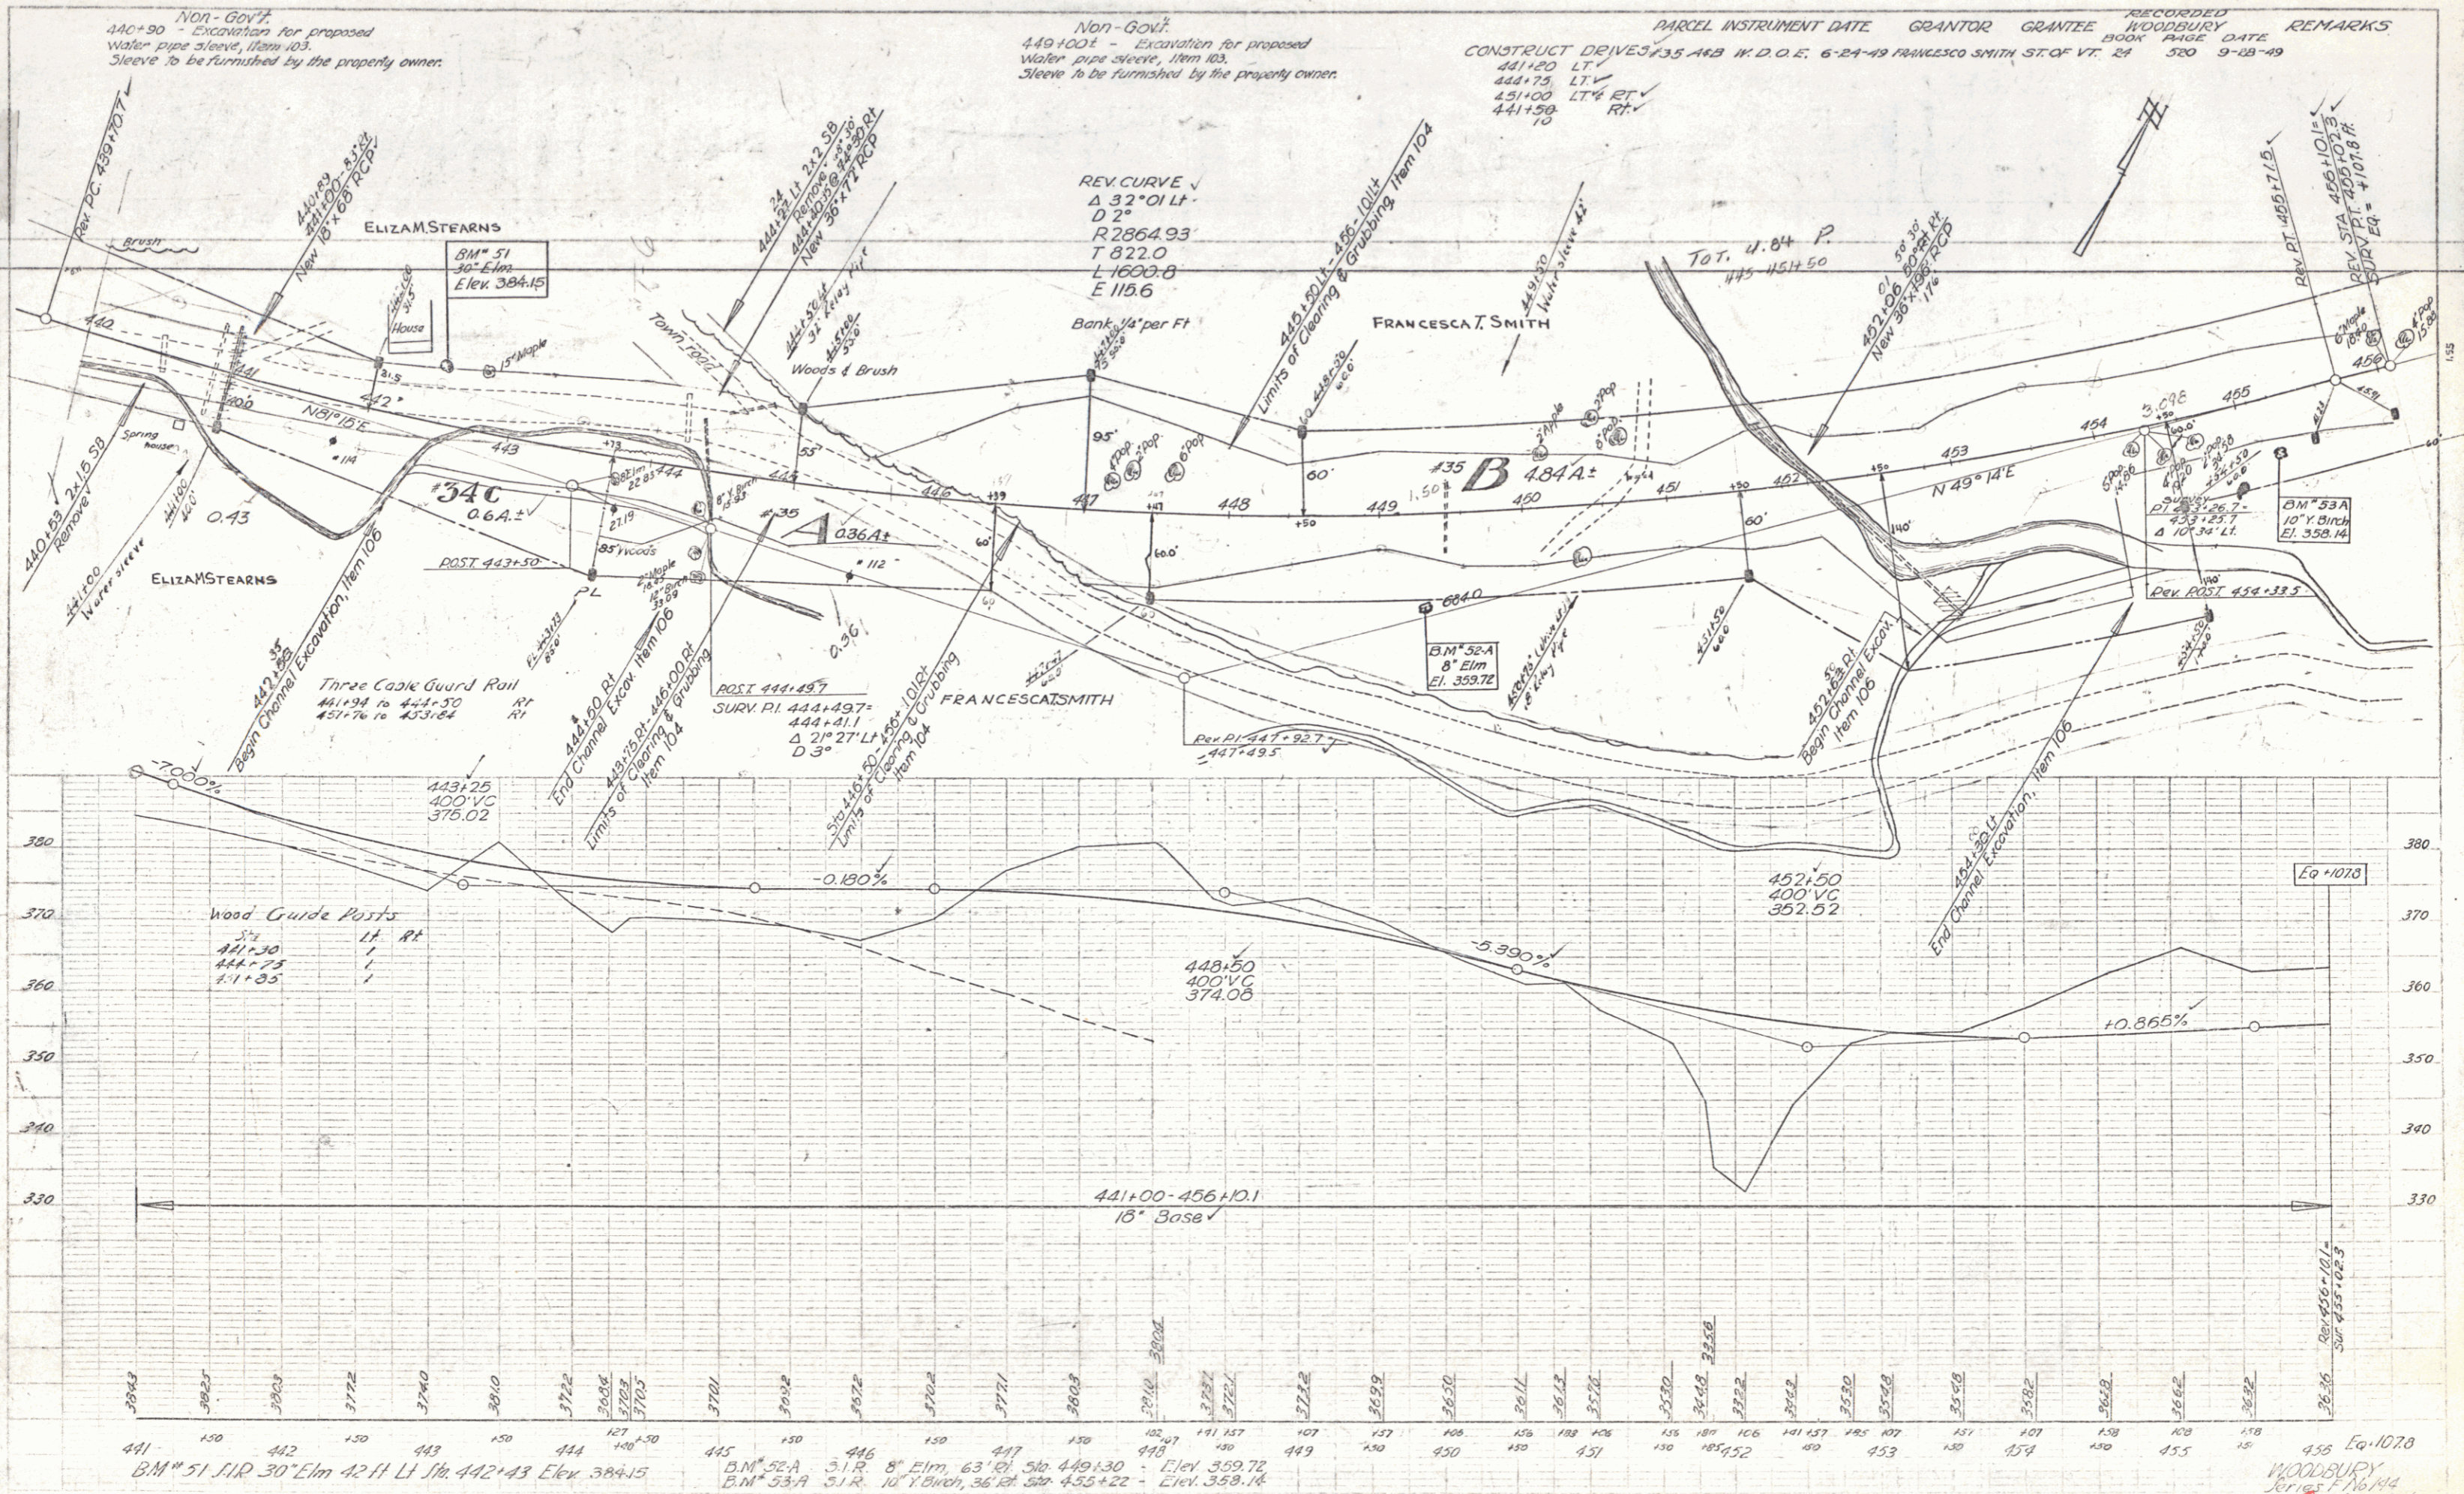

441	150	442	150	443	150	444	127	150	445	150	446	150	447	150	448	102	157	150	449	157	150	450	150	451	150	452	150	453	150	454	150	455	150	456	150
B.M. 51 30' Elm 42' H Lt Sta. 442+43 Elev 384.15										B.M. 52A 5.1 R. 8' Elm 63' H Sta. 449+30 Elev 359.72										B.M. 53A 5.1 R. 10' Y Birch, 36' H Sta. 455+22 Elev 359.14															

456 Eq. 107.0  
 WOODBURY  
 Series F-16144  
 Sheet 55 of 206 Sheets