F.A. ROAD	STATE		FISCAL SHEET	TOTAL
DIS.	RTE.	5		
9	VT.	8(2)	1947 12	47

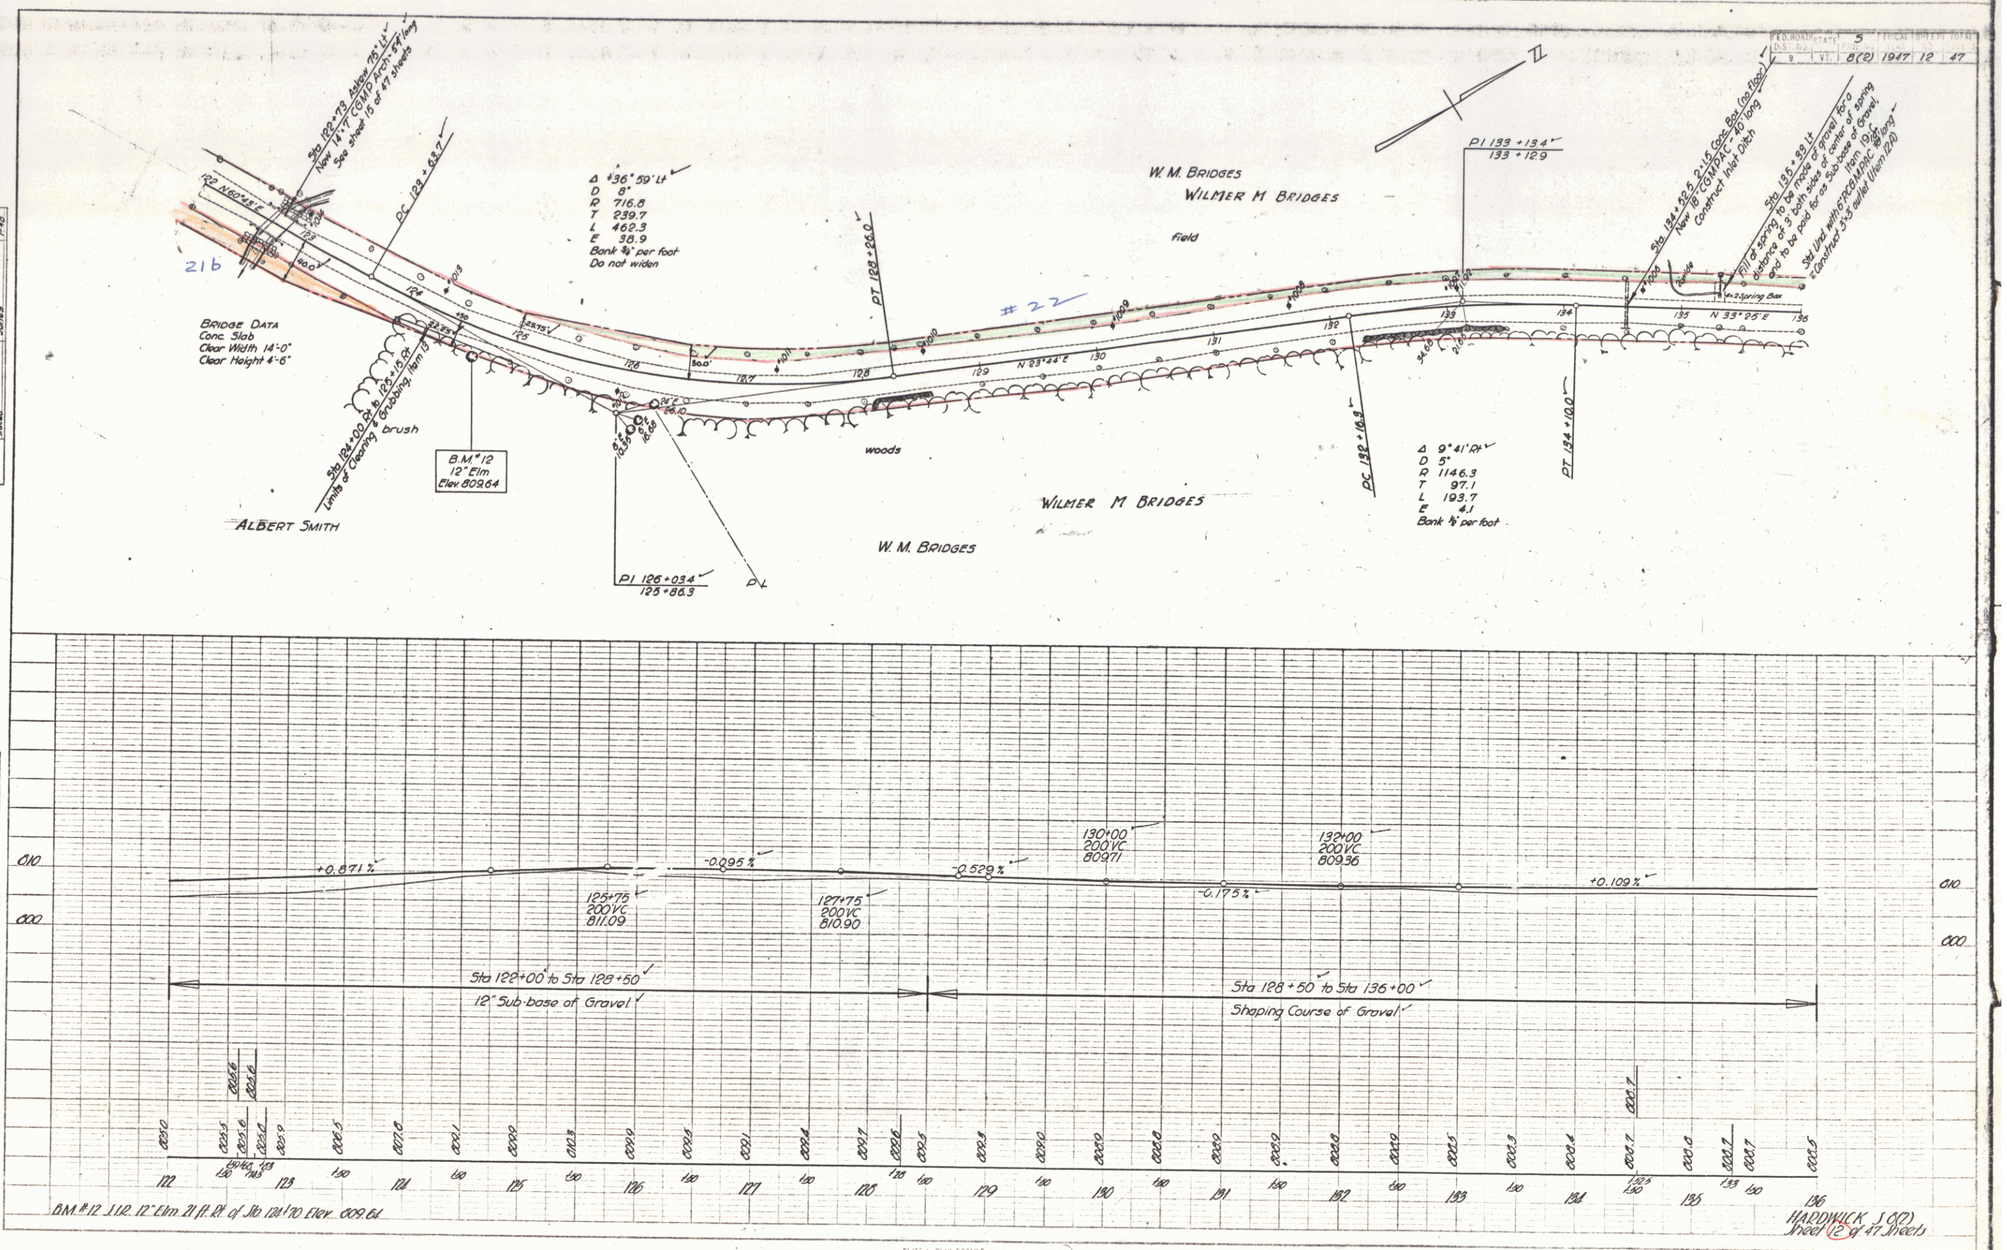

PLATE 1 - PLAN-PROFILE C.P.R. & P.R. STANDARD
NEWTEL & EDER CO. NEW YORK
K & E CO. No. 346-10

12