
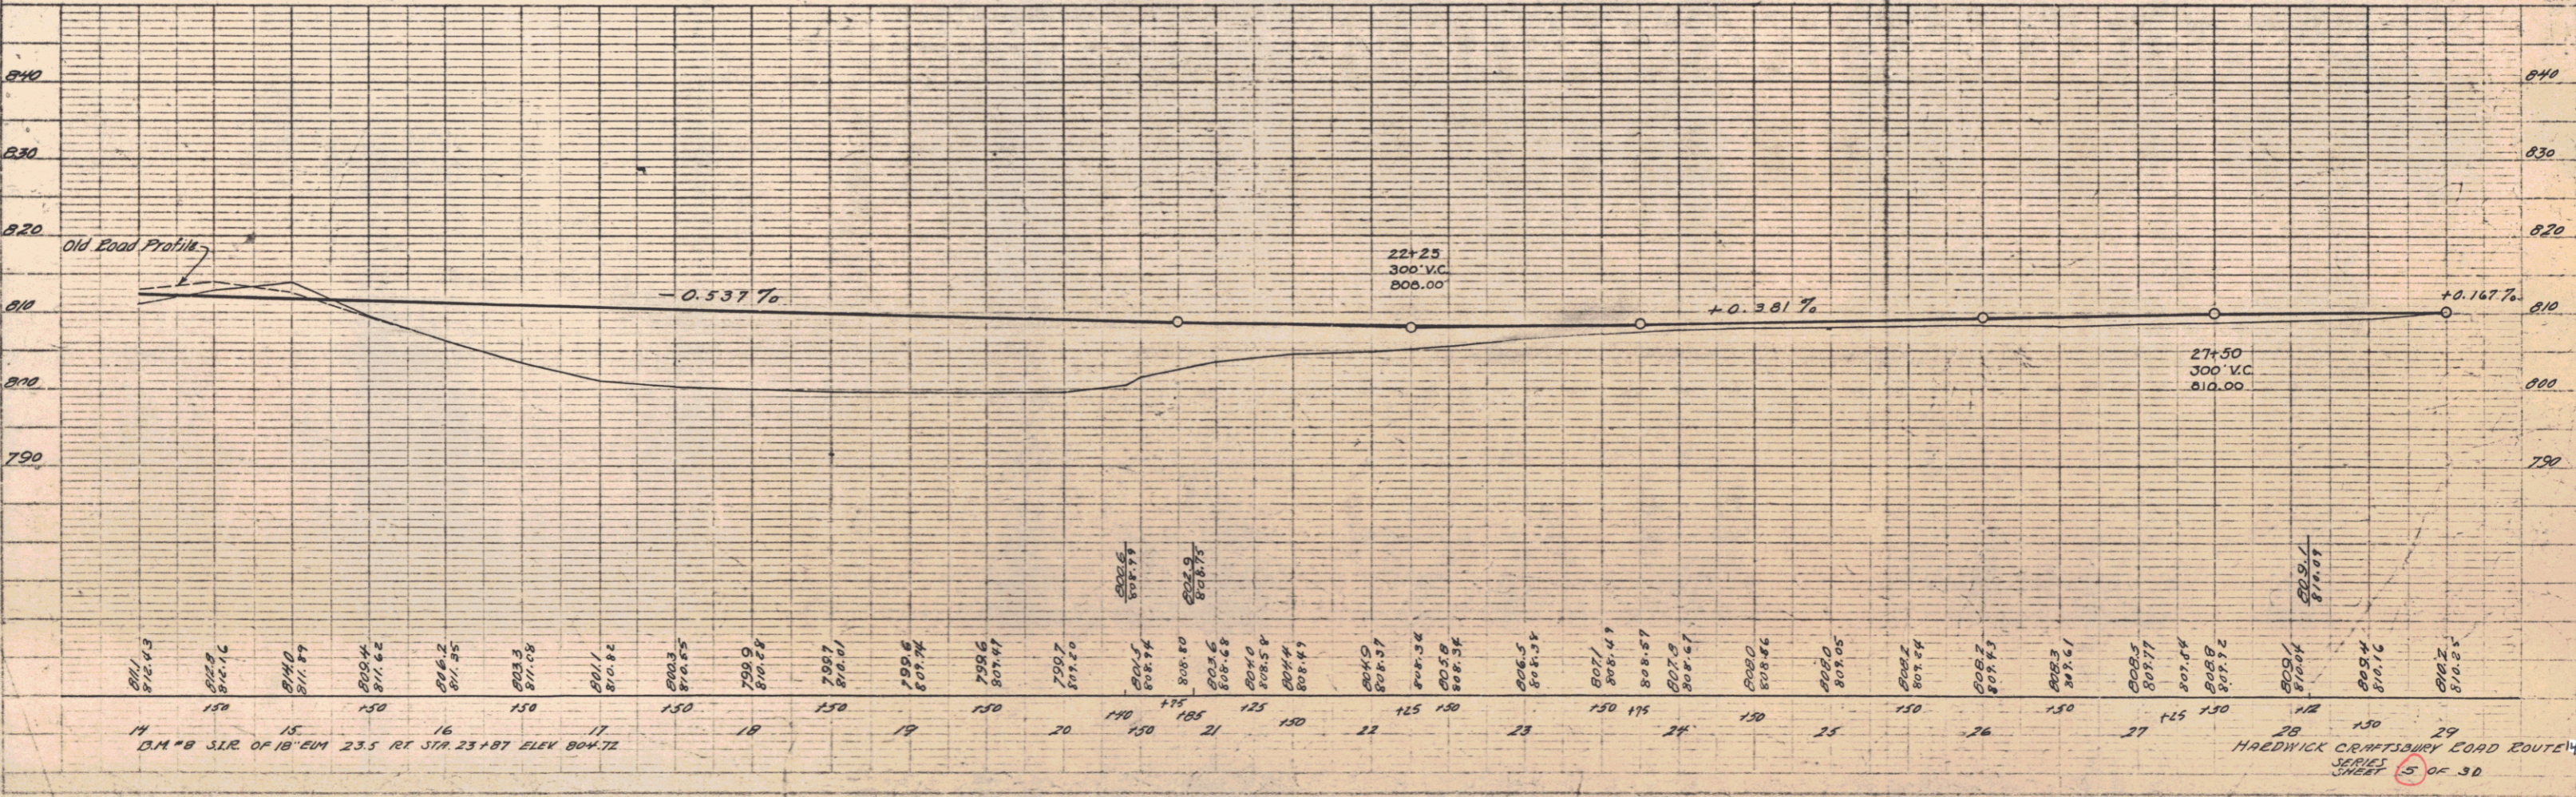


PARCEL INSTRUMENT	DATE	GRANTOR	GRANTEE	RECORDED HARDWICK	REMARKS
B-C	Q.C.D.	4-3-39	IRVING E. SARRAH CARR	ST OF V. BOOK PAGE DATE	
A, B	100%		ALTON H. & BLANCHE SLOANE	See SB(2) sheet 5	

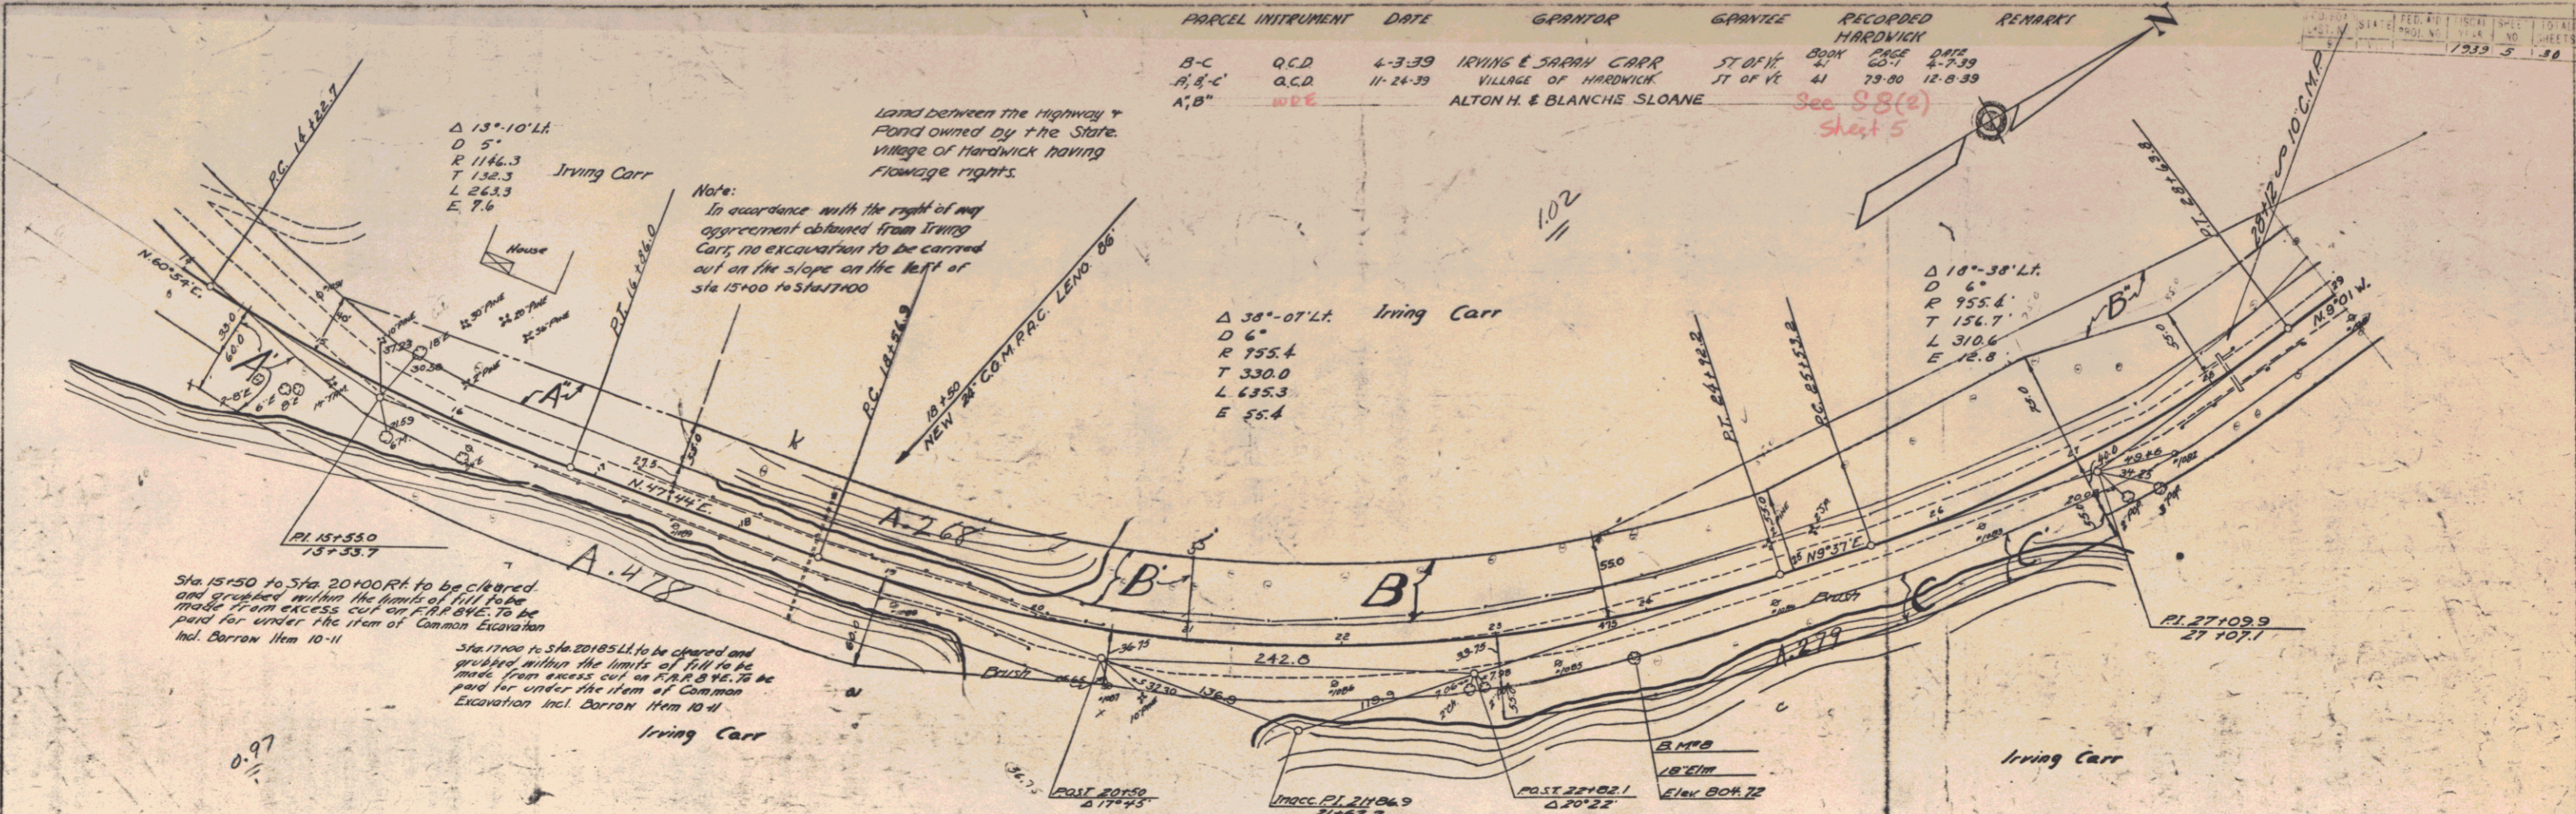

PLAN
 DRAWN BY
 CHECKED BY
 DATE

SECTION
 DRAWN BY
 CHECKED BY
 DATE