
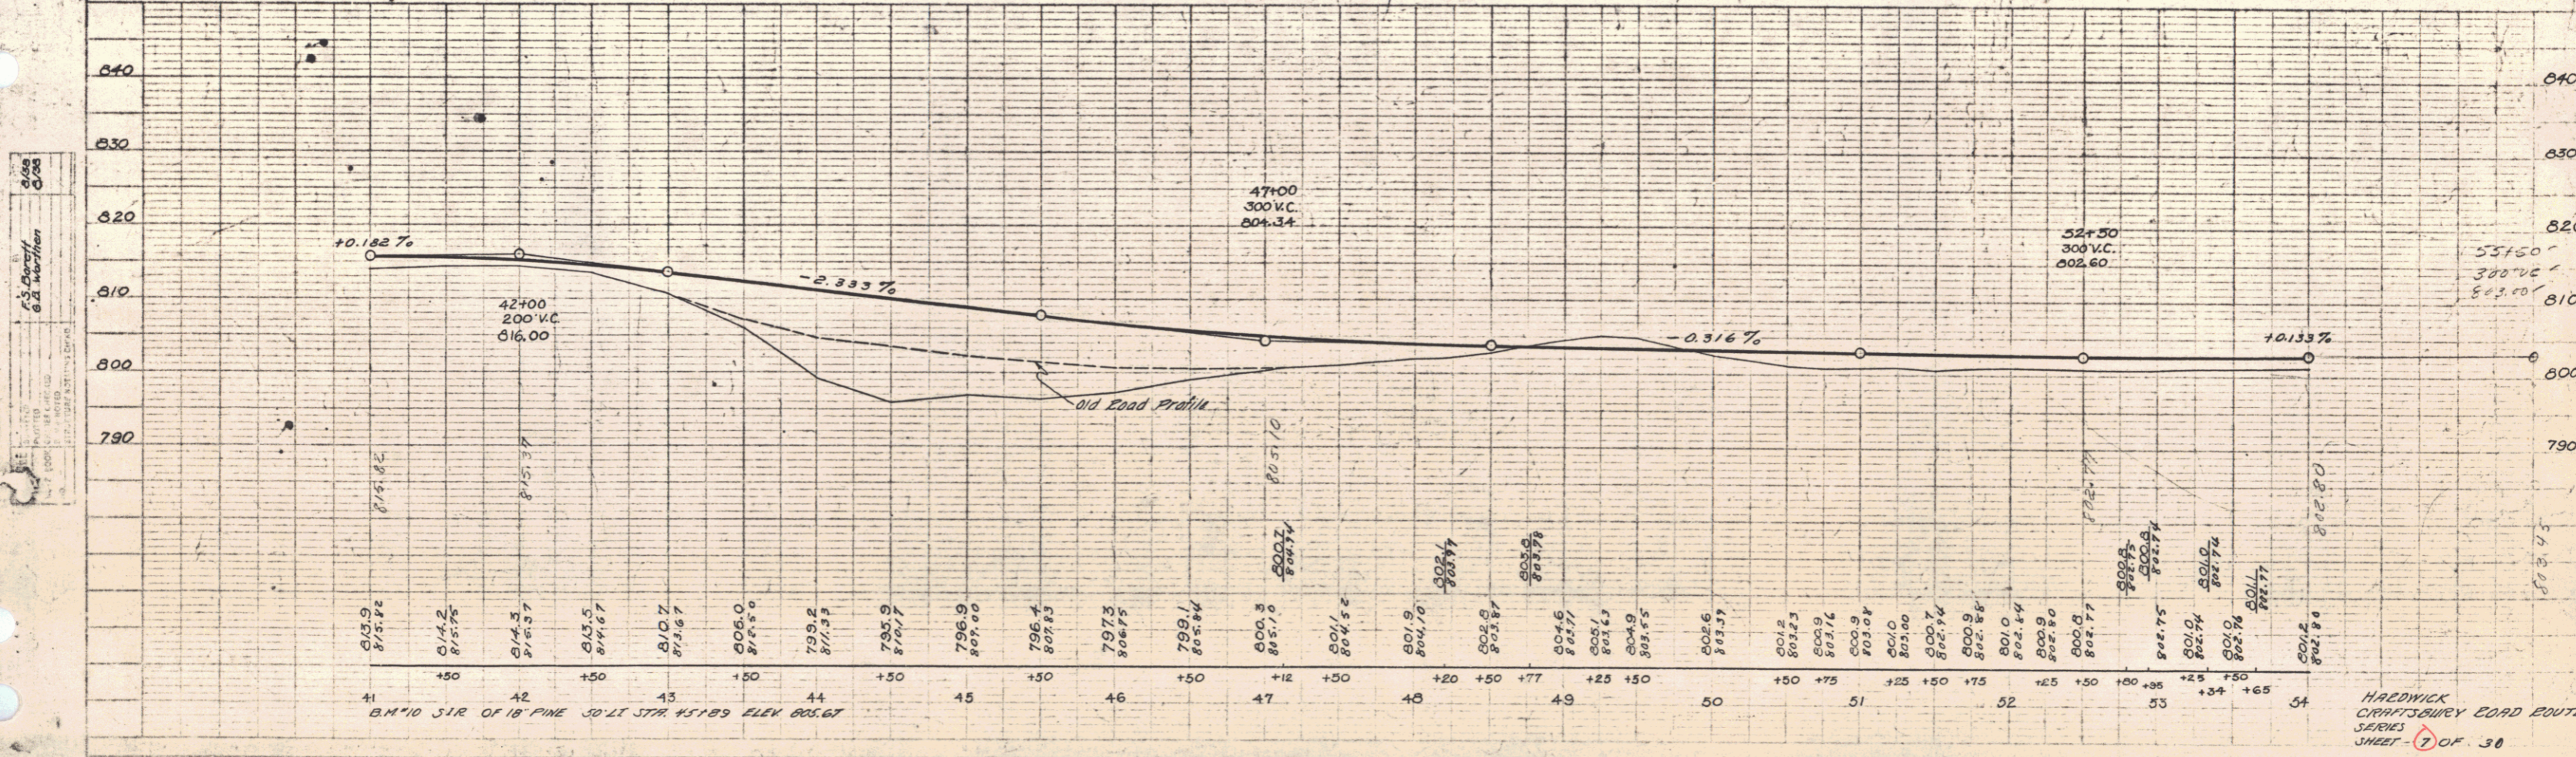


PARCEL	INSTRUMENT	DATE	GRANTOR	GRANTEE	RECORDED HARDWICK	REMARKS
B	Q.C.D.	4-3-39	HARRY & ALICE HOGABOOM	ST. OF V.	BOOK PAGE DATE	
A	Q.C.D.	4-3-39	FRED T. TAYLOR	ST. OF V.	41 39 4-7-39	
A'	Q.C.D.	4-7-39	ROY & LENA CONRAD	ST. OF V.	41 64 4-21-39	
E'	Q.C.D.	11-26-39	VILLAGE OF HARDWICK	ST. OF V.	41 79-80 12-8-39	

PLANNED	STATE	FED. AID	FISCAL	SHEET	TOTAL
NO.	NO.	NO.	NO.	NO.	NO.
1	1	1	1	7	30

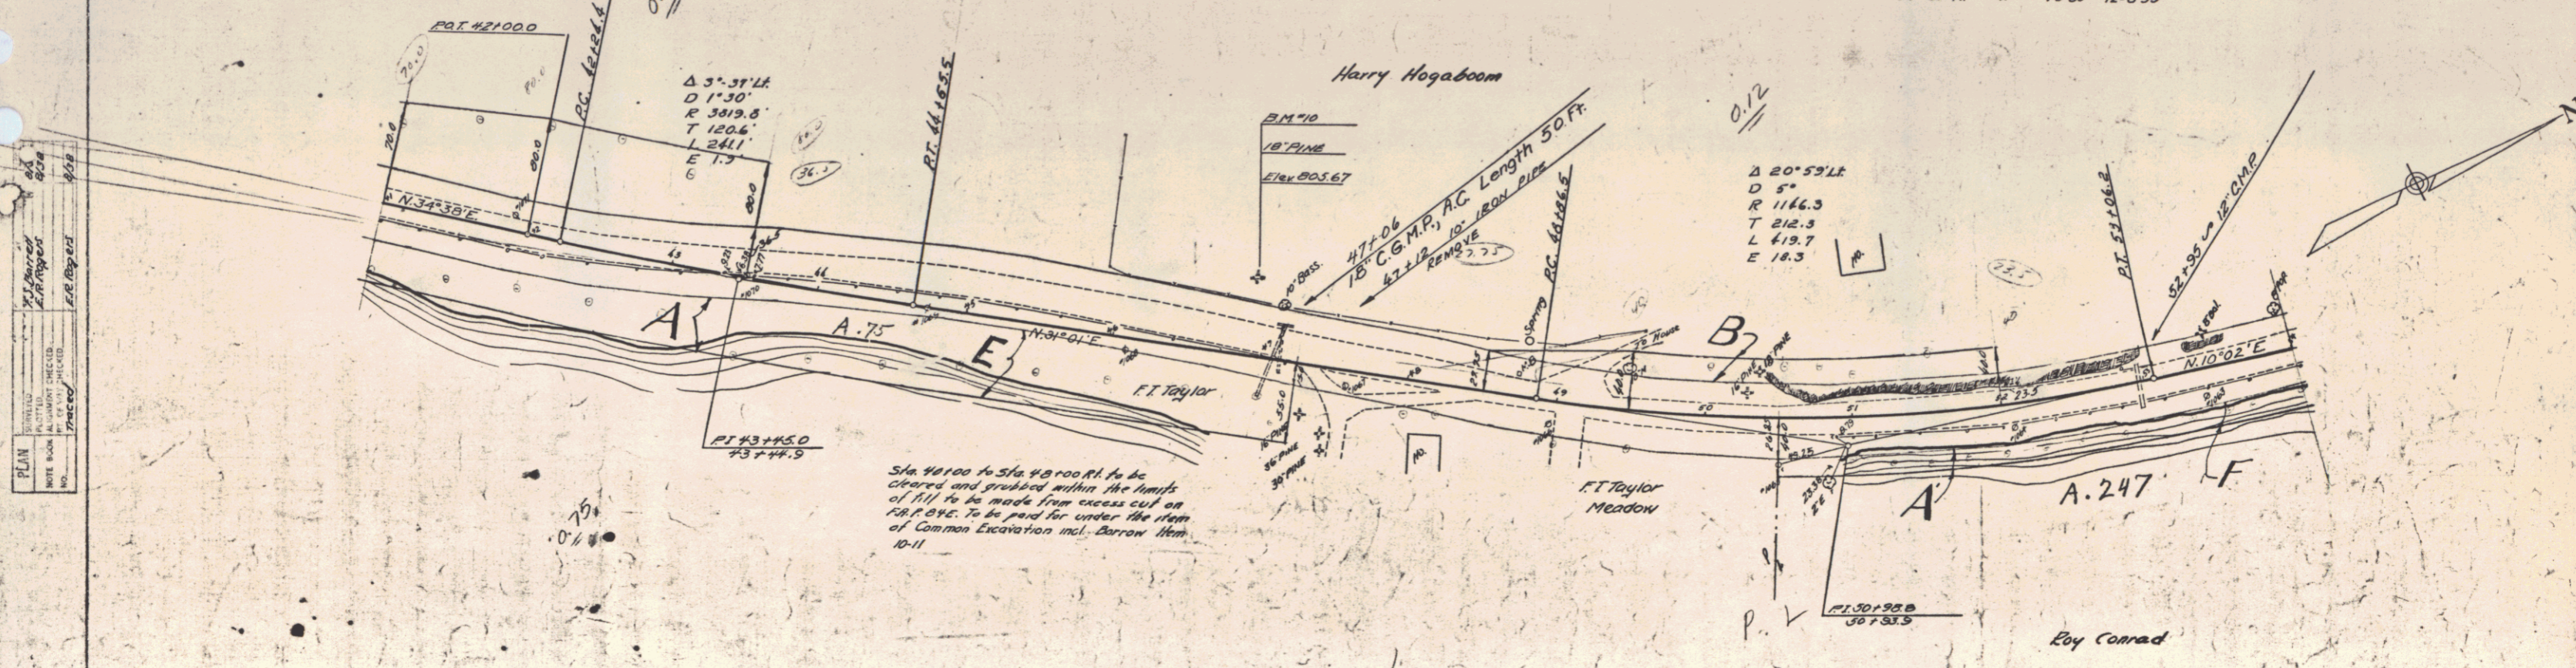

HARDWICK
SERIES
SHEET 7 OF 30