




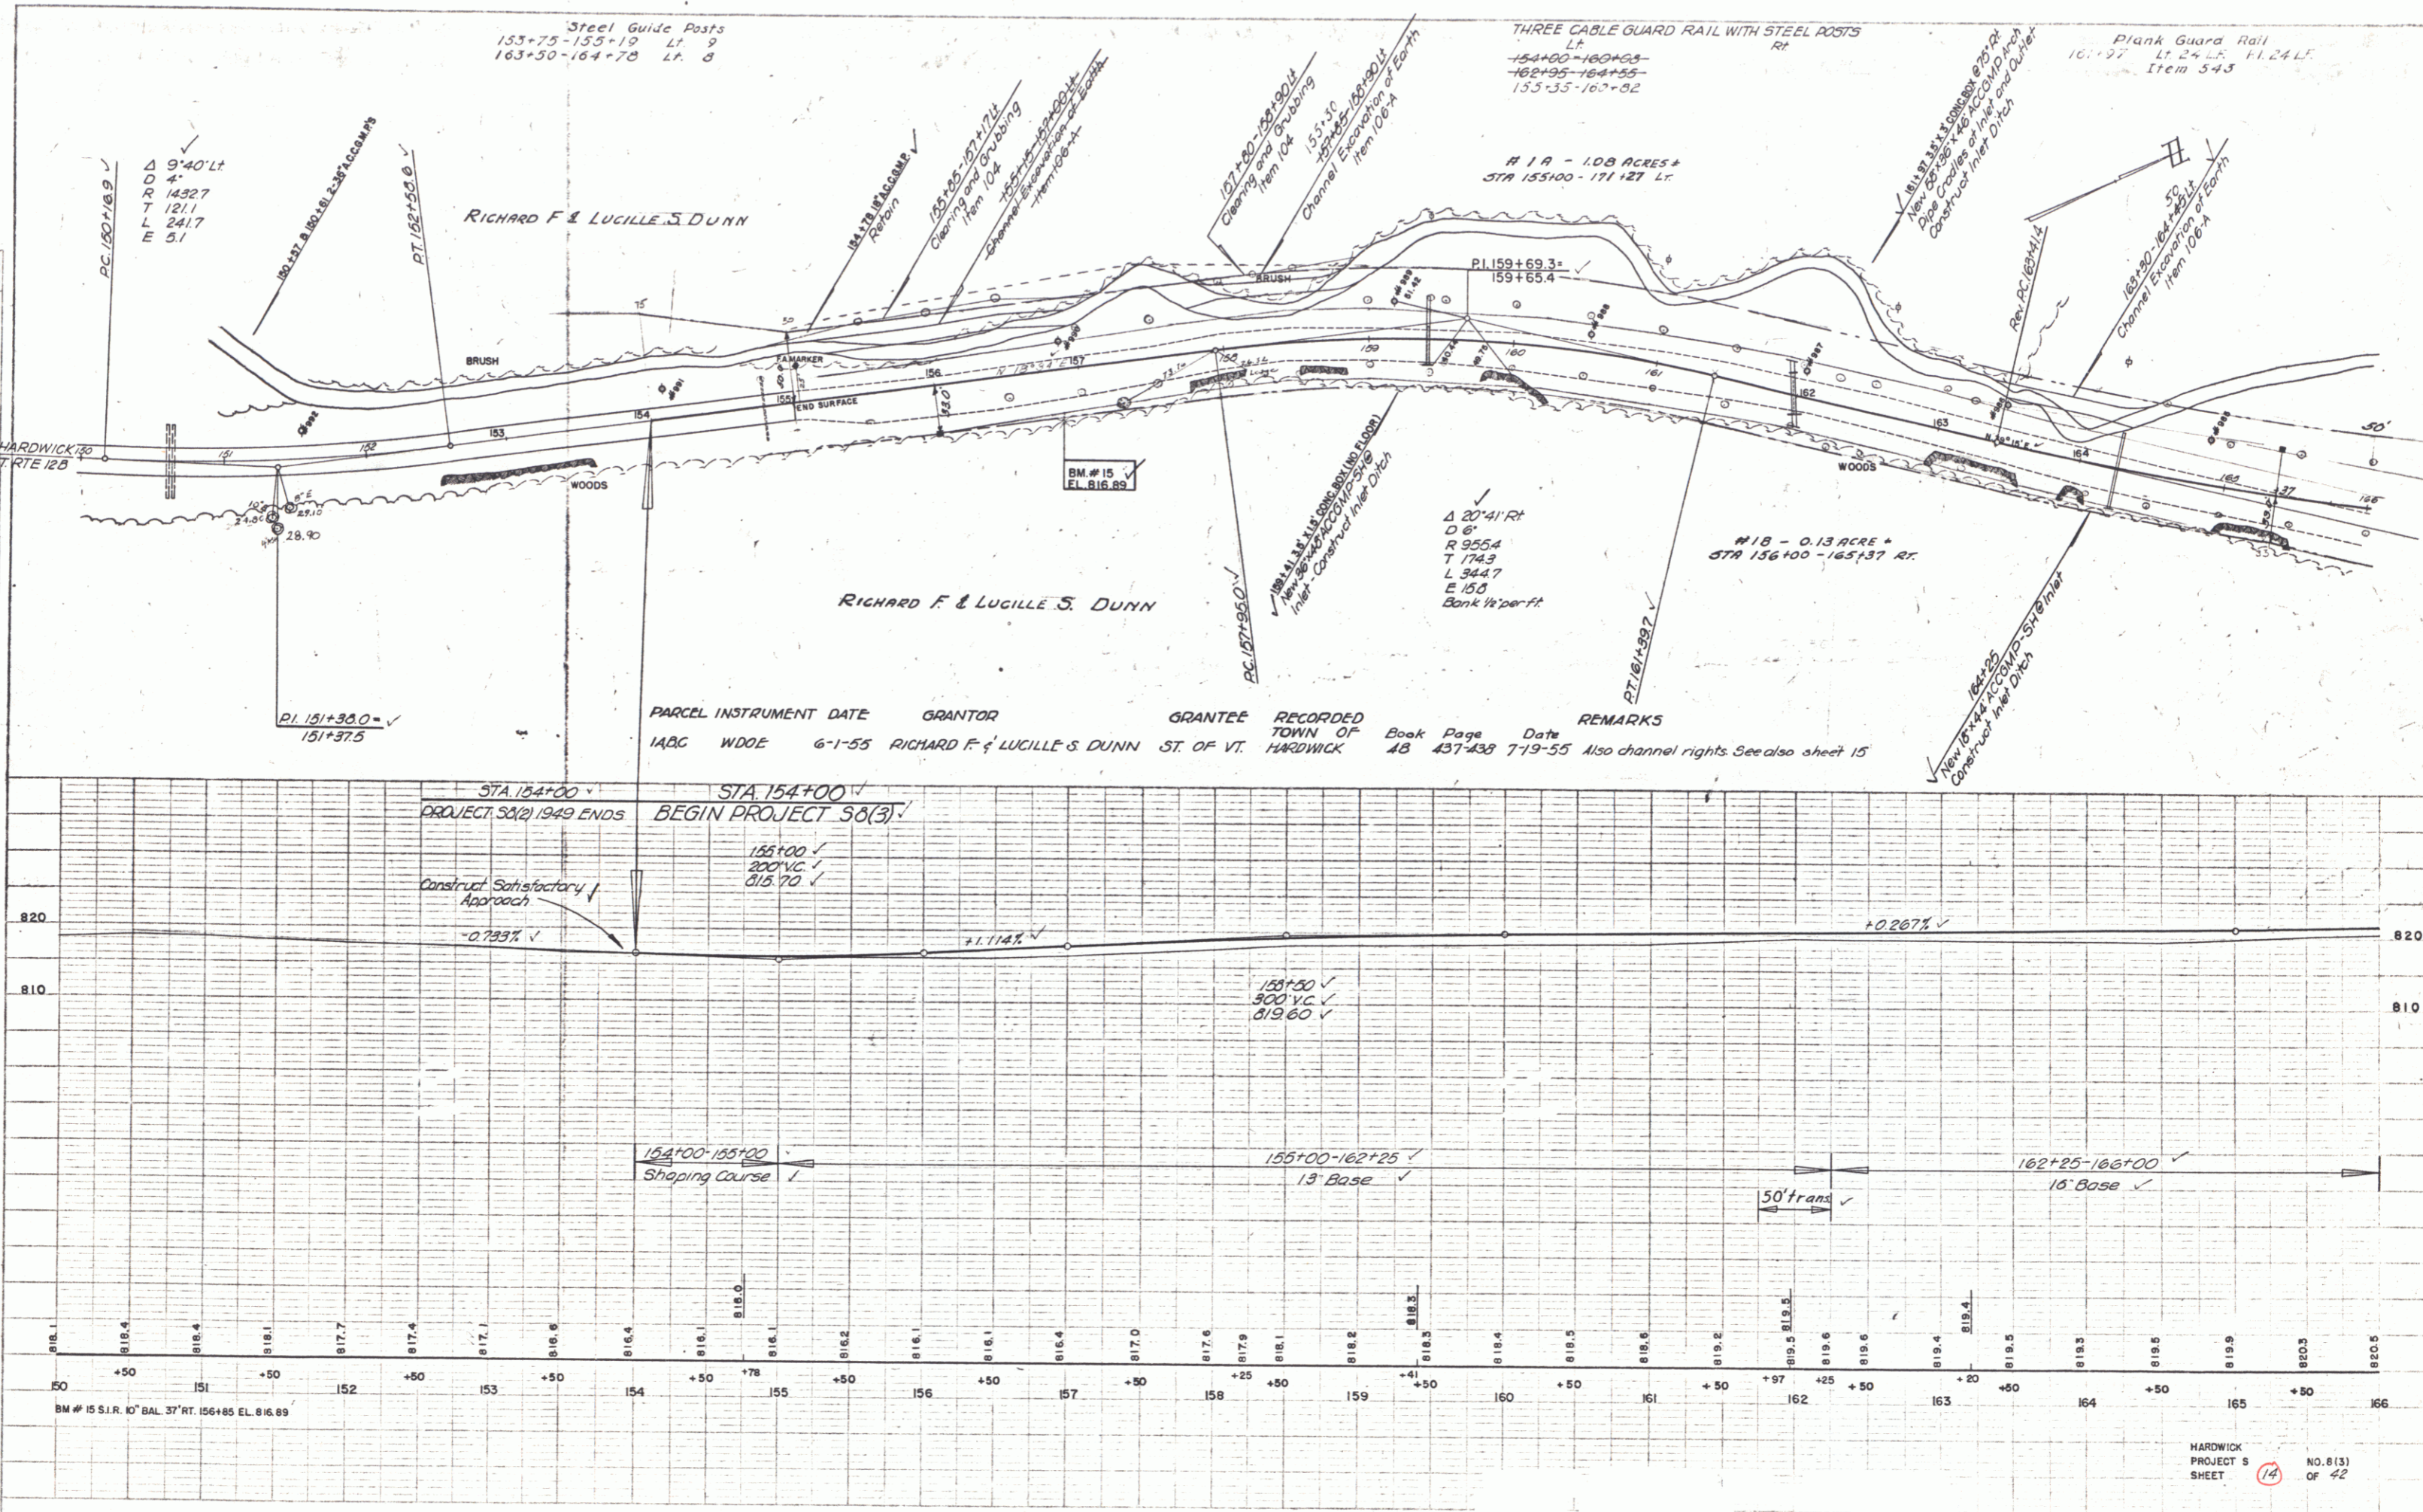

HARDWICK
 PROJECT 5
 SHEET 14
 OF 42