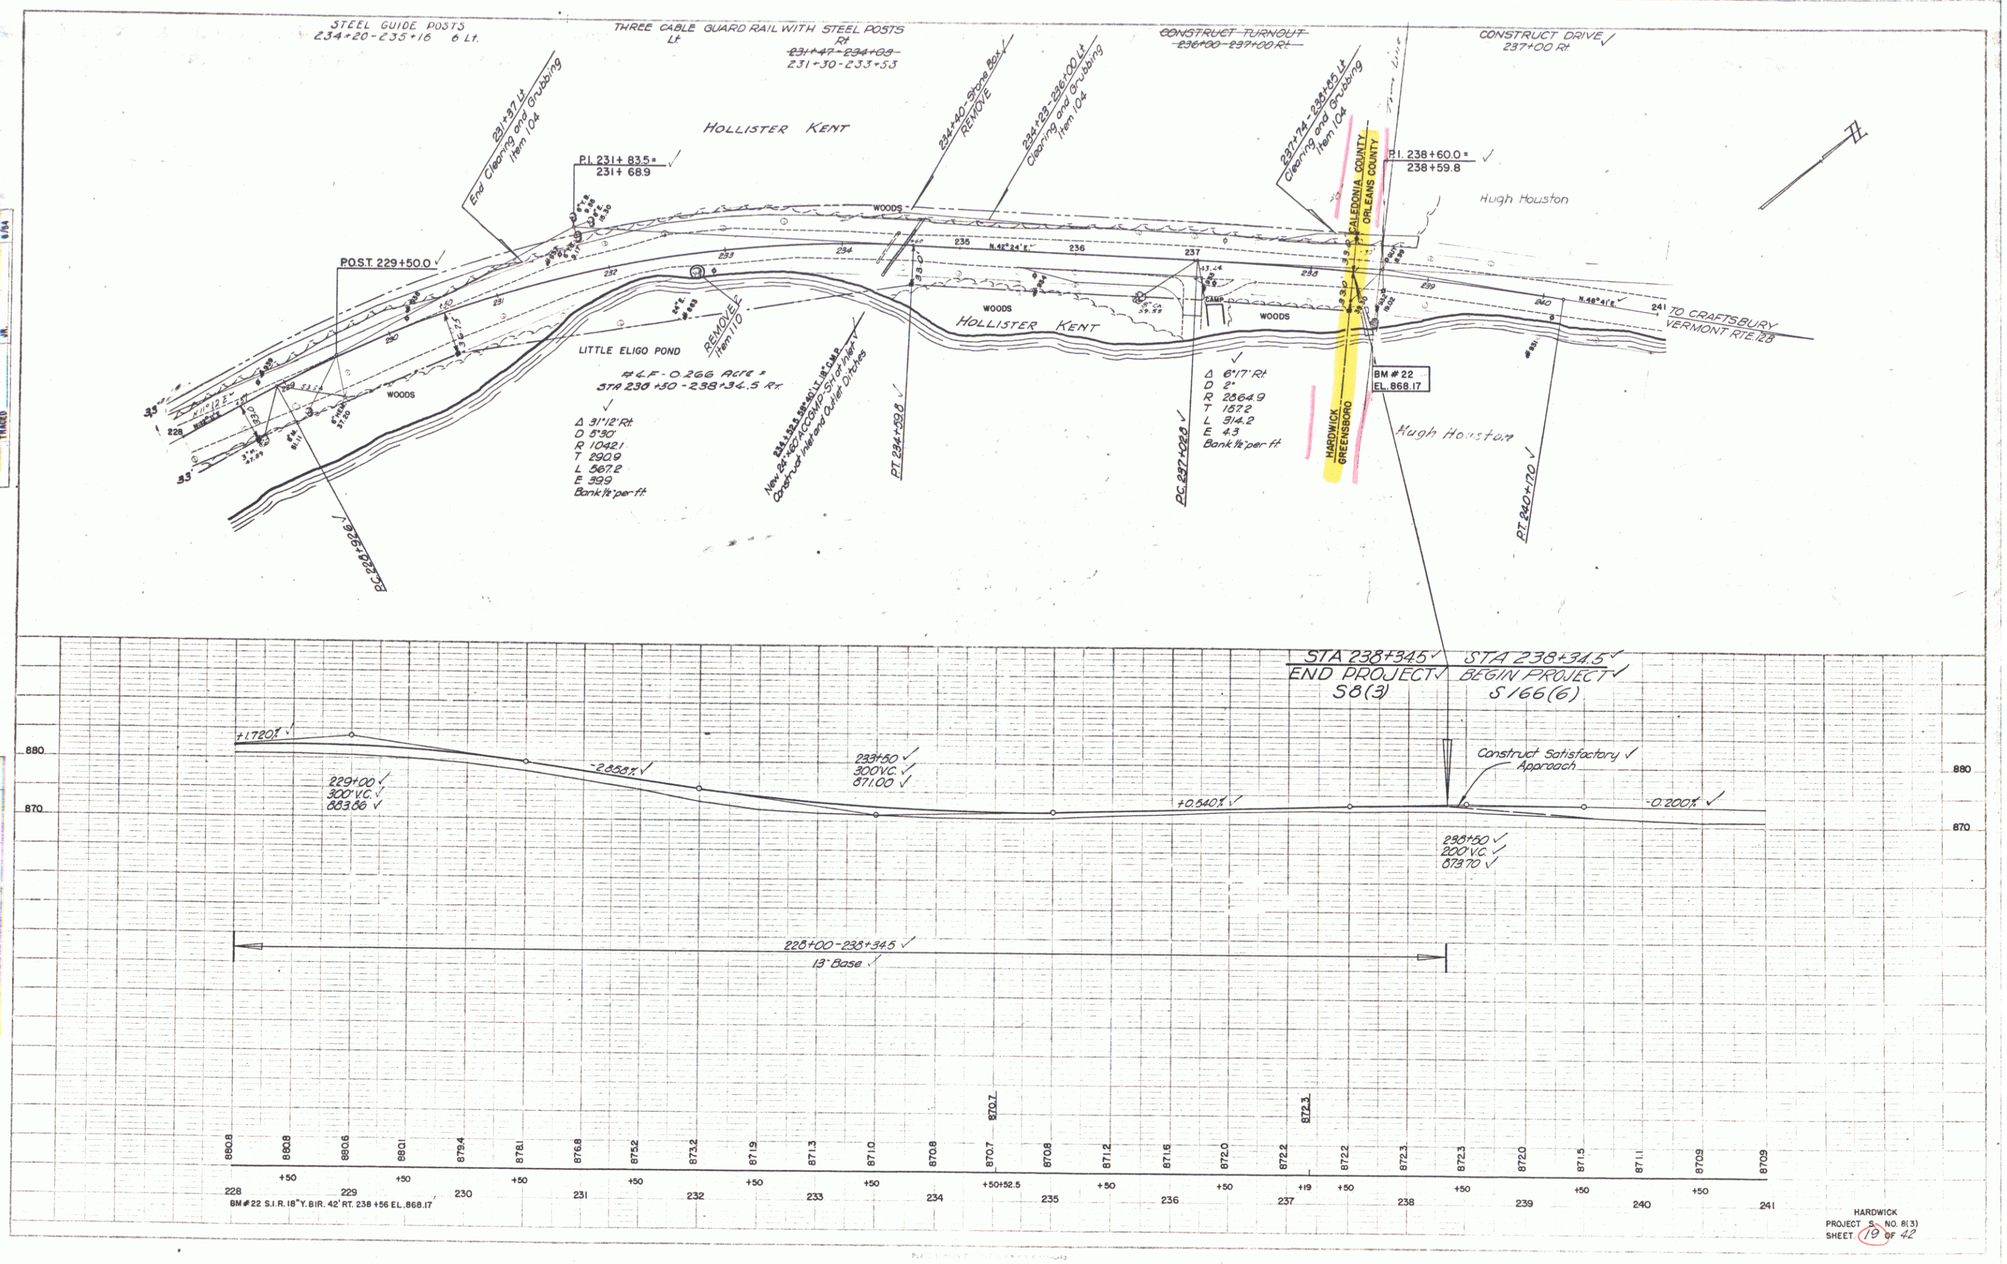
STEEL GUIDE POSTS
234+20-235+16 6 Lt.
THREE CABLE GUARD RAIL WITH STEEL POSTS
Rt
Lt
231+47-234+03
231+30-233+53
CONSTRUCT TURNOUT
236+00-237+00 Rt
CONSTRUCT DRIVE
237+00 Rt
231+37 Lt
End Clearing and Grubbing
Item 104
234+40 Stone Box
REMOVE
234+23-236+00 Lt
Clearing and Grubbing
Item 104
237+74-238+85 Lt
Clearing and Grubbing
Item 104
P.I. 231+83.5
231+68.9
P.I. 238+60.0
238+59.8
HOLLISTER KENT
Hugh Houston
WOODS
POST 229+50.0
N.48°24'E.
N.48°41'E.
CAMP
CALEDONIA COUNTY
ORLEANS COUNTY
TO CRAFTSBURY
VERMONT RTE.128
REMOVE
Item 110
LITTLE ELIGO POND
≈ L.F. - 0.266 Acre ≈
STA 230+50 - 238+34.5 Rt.
Δ 31°12' Rt.
D 5°30'
R 1042.1
T 290.9
L 567.2
E 39.9
Bank ft. per ft.
New 24" NCP ACCOMS. Shift High
Construct Inlet and Outlet Ditches
PT 234+59.2
PC 237+02.3
Δ 6°17' Rt.
D 2°
R 2864.9
T 157.2
L 314.2
E 4.3
Bank ft. per ft.
HARDWICK
GREENSBORO
BM # 22
EL. 868.17
PT 240+70
BC 226+29.8
STA 238+34.5
END PROJECT
S8(3)
STA 238+34.5
BEGIN PROJECT
S166(6)
+1.720%
-2.858%
+0.540%
-0.200%
229+00
300' V.C.
883.86
233+50
300' V.C.
871.00
238+50
200' V.C.
873.70
Construct Satisfactory
Approach
228+00-238+34.5
13' Base
880
870
BM # 22 S.I.R. 18" Y. BIR. 42' RT. 238+56 EL. 868.17
HARDWICK
PROJECT S. NO. 8(3)
SHEET 19 OF 42