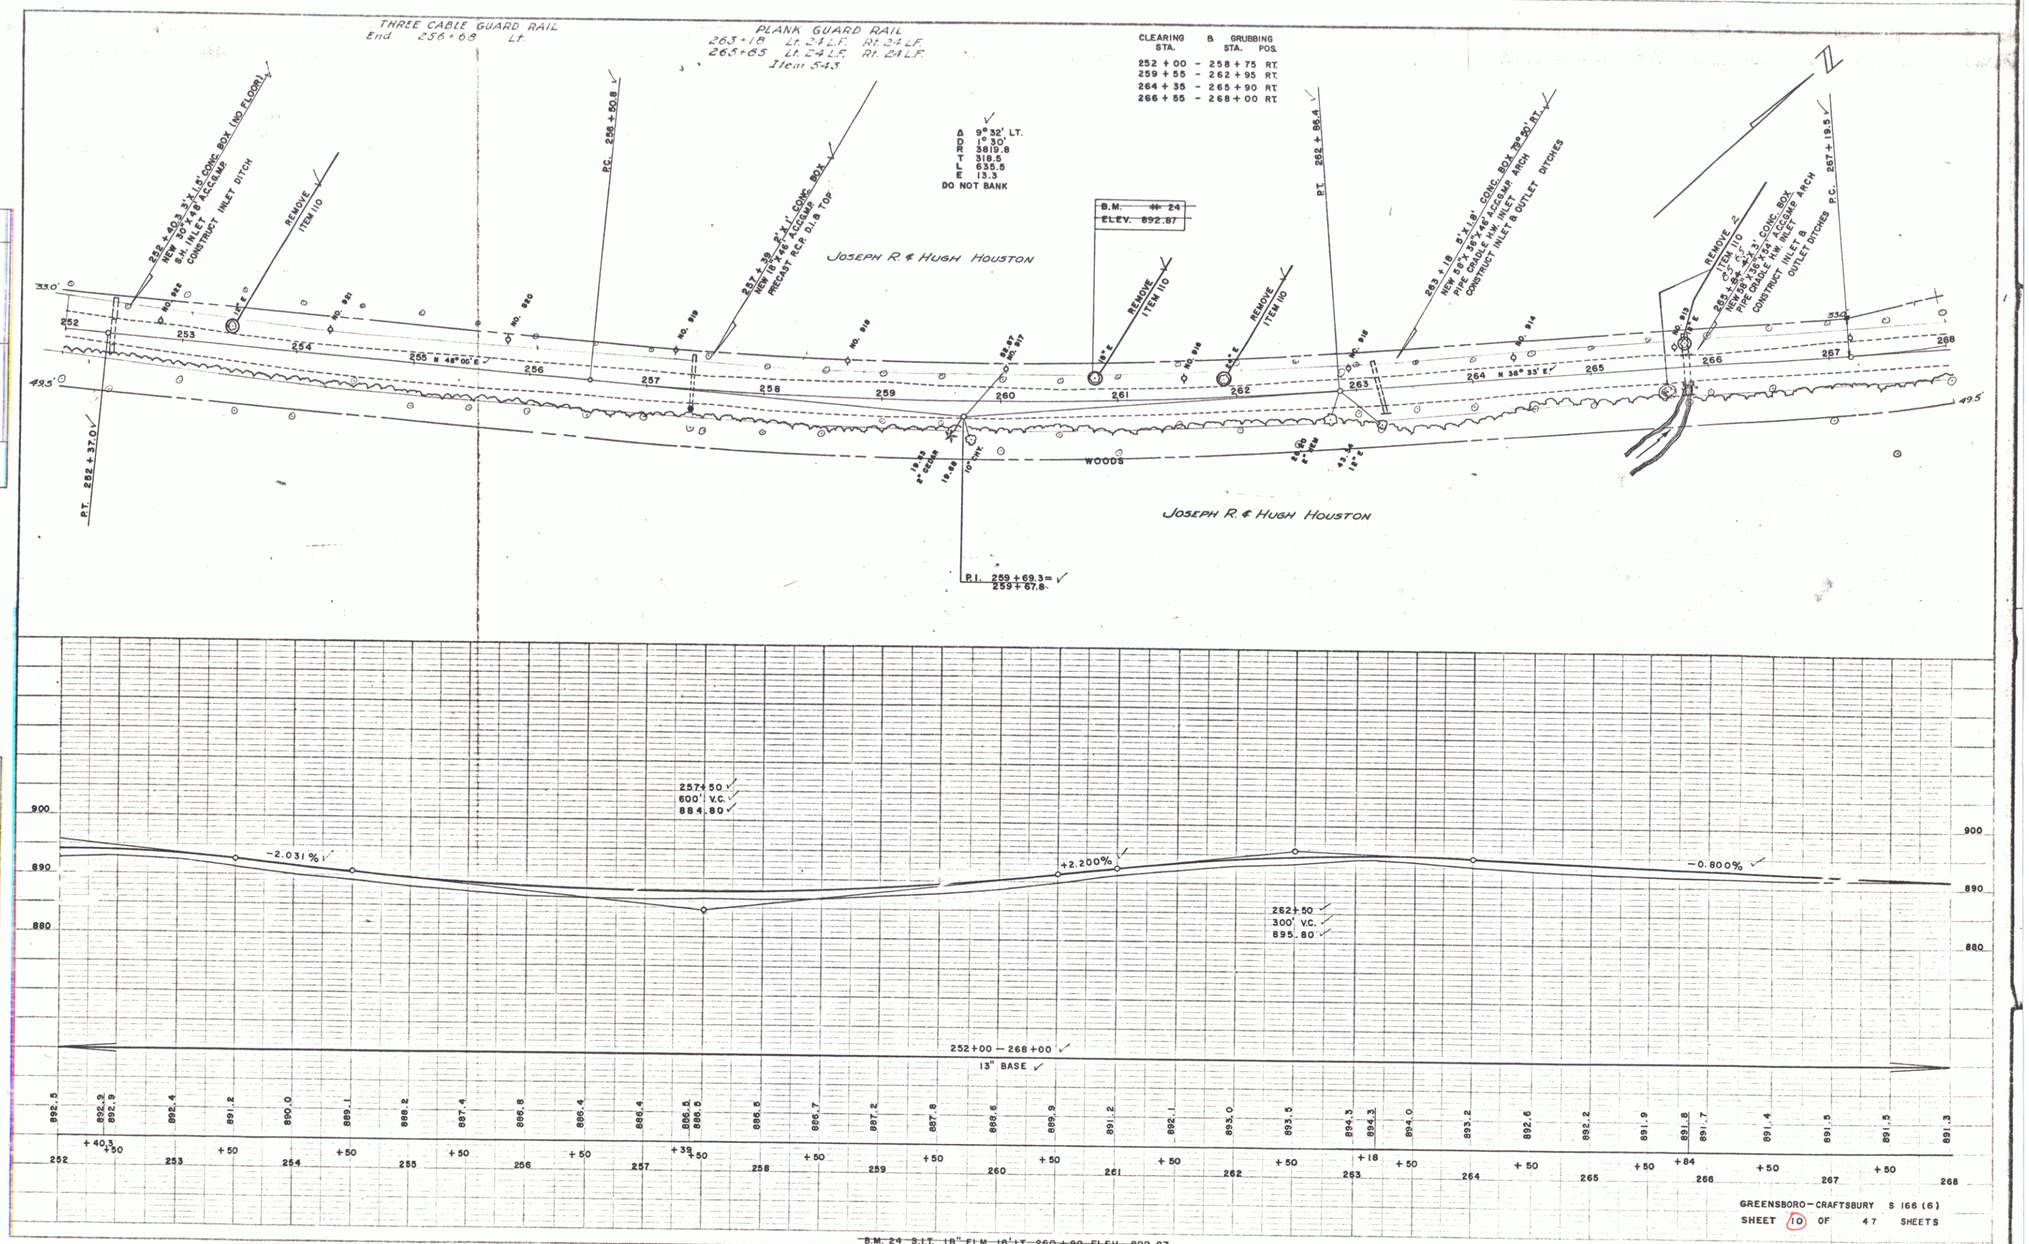


PLAN
SURVEYED
PLOTTED
NOTE BOOK ALIGNMENT CHECKED
NO. LT. OF WAY CHECKED
BY SPAULDING
WEBSTER-MARTIN INC. 1-54

PROFILE
SURVEYED
PLOTTED
NOTE BOOK PROFILE CHECKED
NO. S. M.S. NOTED
BY SPAULDING
WEBSTER-MARTIN INC. 1-54
STRUCTURE NOTES NO DETAIL

3