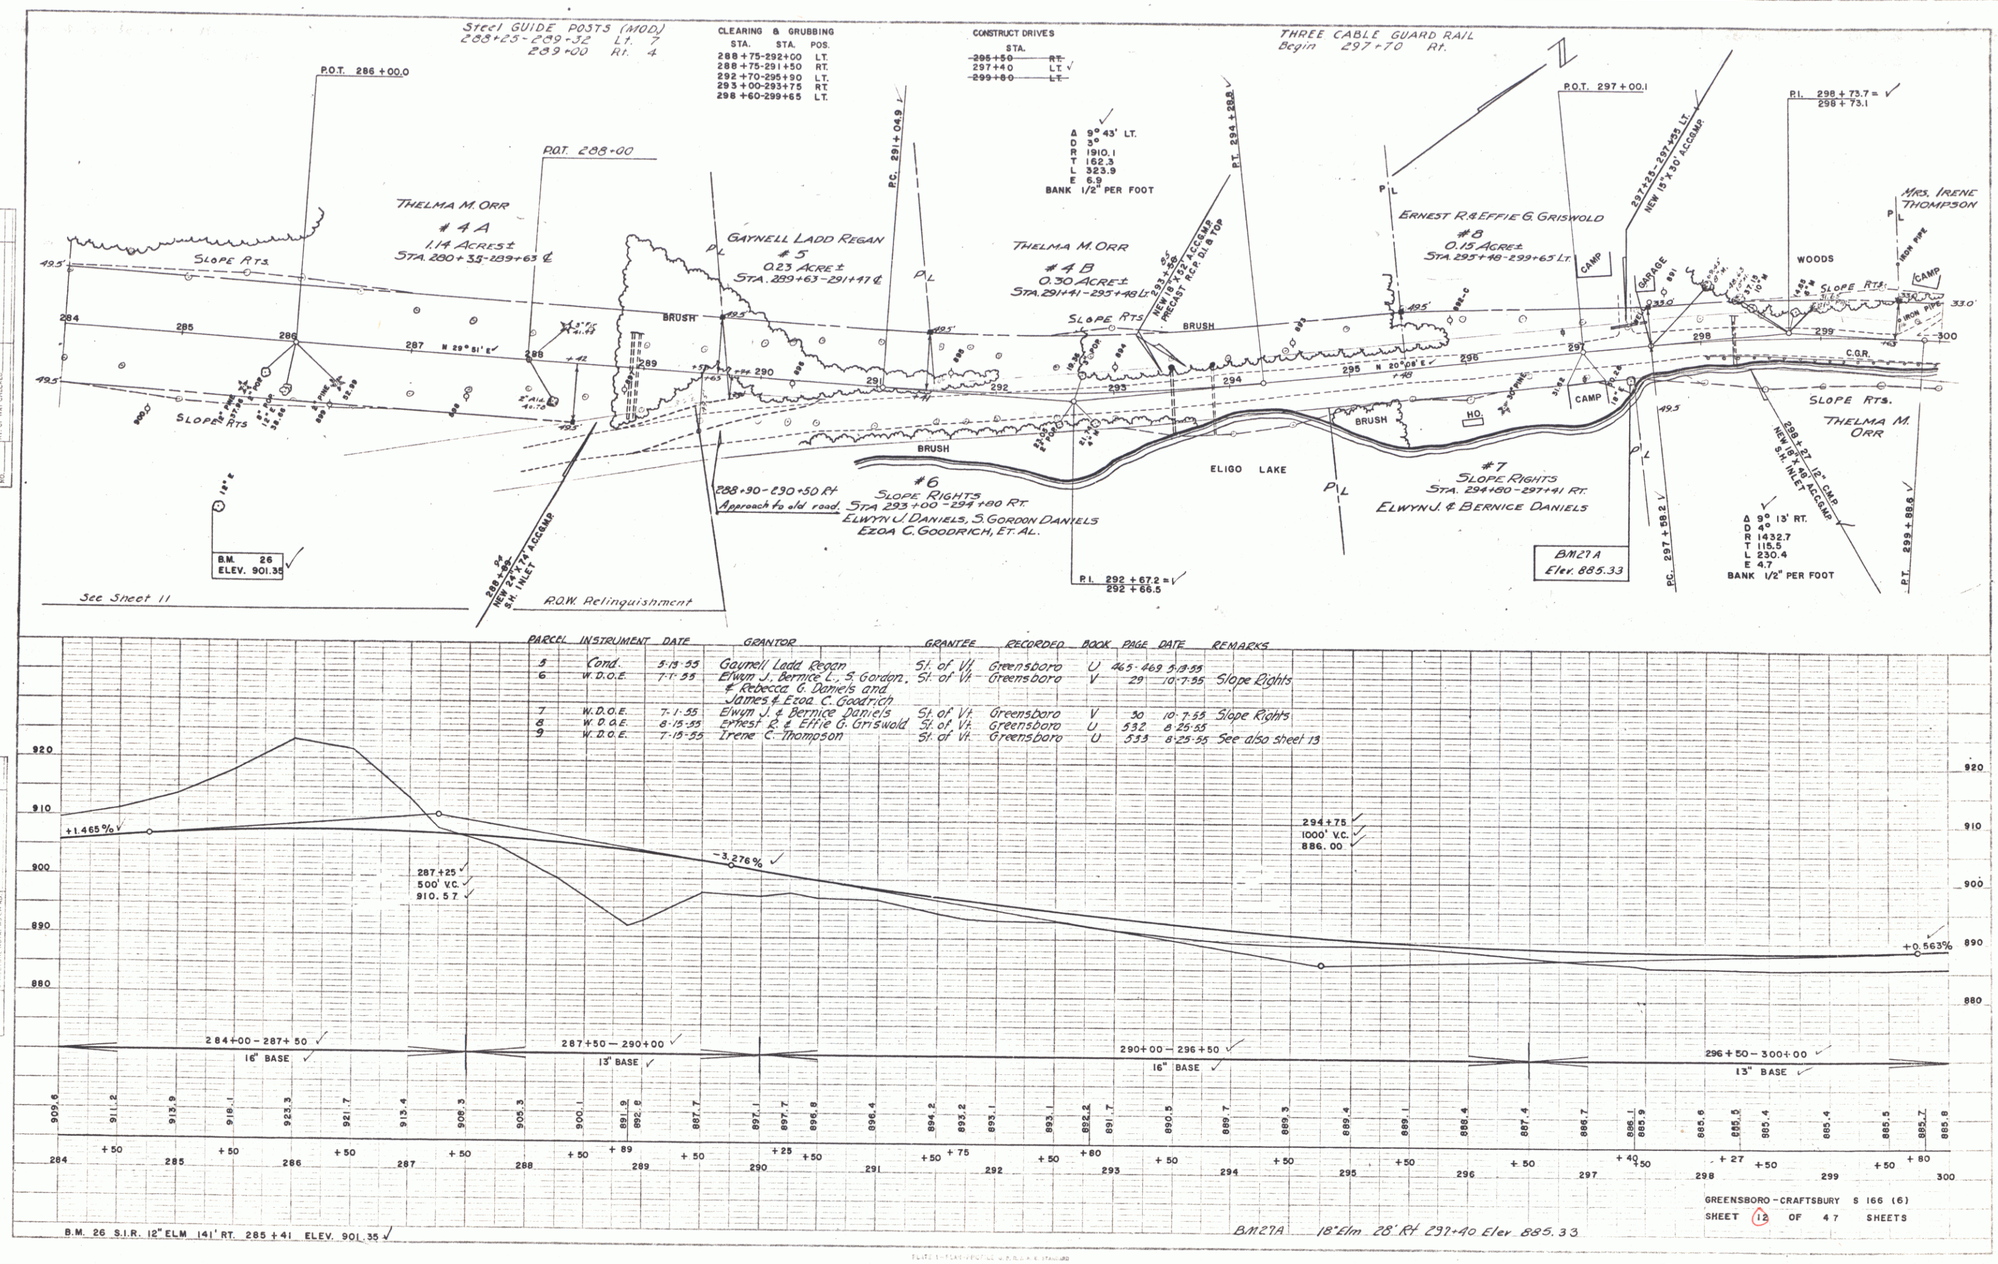

PARCEL	INSTRUMENT	DATE	GRANTOR	GRANTEE	RECORDED	BOOK	PAGE	DATE	REMARKS
5	Cond.	5-13-55	Gaynell Ladd Regan	St. of Vt.	Greensboro	U	465-469	5-13-55	
6	W.D.O.E.	7-1-55	Elwyn J., Bernice L., S. Gordon, & Rebecca G. Daniels and James & Ezoa C. Goodrich	St. of Vt.	Greensboro	V	29	10-7-55	Slope Rights
7	W.D.O.E.	7-1-55	Elwyn J. & Bernice Daniels	St. of Vt.	Greensboro	V	30	10-7-55	Slope Rights
8	W.D.O.E.	8-15-55	Ernest R. & Effie G. Griswold	St. of Vt.	Greensboro	U	532	8-25-55	
9	W.D.O.E.	7-15-55	Irene C. Thompson	St. of Vt.	Greensboro	U	533	8-25-55	See also sheet 13

B.M. 26 S.I.R. 12" ELM 141' RT. 285+41 ELEV. 901.35

BM27A 18" Elm 28' Rt 297+40 Elev. 885.33

GREENSBORO - CRAFTSBURY S 166 (6)

SHEET 12 OF 47 SHEETS

PLAN — DELANO & SPAULDING 7-54 — WEBSTER - MARTIN, INC. 11-54

PROFILE — DELANO & SPAULDING 7-54 — WEBSTER - MARTIN, INC. 7-54