THREE CABLE GUARD RAIL
316+30 - 321+22 Rt.
321+38 - 324+26 Rt.
325+00 - 326+44 Rt.

CLEARING & GRUBBING STA.	STA. POS.
316+75	318+00 LT.
319+00	319+75 RT.
322+00	322+50 RT.
323+50	324+15 RT.
326+25	327+75 LT.
329+80	331+45 LT.

CONSTRUCT PARKING AREA
STA. STA. POS.
~~320+50 322+50 RT.~~
321+00 - 322+25 Rt.

~~CONSTRUCT DRIVE~~
~~STA.~~
~~316+07 RT.~~

STEEL GUIDE POSTS (MOD)
326+60 - 329+32 Rt. 17
Begin 329+82 Rt. 39

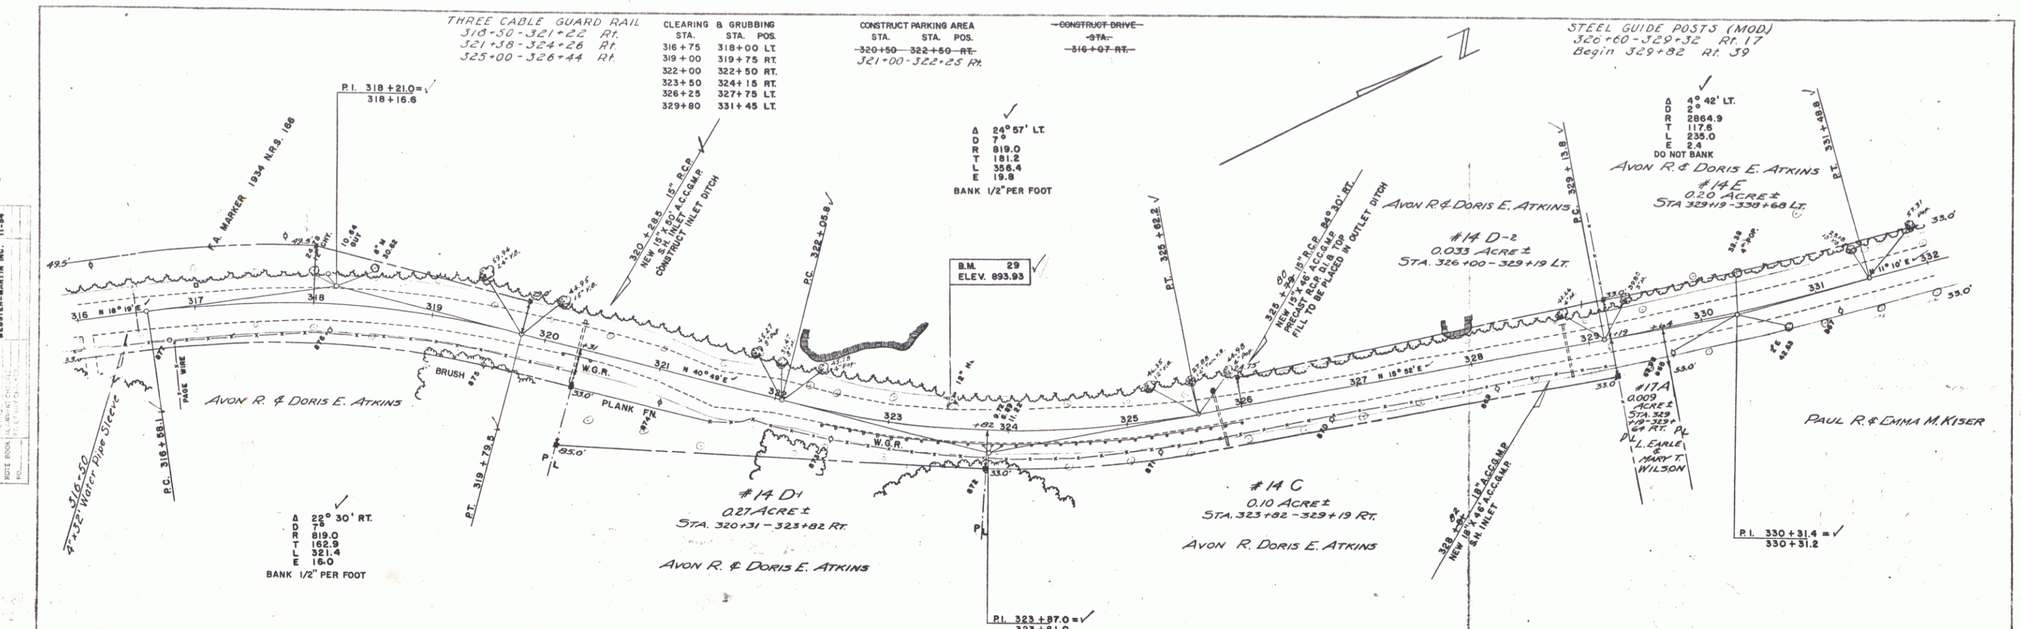

PARCEL	INSTRUMENT	DATE	GRANTOR	GRANTEE	RECORDED BOOK	PAGE	DATE	REMARKS
17A	W.D.O.E.	7-1-55	L. Earle & Mary T. Wilson	St. of Vt.	Greensboro U	530	7-14-55	
19	W.D.	8-9-55	John A. & Irene H. Durkee	St. of Vt.	Greensboro U	536	8-25-55	See sheet 15

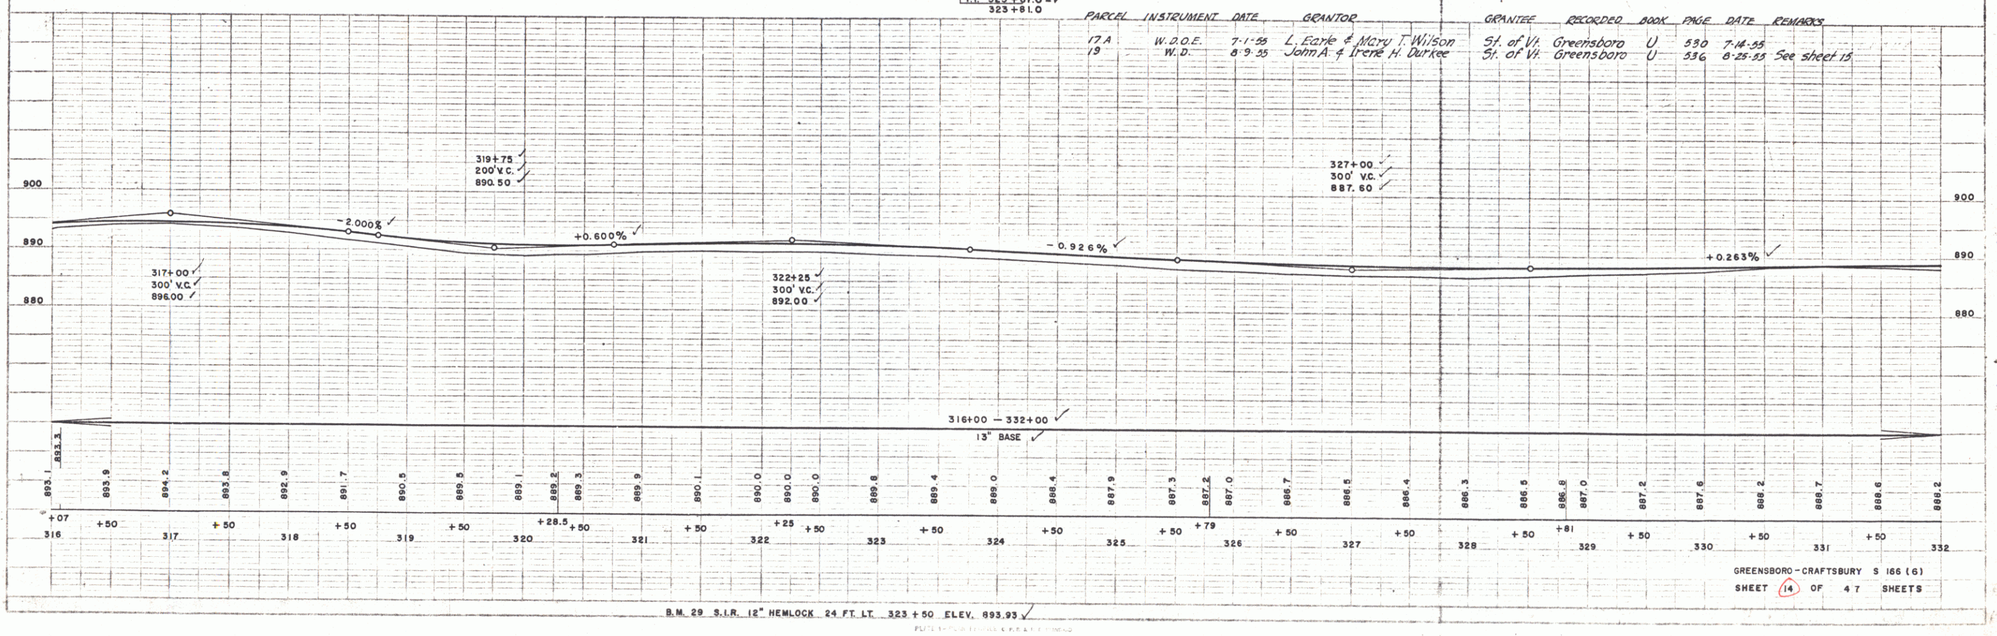

B.M. 29 S.I.R. 12" HEMLOCK 24 FT. LT. 323+50 ELEV. 893.93

GREENSBORO - CRAFTSBURY S 166 (6)
SHEET 14 OF 47 SHEETS

SPAULDING WEBSTER-MARTIN INC. 7-54 11-54

7