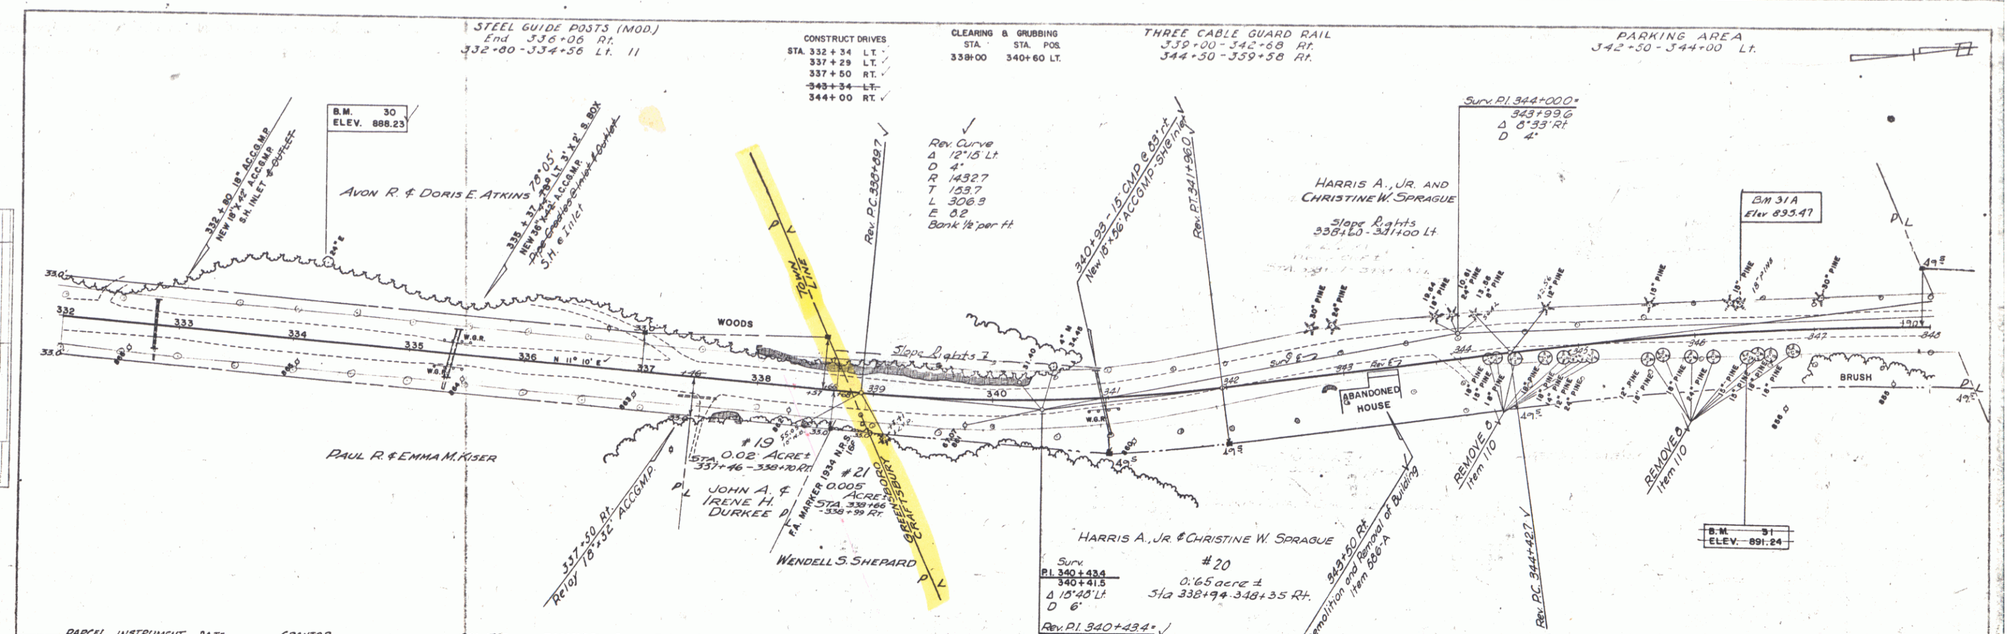

PARCEL	INSTRUMENT	DATE	GRANTOR	GRANTEE	RECORDED BOOK	PAGE	DATE	REMARKS
19	W.D.	8-9-55	John A. & Irene H. Durkee	St. of Vt.	Greensboro U	536	8-25-55	
20	W.D.O.E.	7-25-55	Harris A., Jr. & Christine W. Sprague	St. of Vt.	Craftsbury 30	292	8-25-55	See also sheet 16
21	W.D.O.E.	7-1-55	Wendell S. Shepard	St. of Vt.	Greensboro U	531	7-14-55	

GREENSBORO - CRAFTSBURY S 166 (6)

SHEET 15 OF 47 SHEETS