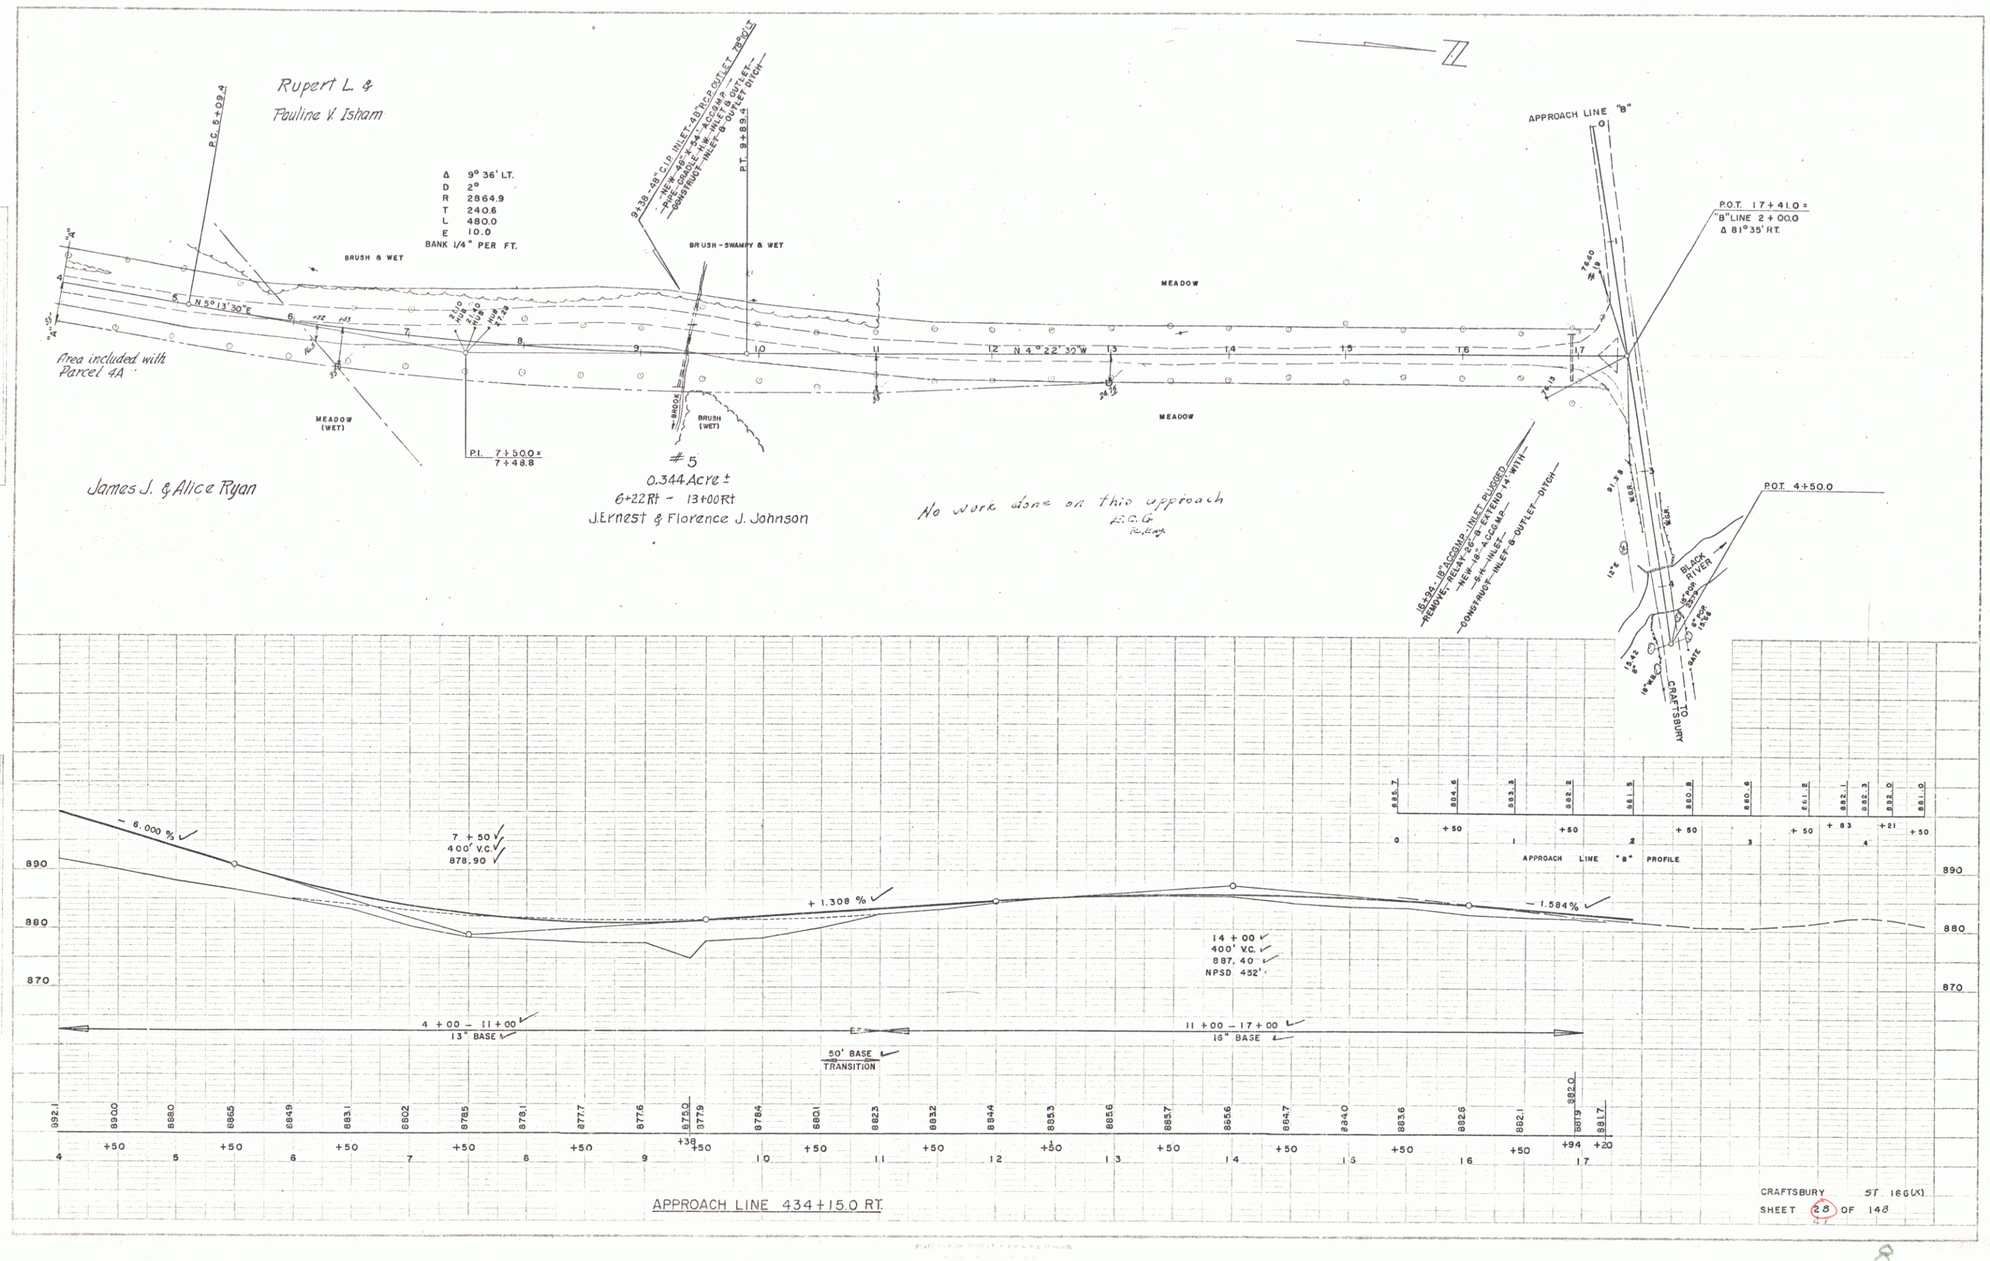
Rupert L. &
Pauline V. Isham
P.C. 5+09.4
Δ 9° 36' LT.
D 2°
R 2864.9
T 240.6
L 480.0
E 10.0
BANK 1/4" PER FT.
BRUSH & WET
N 5° 13' 30" E
Area included with Parcel 4A
MEADOW (WET)
P.I. 7+50.0±
7+48.8
James J. & Alice Ryan
9+38 - 48" C.I.P. INLET - 48" "ROP OUTLET 75° OLT
- NEW - 48" x 54" ACCAM
- PIPE - ONLY - NW - INLET & OUTLET -
- CONSTRUCT - INLET & OUTLET DITCH -
P.T. 9+89.4
BRUSH - SWAMPY & WET
BROOK
BRUSH (WET)
#5
0.344 Acre ±
6+22 Rt - 13+00 Rt
J. Ernest & Florence J. Johnson
MEADOW
N 4° 22' 30" W
No work done on this approach
F.O.G.
APPROACH LINE "B"
P.O.T. 17+41.0±
"B" LINE 2+00.0
Δ 81° 35' RT.
P.O.T. 4+50.0
15-24 - 18" ACCORD - INLET PLUGGED
- REMOVE - REAR 20' & EXTEND 14" WITH -
- NEW - 18" x 42" ACCAMP -
- 5" - INLET -
- CONSTRUCT - INLET & OUTLET - DITCH -
BLACK RIVER
CRAFTSBURY
TO
APPROACH LINE "B" PROFILE
- 6.000 %
7 + 50
400' V.C.
878.90
+ 1.308 %
- 1.584 %
14 + 00
400' V.C.
887.40
NPSD 452'
4 + 00 - 11 + 00
13" BASE
11 + 00 - 17 + 00
16" BASE
50' BASE
TRANSITION
APPROACH LINE 434+15.0 RT.
CRAFTSBURY ST. 166(X)
SHEET 28 OF 148

8