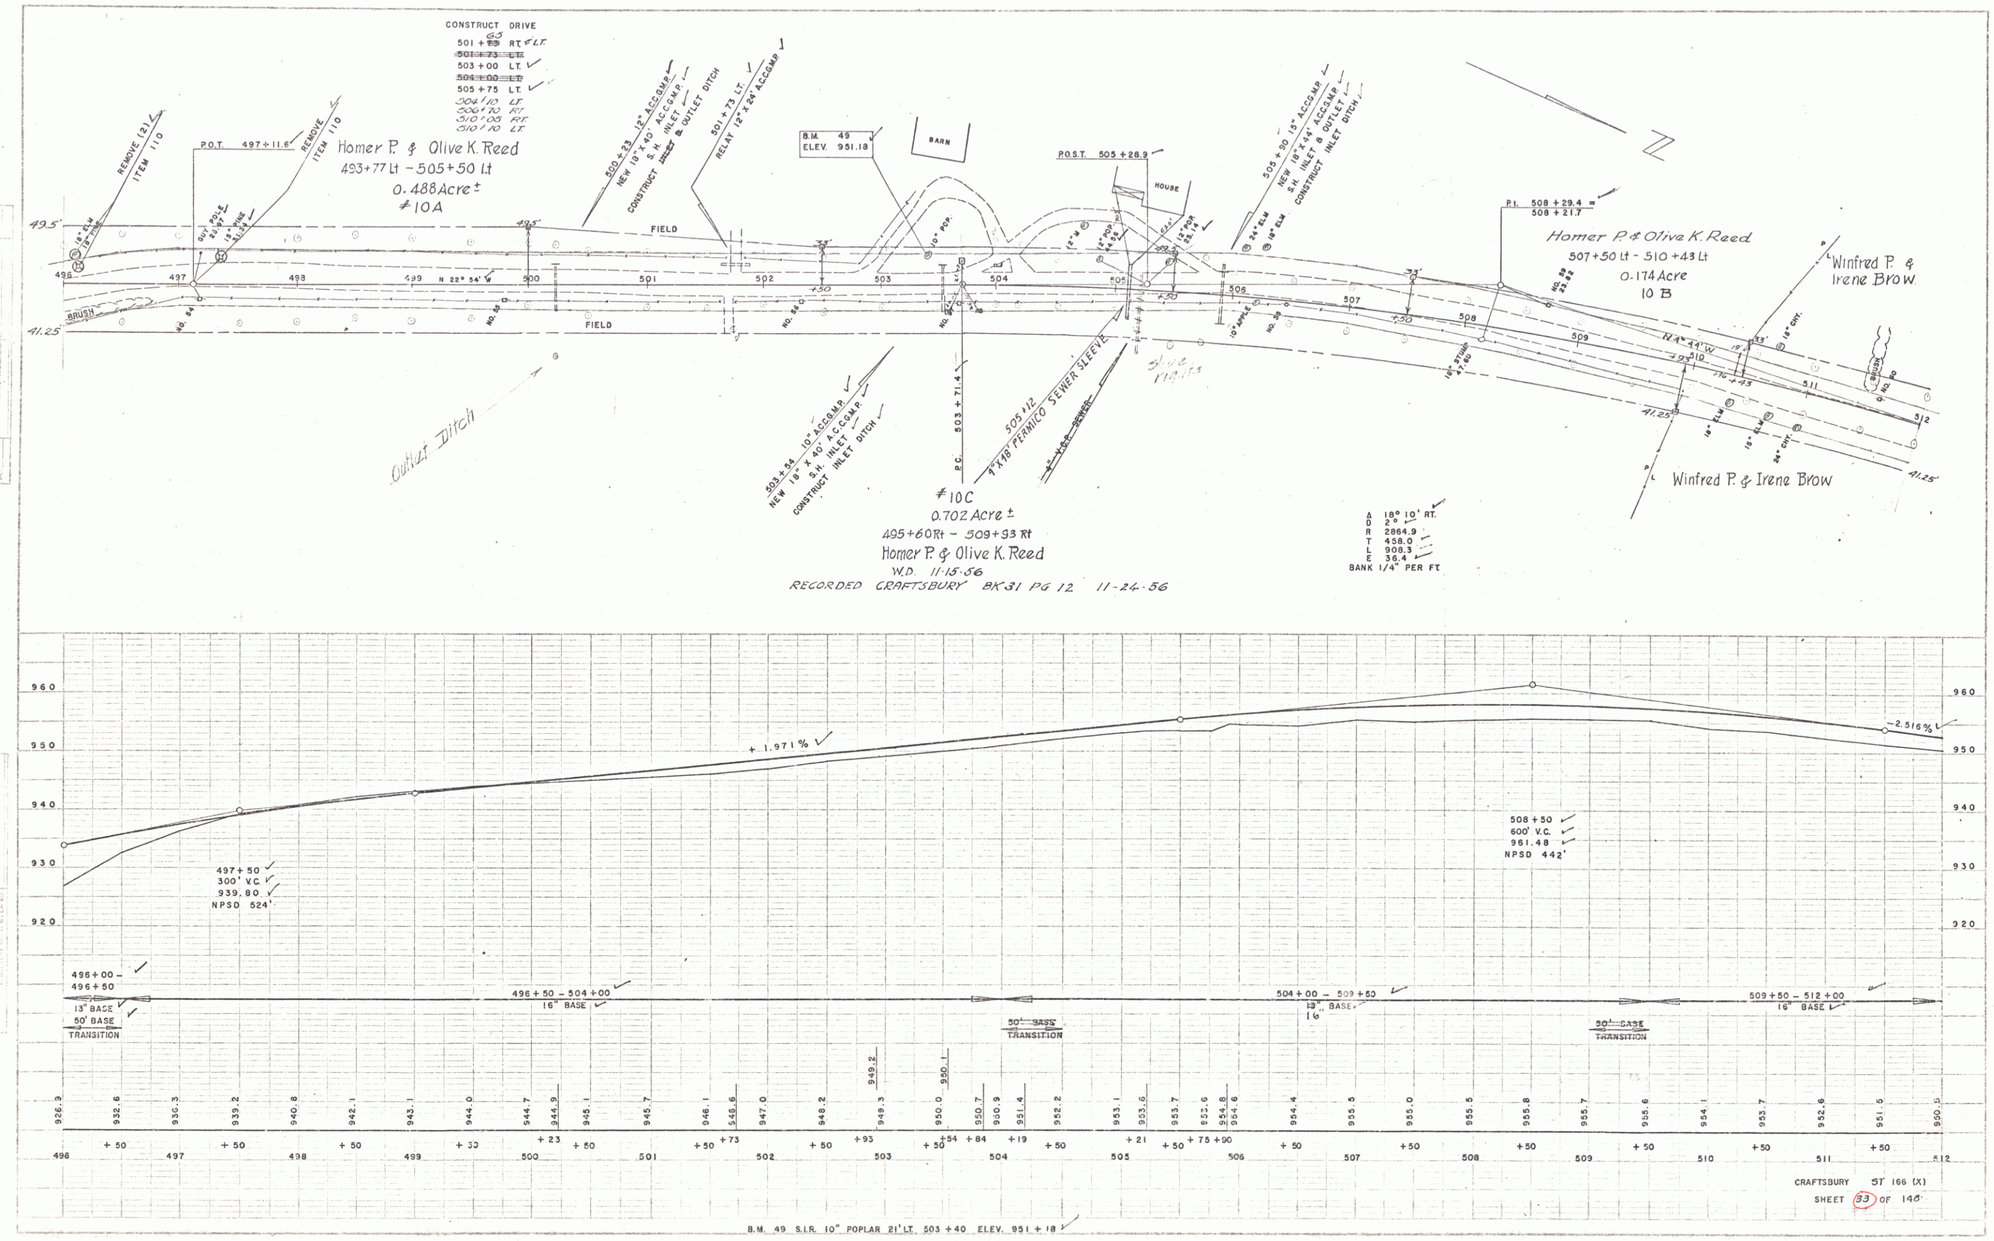

CRAFTSBURY ST 166 (X)

SHEET 33 OF 144

13