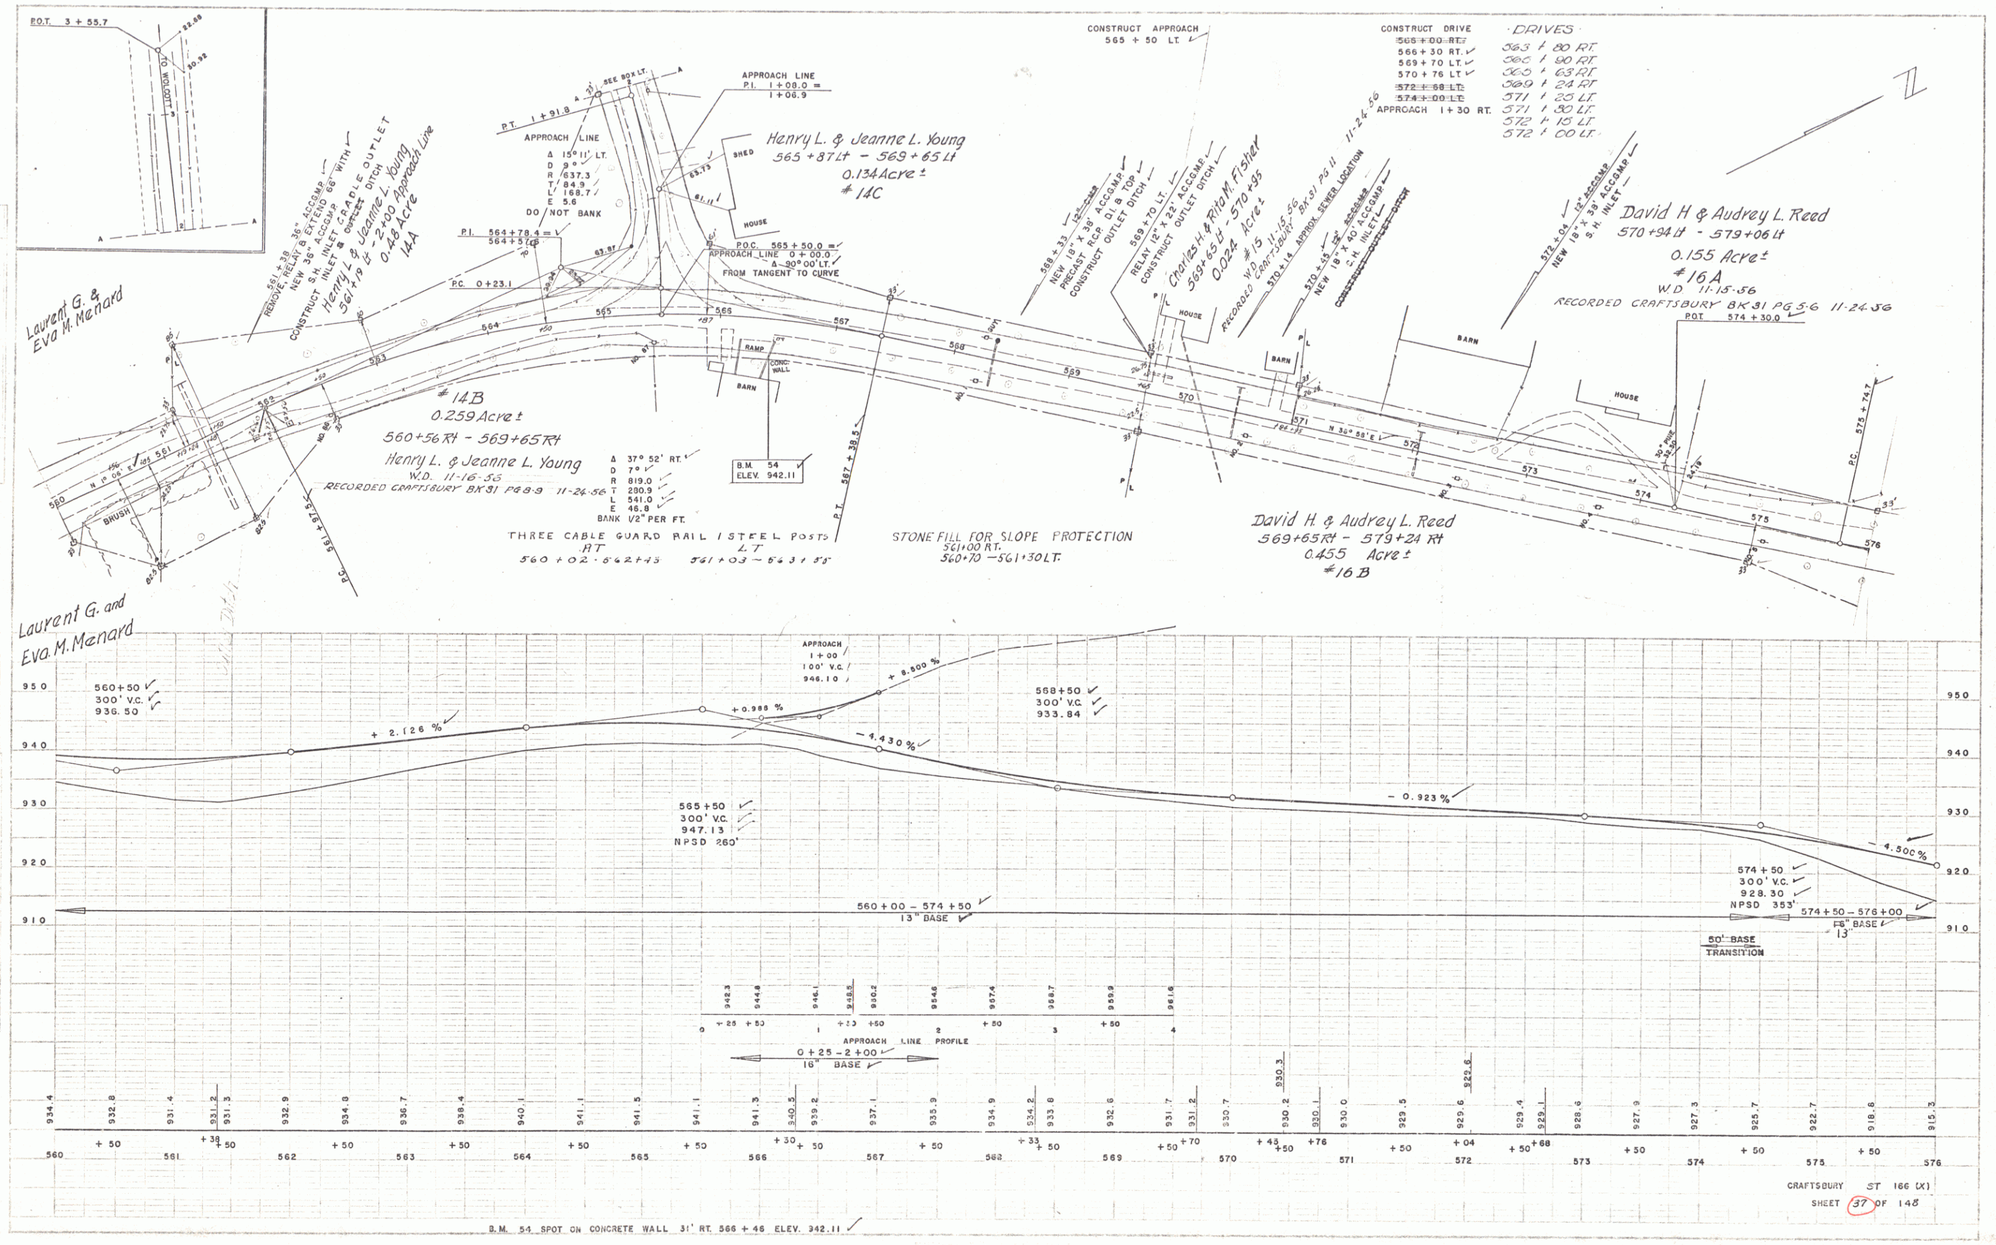
P.O.T. 3 + 55.7
TO WOLCOTT
APPROACH LINE
P.I. 1 + 08.0 = 1 + 06.9
P.T. 1 + 91.9
APPROACH LINE
Δ 15° 11' LT.
D 9°
R 637.3
T 84.9
L 168.7
E 5.6
DO NOT BANK
P.I. 564 + 78.4 = 564 + 57.6
P.C. 0 + 23.1
P.O.C. 565 + 50.0 =
APPROACH LINE 0 + 00.0
Δ 90° 00' LT.
FROM TANGENT TO CURVE
Henry L. & Jeanne L. Young
565 + 87 Lt - 569 + 65 Lt
0.134 Acre ±
#14C
Laurent G. & Eva M. Menard
#14B
0.259 Acre ±
560 + 56 Rt - 569 + 65 Rt
Henry L. & Jeanne L. Young
W.D. 11-16-56
RECORDED CRAFTSBURY BK 31 PG 8-9 11-24-56
Δ 37° 52' RT.
D 7°
R 819.0
T 280.9
L 541.0
E 46.8
BANK 1/2" PER FT.
B.M. 54
ELEV. 942.11
THREE CABLE GUARD RAIL I STEEL POSTS
RT
560 + 02 - 562 + 45
LT
561 + 03 - 563 + 55
STONE FILL FOR SLOPE PROTECTION
561+00 RT.
560+70 - 561+30 LT.
CONSTRUCT APPROACH
565 + 50 LT.
CONSTRUCT DRIVE
566 + 30 RT.
569 + 70 LT.
570 + 76 LT.
APPROACH 1 + 30 RT.
DRIVES
563 + 80 RT.
564 + 90 RT.
565 + 63 RT.
569 + 24 RT.
571 + 20 LT.
571 + 80 LT.
572 + 10 LT.
572 + 60 LT.
Charles H. & Rita M. Fisher
569 + 65 Lt - 570 + 35
0.024 Acre ±
#15
W.D. 11-15-56
RECORDED CRAFTSBURY BK 31 PG 11 11-24-56
David H. & Audrey L. Reed
570 + 94 Lt - 579 + 06 Lt
0.155 Acre ±
#16A
W.D. 11-15-56
RECORDED CRAFTSBURY BK 31 PG 5-6 11-24-56
P.O.T. 574 + 30.0
David H. & Audrey L. Reed
569 + 65 Rt - 579 + 24 Rt
0.455 Acre ±
#16B
Laurent G. and Eva M. Menard
N 36° 55' E
N
APPROACH
1 + 00
100' V.C.
946.10
+ 8.800 %
+ 2.126 %
+ 0.988 %
- 4.430 %
- 0.923 %
- 4.500 %
560 + 50
300' V.C.
936.50
568 + 50
300' V.C.
933.84
565 + 50
300' V.C.
947.13
NPSD 260'
574 + 50
300' V.C.
928.30
NPSD 353'
560 + 00 - 574 + 50
13" BASE
574 + 50 - 576 + 00
13"
50' BASE
TRANSITION
APPROACH LINE PROFILE
0 + 25 - 2 + 00
16" BASE
B.M. 54 SPOT ON CONCRETE WALL 31' RT. 566 + 46 ELEV. 942.11
CRAFTSBURY ST 166 (X)
SHEET 37 OF 148

17