

PLAN
 SURVEYED: _____
 DATE: _____
 NOTE BOOK: _____
 DRAWING CHECKED: _____
 BY: _____

PROFILE
 SURVEYED: _____
 DATE: _____
 NOTE BOOK: _____
 DRAWING CHECKED: _____
 BY: _____

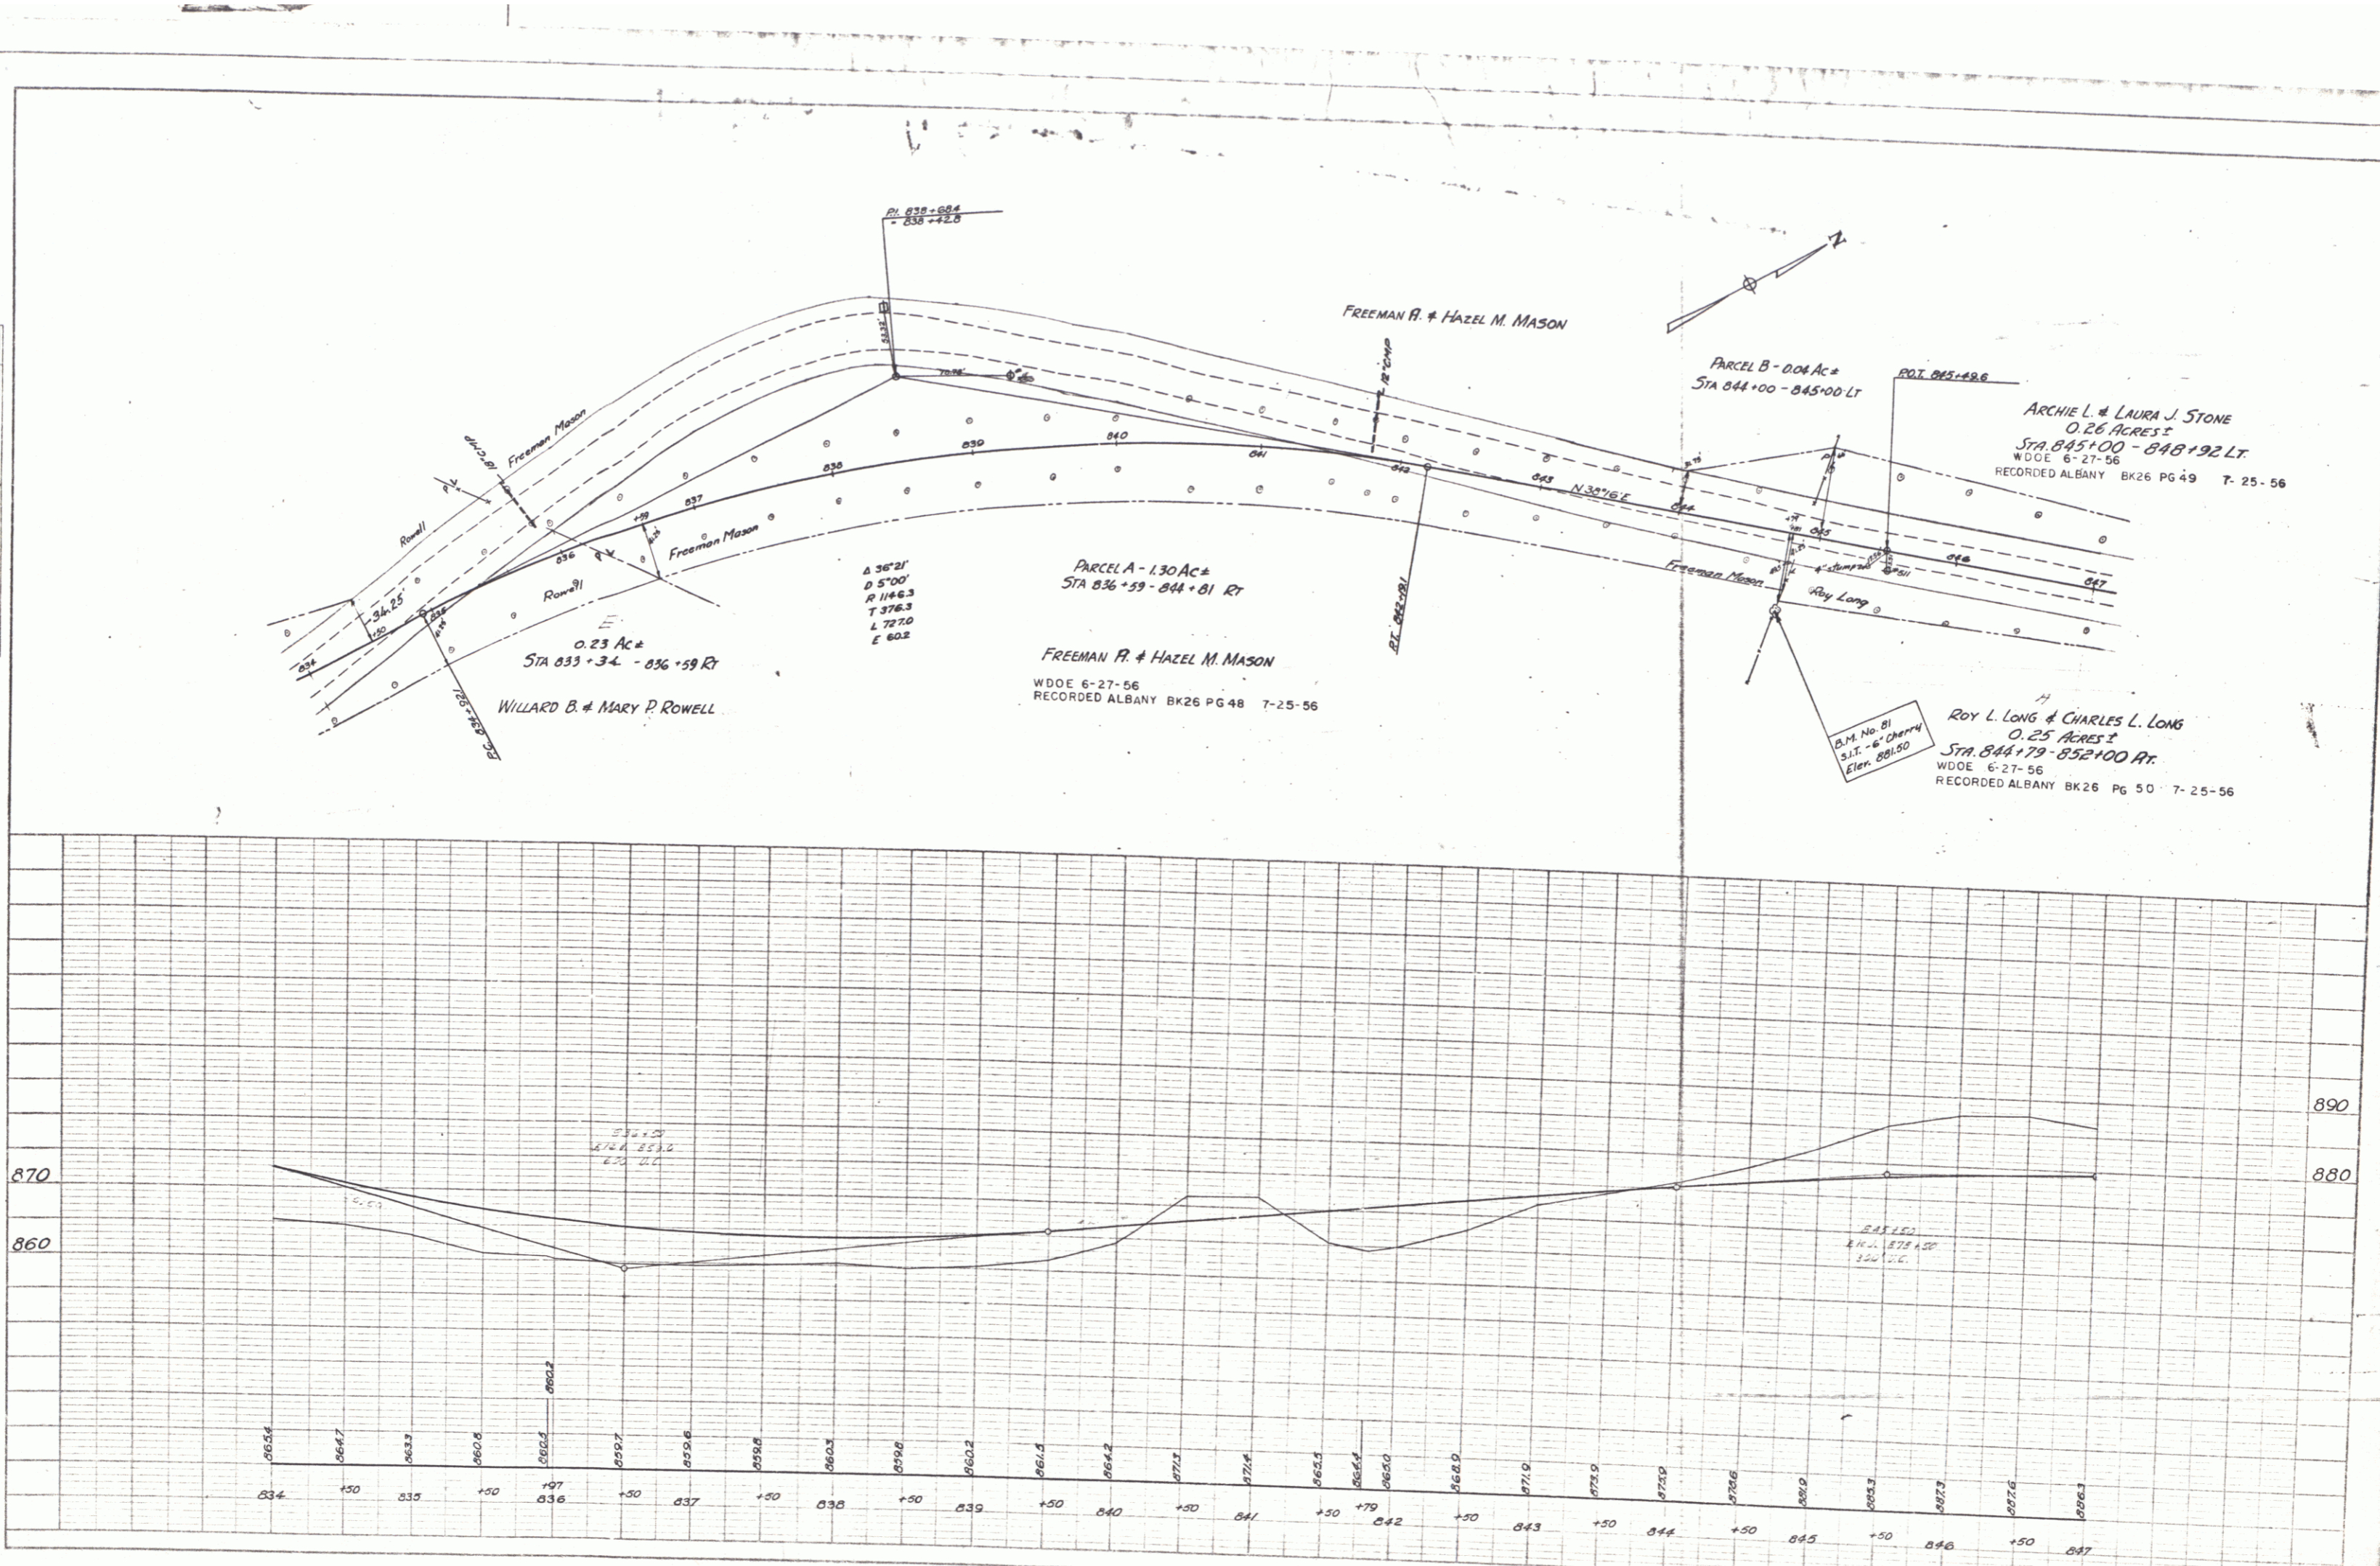


PLATE 1 - PLAN PROFILE C.P. & A.S. STANDARD
