WPSS
166-B 1936 4

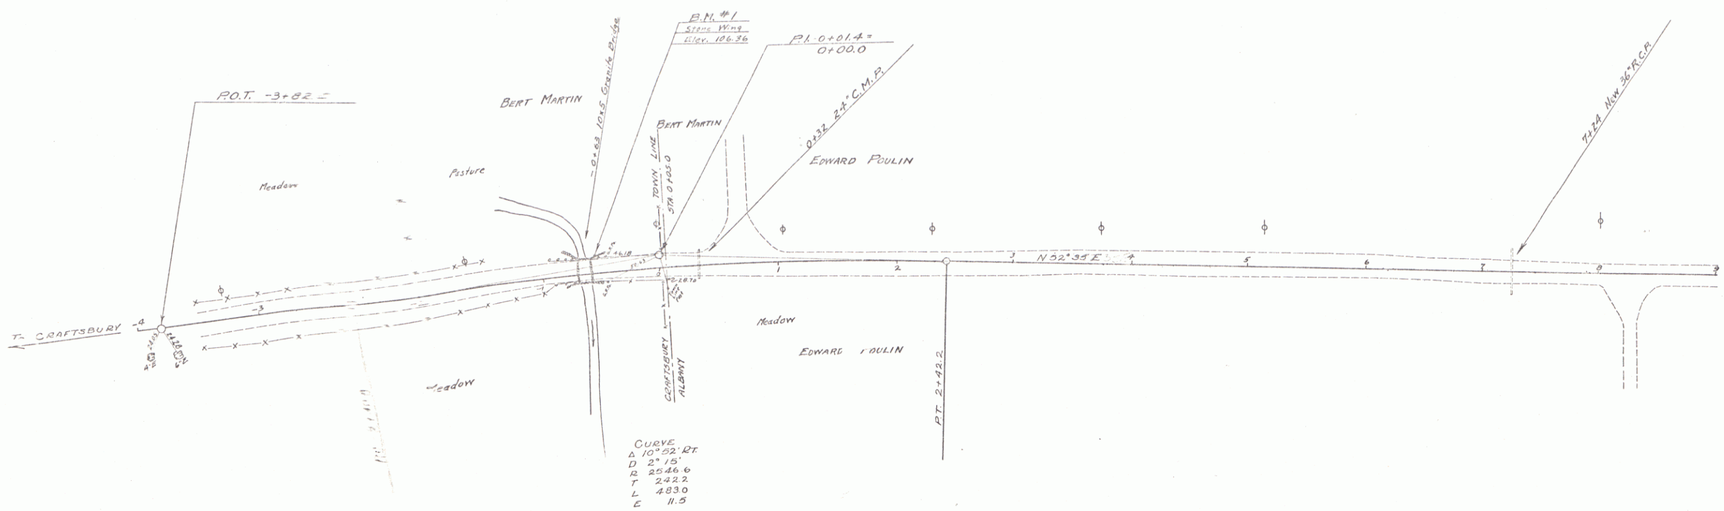

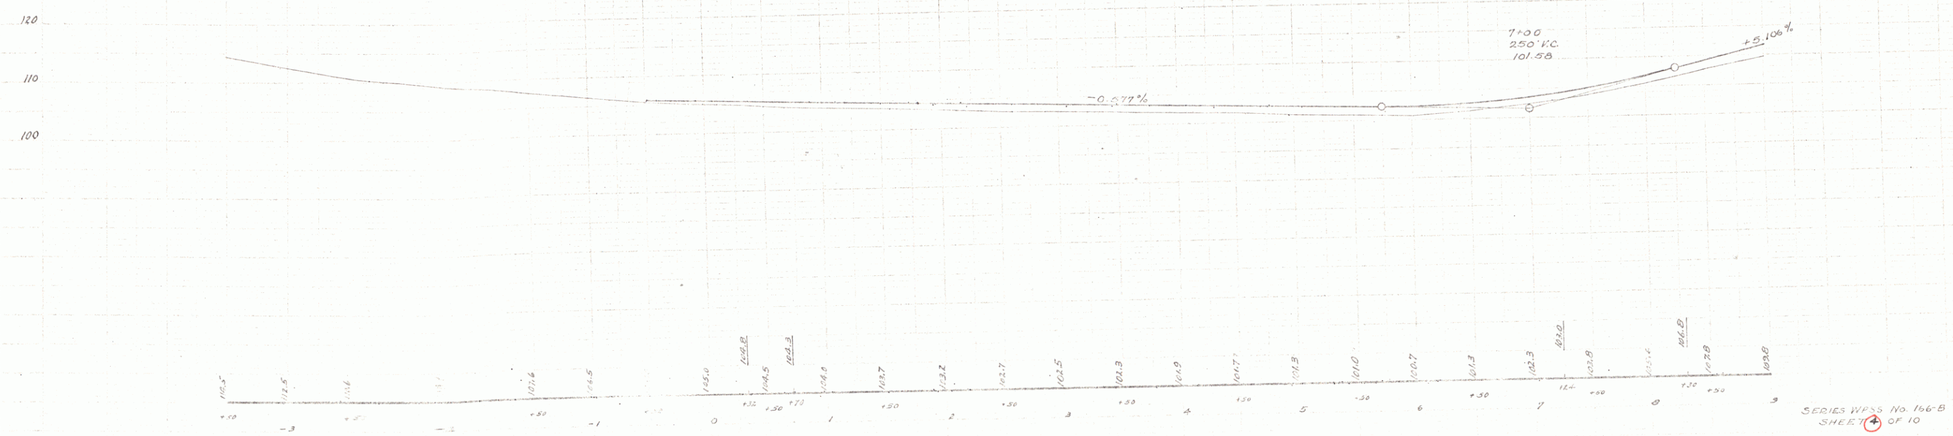

SERIES WPSS No. 166-B
SHEET 4 OF 10

BARRETT CONE 11/1/35 11/1/35
CONE 11/1/35
TRACED
BARRETT CONE 11/1/35 11/1/35

2