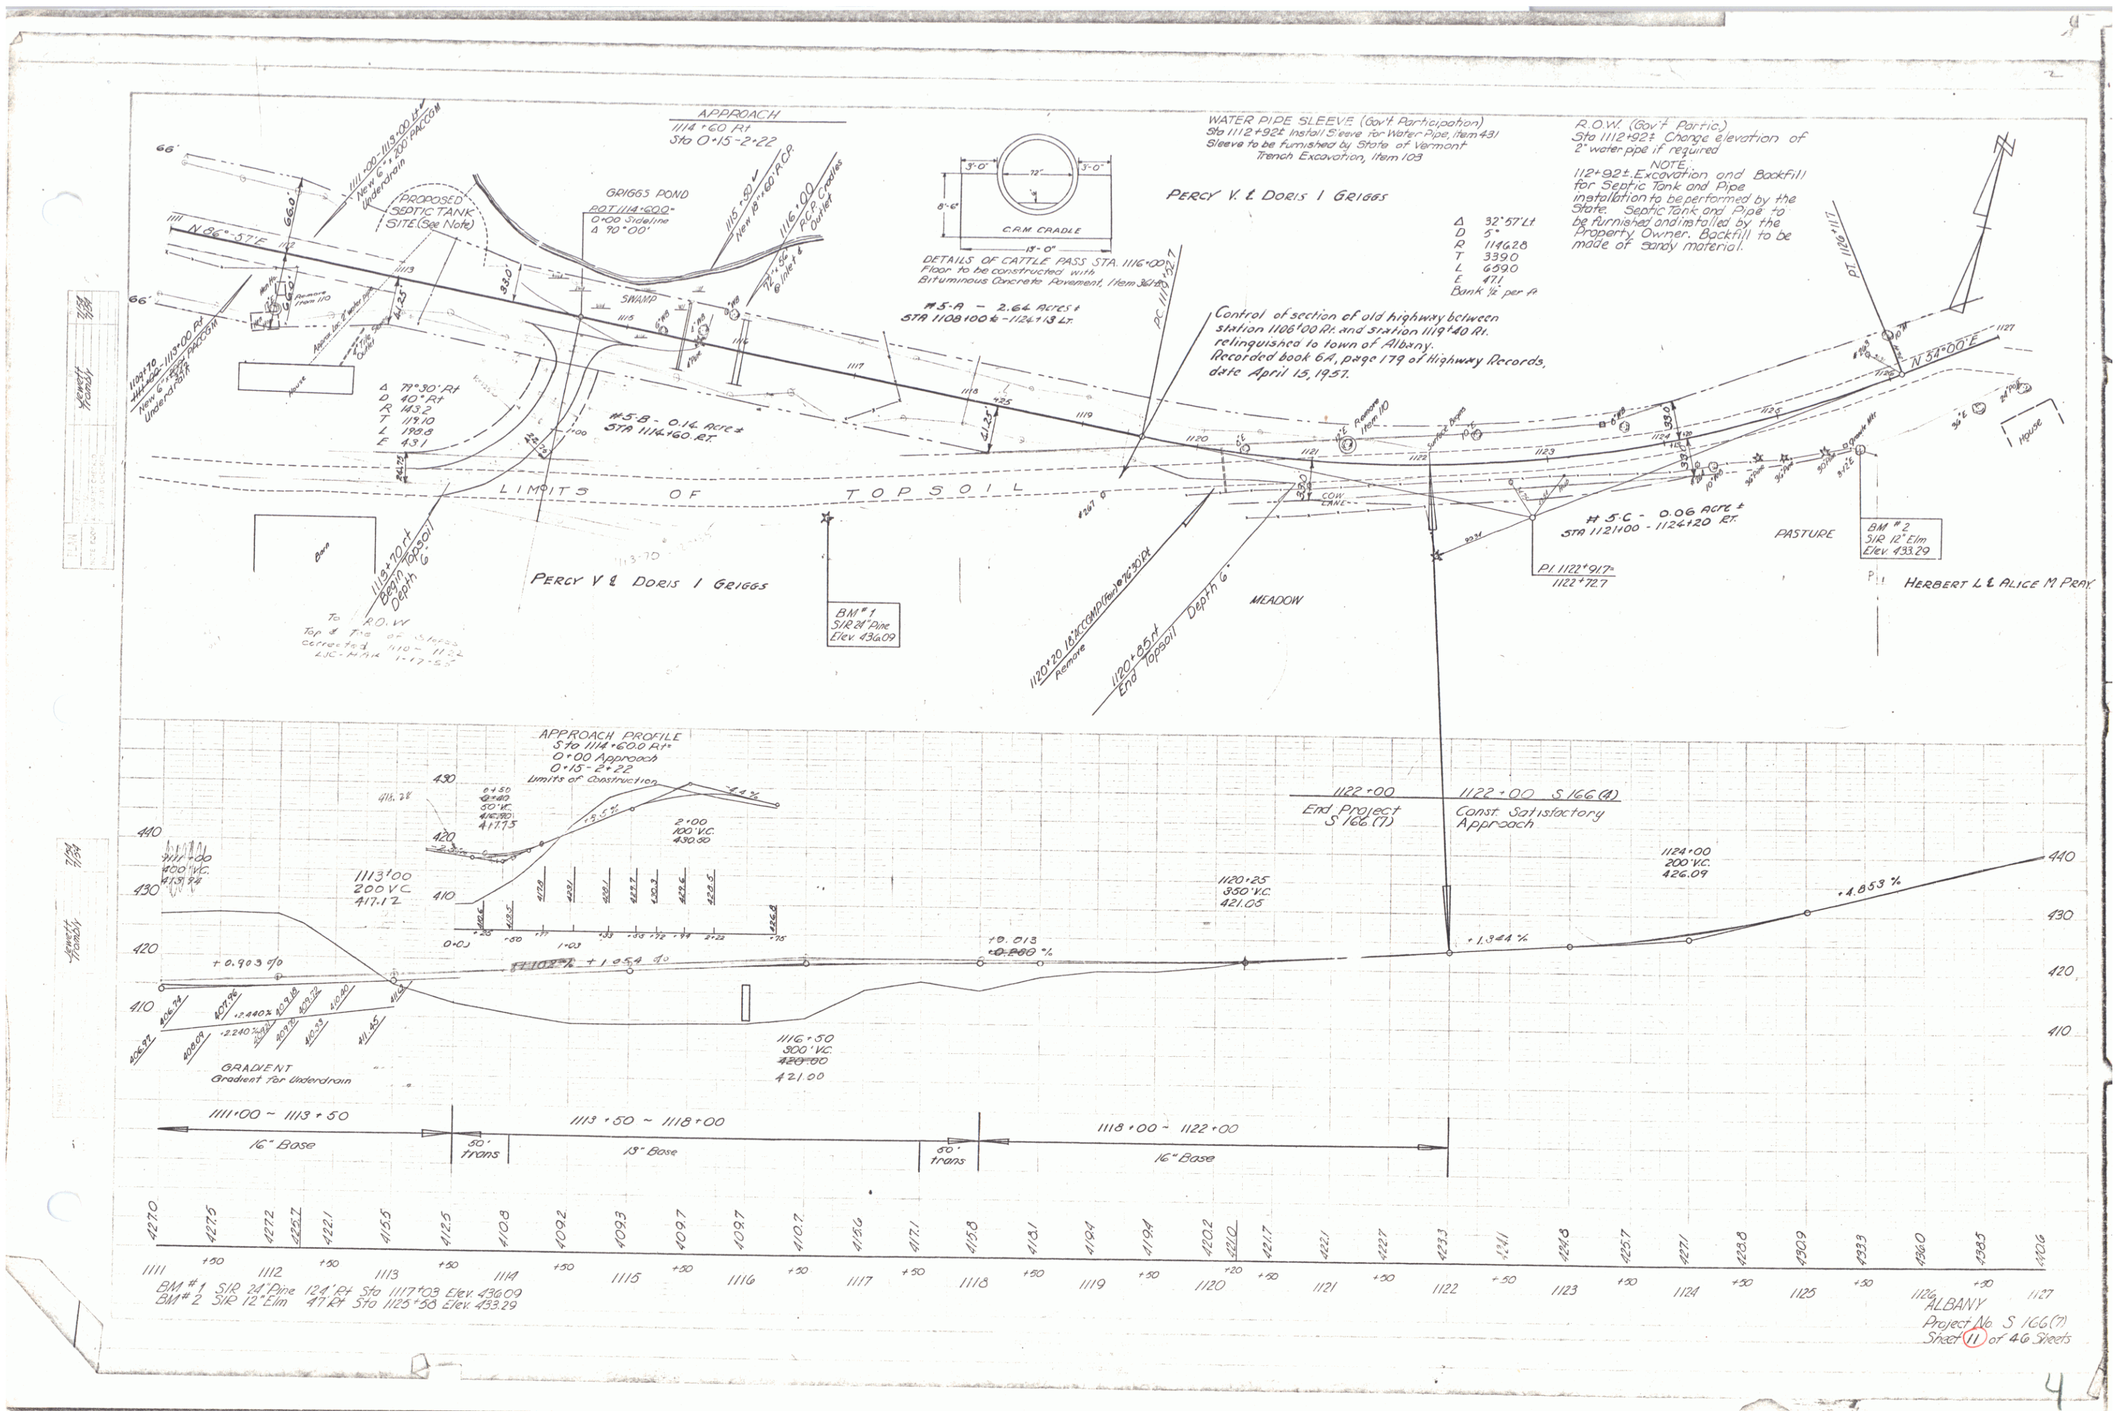

ALBANY
Project No S 166(7)
Sheet 11 of 46 Sheets