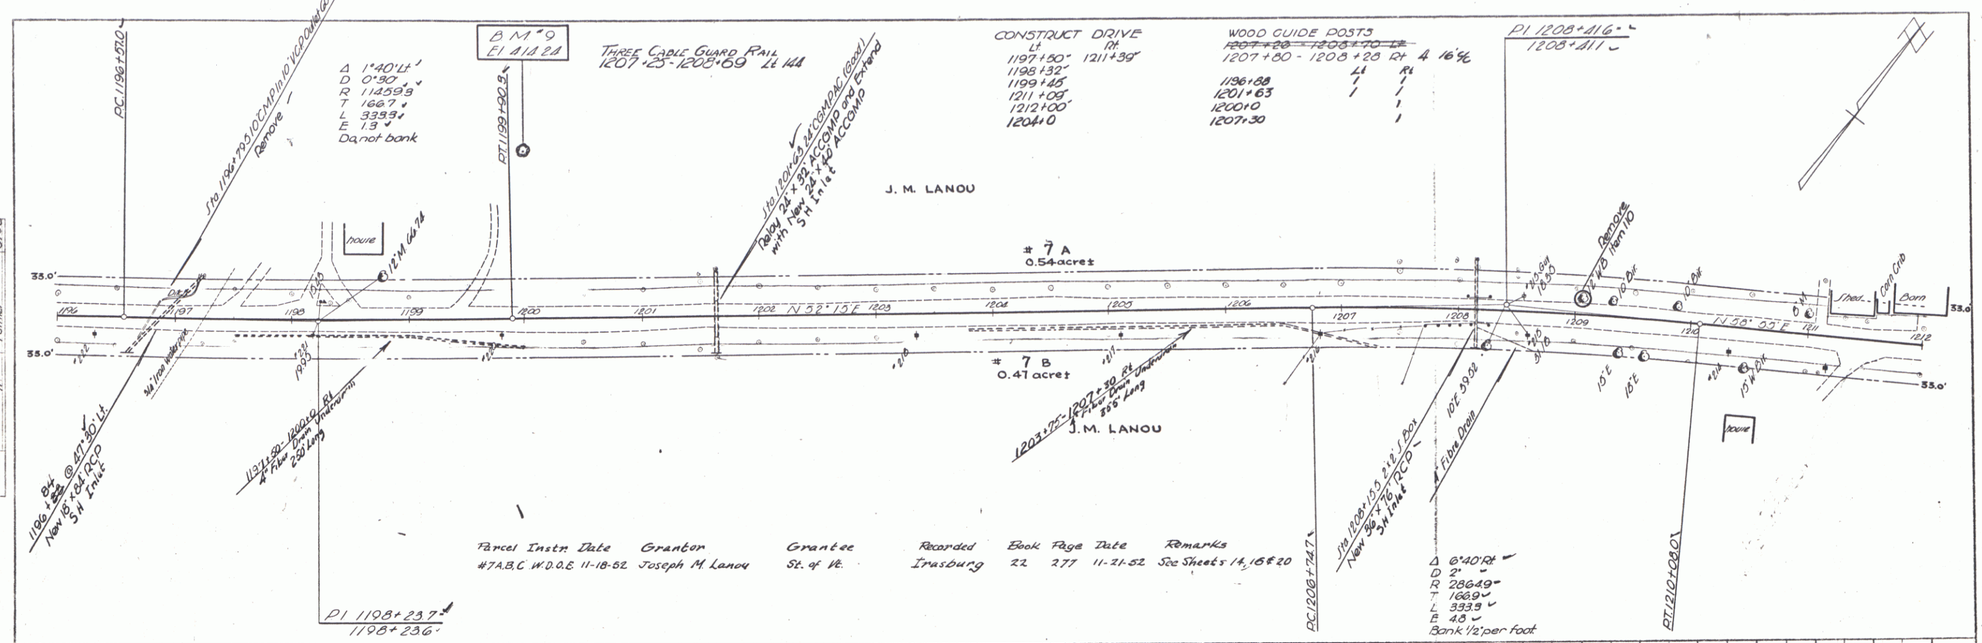
BM #9
El 414.24
Three Cable Guard Rail
1207+25-1208+69 Lt 14.4
PC 1196+51.0
Remove
Δ 1°40' Lt
D 0°30'
R 1145.93
T 16.67
L 33.39
E 1.3
Do not bank
house
J. M. LANOU
7 A
0.54 acre±
7 B
0.41 acre±
J. M. LANOU
N 52° 15' E
N 50° 07' E
Construct Drive
Lt Rt
1197+50 1211+39
1198+32
1199+45
1211+08
1212+00
1204+0
Wood Guide Posts
1207+80 - 1208+28 Rt & 16%
Lt Rt
1196+88 1 1
1201+63 1 1
1200+0 1
1207+30 1
PI 1208+41.6
1208+41.1
Remove Item 10
Shed
Cow Crib
Barn
Fibre Drain
Parcel Instr. Date Grantor Grantee Recorded Book Page Date Remarks
#7A,B,C W.D.D.E 11-18-52 Joseph M. Lanou St. of Vt. Irasburg 22 277 11-21-52 See Sheets 14, 16 & 20
PI 1198+23.7
1198+23.6
PC 1208+74.7
Δ 6°40' Rt
D 2°
R 2864.9
T 168.9
L 333.9
E 4.3
Bank 1/2' per foot
PT 1210+08.0
-1.263%
-1.264%
-1.020%
-0.829%
-0.362%
420
410
Grade 4" Underdrain
1204+25
300' VC
416.95
1196+10-1197+50
18" Base
50' Base Trans
1197+50 - 1199+0
24" Base
1199+0 - 1204+0
18" Base
1204+0 - 1206+0
24" Base
1206+0 - 1212+0
18" Base
BM #9 147 FLt Sta 1200+00 S1R 12" Maple Elevation 414.24
ALBANY - IRASBURG
Project S No. 166(A)
Sheet 13 of 63

7