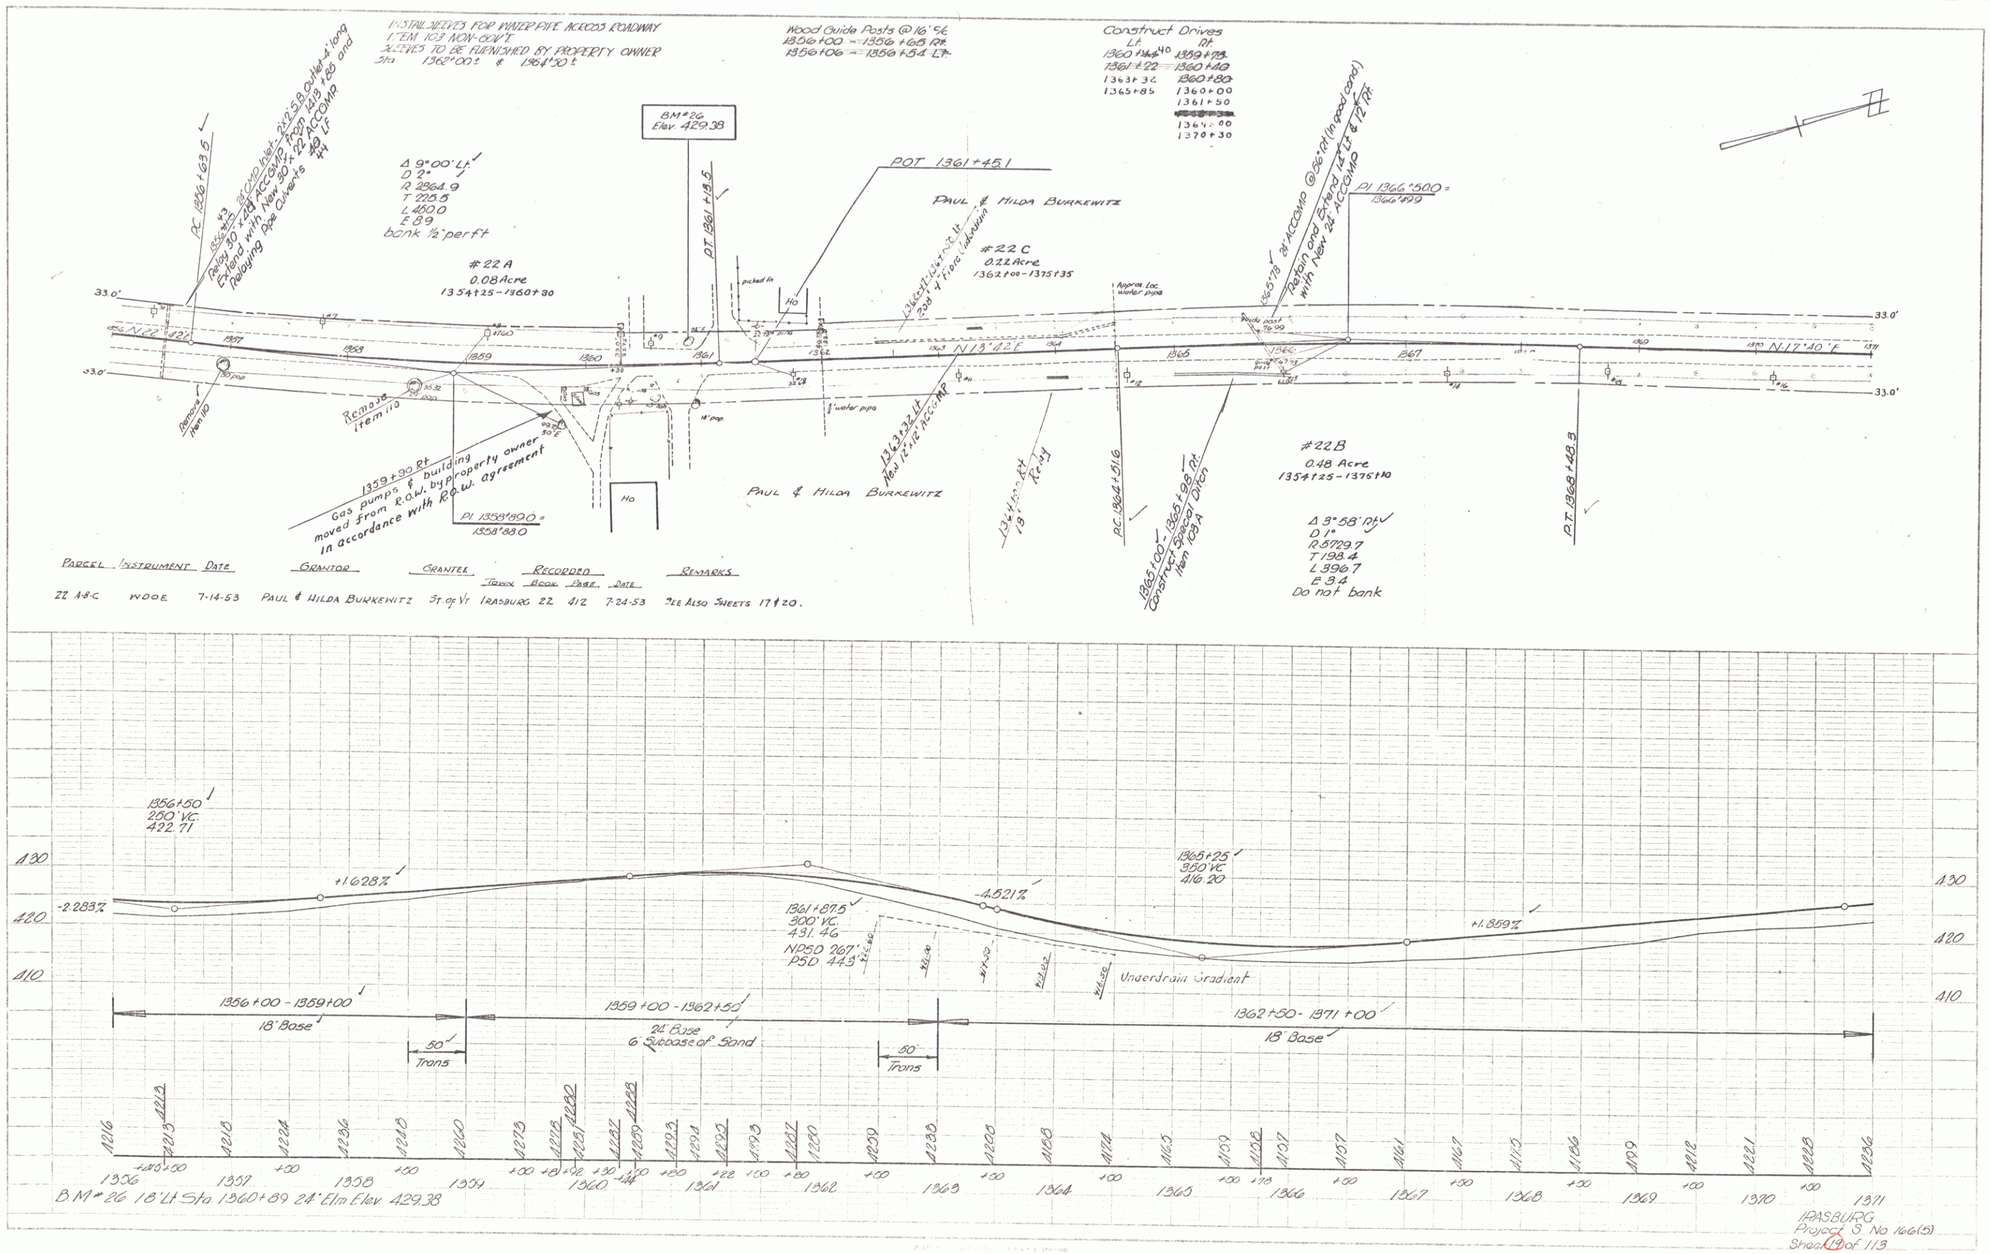
INSTALL SLEEVES FOR WATER PIPE ACROSS ROADWAY
ITEM 103 NON-COM'T
SLEEVES TO BE FURNISHED BY PROPERTY OWNER
Sta 1362+00± & 1364+50±
Wood Guide Posts @ 16' S.E.
1356+00 = 1356+69 Rt
1356+06 = 1356+54 Lt
Construct Drives
Lt Rt
1360+40 1359+75
1361+22 1360+40
1363+32 1360+80
1365+85 1360+00
1361+50
1364+00
1370+30
BM #26
Elev. 429.38
POT 1361+45.1
Paul & Hilda Burkewitz
#22 A
0.08 Acre
1354+25-1360+30
#22 C
0.22 Acre
1362+00-1375+35
#22 B
0.48 Acre
1354+25-1375+10
Remove Item 110
Remove Item 10
1359+90 Rt
Gas pumps & building moved from R.O.W. by property owner in accordance with R.O.W. agreement
PI 1358+89.0 =
1358+88.0
PI 1366+50.0 =
1366+99
N 22° 42' E
N 13° 42' E
N 17° 40' E
33.0'
Approx. Loc. water pipe
Rebuild and Extend 14' Lt & 12' Rt with New 24" ACCOMP
Construct Special Ditch Item 103A
Δ 9°00' Lt
D 2°
R 2864.9
T 225.5
L 450.0
E 8.9
bank ½" per ft
Δ 9°58' Rt
D 1°
R 5729.7
T 198.4
L 396.7
E 3.4
Do not bank
PARCEL INSTRUMENT DATE GRANTOR GRANTEE RECORDED TOWN BOOK PAGE DATE REMARKS
22 A-B-C WDOE 7-14-53 PAUL & HILDA BURKEWITZ ST. OF VT. IRASBURG 22 412 7-24-53 SEE ALSO SHEETS 17 & 20.

1356+50
250' VC
422.71
+1.628%
-2.283%
1361+87.5
300' VC
431.46
NPSD 267'
PSD 443'
-4.521%
1365+25
350' VC
416.20
+1.869%
Underdrain Gradient
1356+00 - 1359+00
18' Base
50' Trans
1359+00 - 1362+50
24' Base
6" Subbase of Sand
1362+50 - 1371+00
18' Base
BM #26 18' Lt Sta 1360+89 24' Elm Elev 429.38
IRASBURG
Project S. No 166(5)
Sheet 19 of 113

7