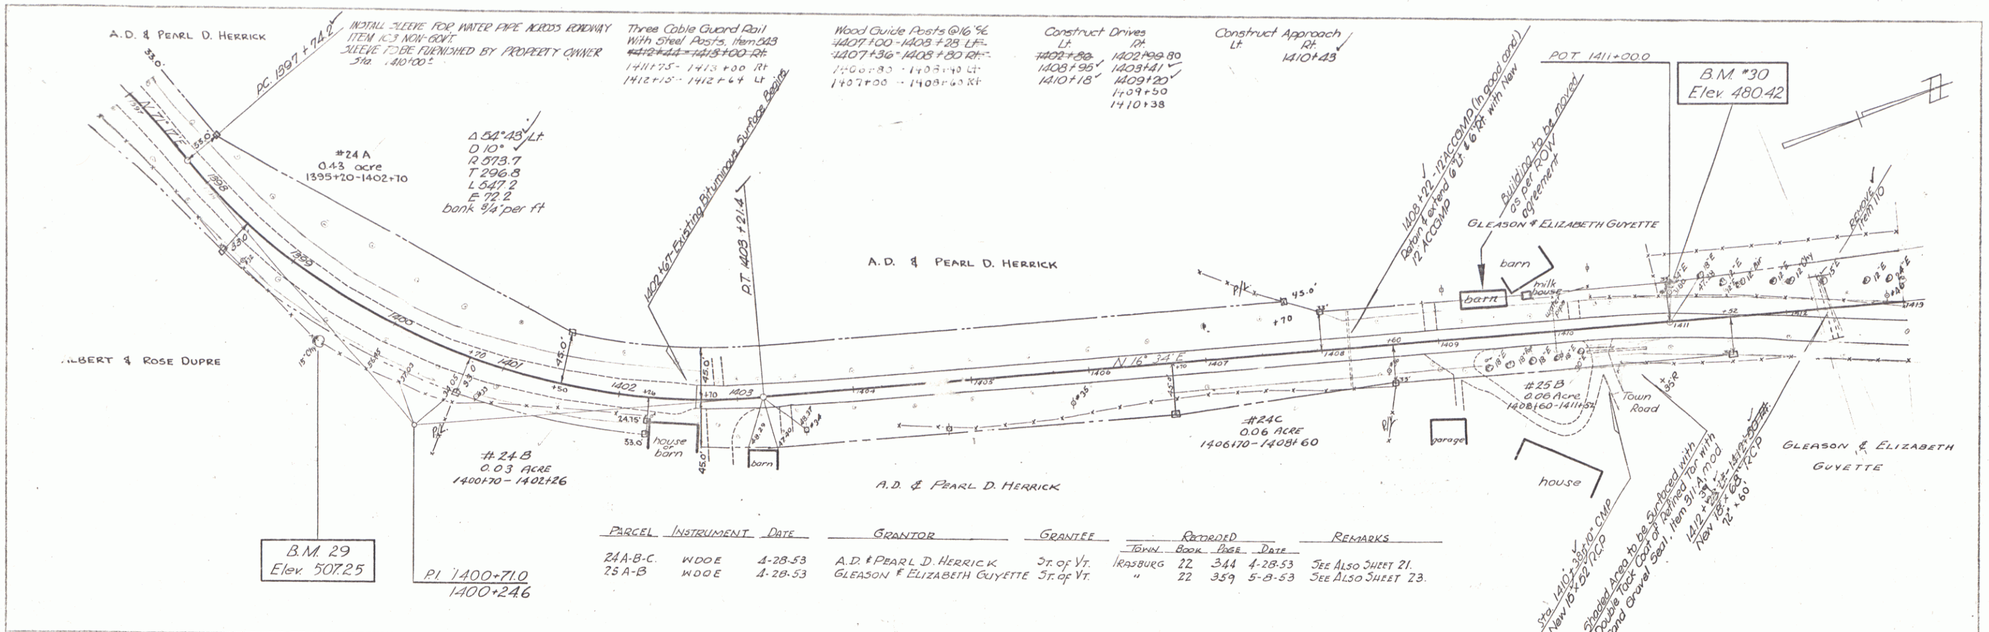

Parcel	Instrument	Date	Grantor	Grantee	Recorded Town	Book	Page	Date	Remarks
24 A-B-C.	WDOE	4-28-53	A.D. & Pearl D. Herrick	St. of Vt.	Irasburg	22	344	4-28-53	See Also Sheet 21.
25 A-B	WDOE	4-28-53	Gleason & Elizabeth Guyette	St. of Vt.	"	22	359	5-8-53	See Also Sheet 23.

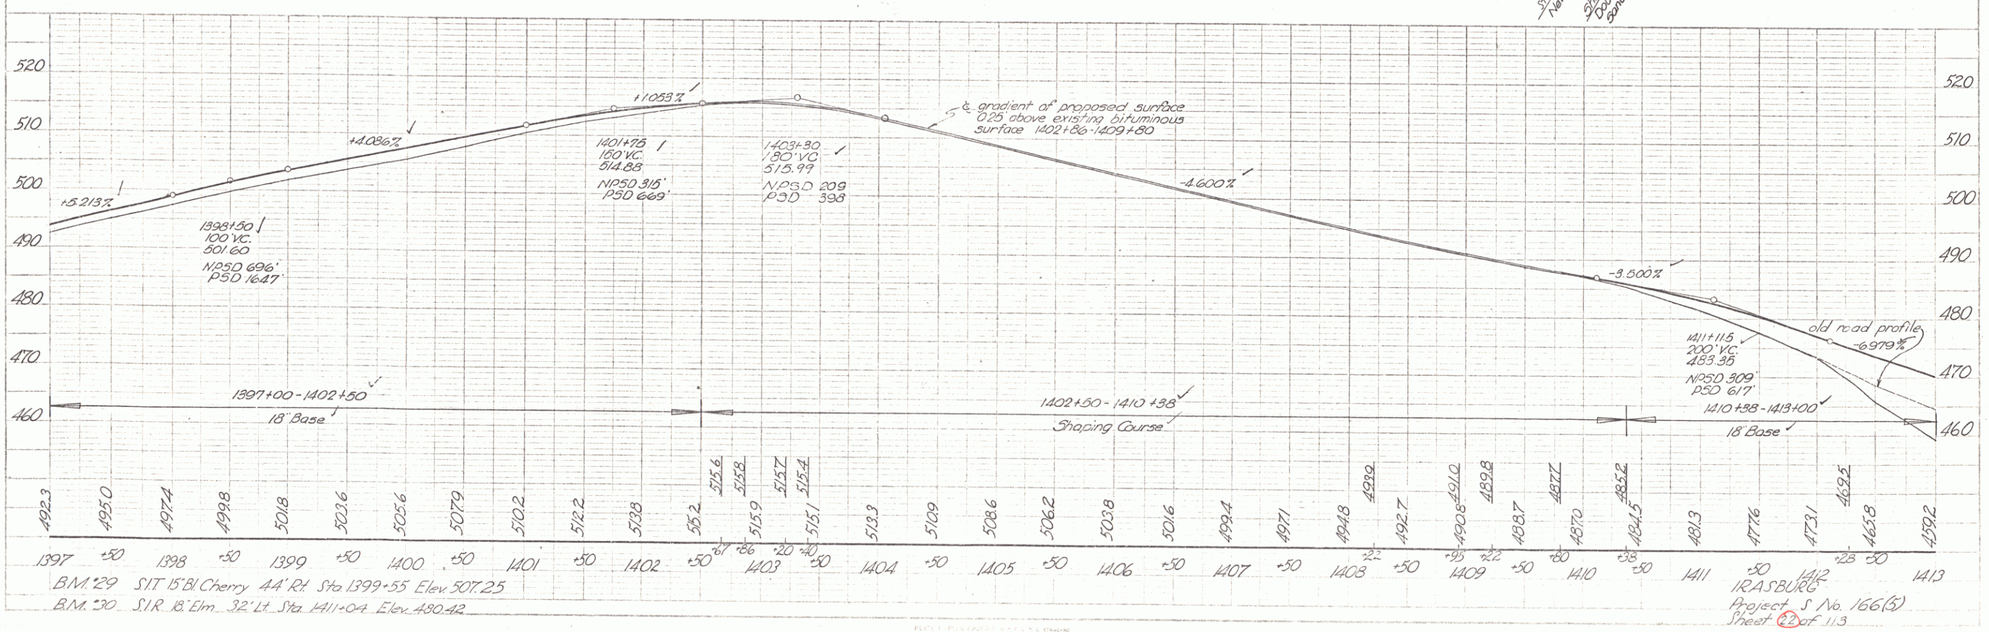

Irasburg
Project S No. 166(5)
Sheet 22 of 113