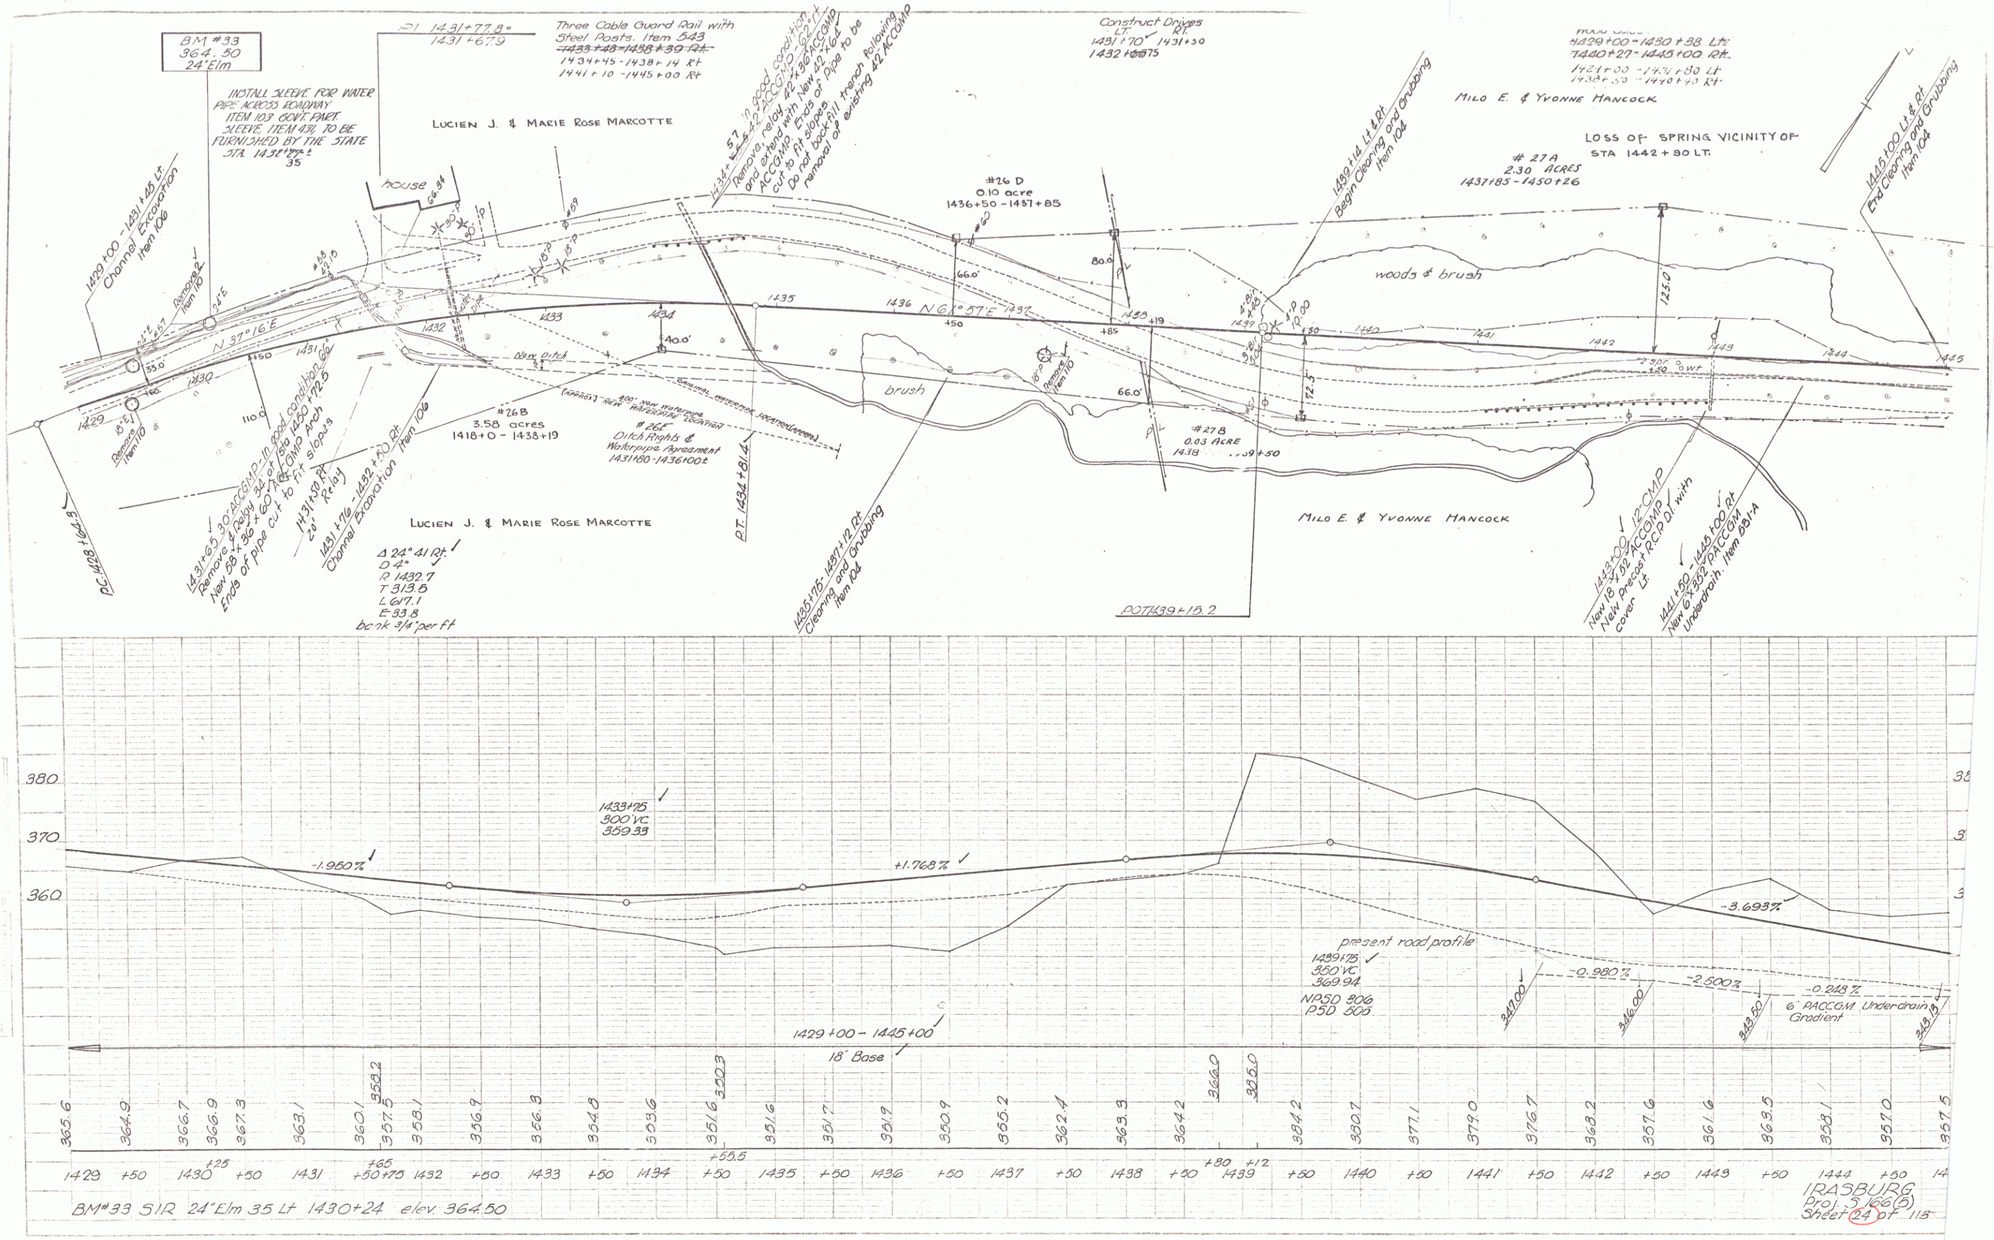
BM #33
364.50
24" Elm
INSTALL SLEEVE FOR WATER PIPE ACROSS ROADWAY ITEM 103 GOVT. FURNT. SLEEVE ITEM 431 TO BE FURNISHED BY THE STATE STA. 1431+77 Lt
35
PI 1431+77.8 = 1431+67.9
Three Cable Guard Rail with Steel Posts, Item 543
1434+45 - 1438+14 Rt
1441+10 - 1445+00 Rt
LUCIEN J. & MARIE ROSE MARCOTTE
house
Remove, relay and extend 42" ACCOMP. Grade to fit New 42" ACCOMP. Ends of Pipe to be cut to fit slopes, trench following Do not backfill around 42" ACCOMP
Construct Drives
1431+70 1431+50
1432+75
#26 D
0.10 acre
1436+50 - 1437+85
Milo E. & Yvonne Mancock
LOSS OF SPRING VICINITY OF STA 1442+80 LT.
#27A
2.30 ACRES
1437+85 - 1450+26
Begin Cleaning and Grubbing Item 104
End Cleaning and Grubbing Item 104
1429+00 - 1431+88 Lt
Channel Excavation Item 106
Remove Item 18
Remove Item 10
N 37° 16' E
N 61° 57' E
New ditch
Channel excavation (location)
400' New Waterway New Waterside Location
#25F
Ditch Rights & Waterpipe Agreement
1431+50 - 1436+00 Lt
#26B
3.58 acres
1418+0 - 1438+19
#27B
0.03 ACRE
1438
brush
woods & brush
125.0
72.5
80.0
66.0'
40.0'
110.0
1431+93 30" ACCOMP in good condition
Remove 1 body 36" of 50 ACCOMP Arch
New 59+36 + 60 ft ACCOMP Arch
Ends of pipe cut to fit slopes
1431+39 Rt
20 Rt
1431+76 - 1432+50 Rt
Channel Excavation Item 106
LUCIEN J. & MARIE ROSE MARCOTTE
Δ 24° 41 Rt
D 4°
R 1430.7
T 313.5
L 617.1
E 33.8
bank 3/4 per ft
P.T. 1434+81.4
1435+75 - 1437+12 Rt
Cleaning and Grubbing Item 104
POT 1439+15.2
MILO E. & YVONNE MANCOCK
1439+00 12" CMP
New 18.32 ACCOMP
New Grade + RCP DI with cover Lt
1441+50 - 1448+00 Rt
New 6" 332' PACCOM Underdrain Item 881A
POT 1429+00 - 1450+38 Lt
1420+27 - 1445+00 Rt
1421+00 - 1431+80 Lt
1438+50 - 1440+40 Rt
1429 1430 1431 1432 1433 1434 1435 1436 1437 1438 1439 1440 1441 1442 1443 1444 1445
380
370
360
1433+75
300 VC
369.33
-1.950%
+1.768%
-3.693%
present road profile
1439+75
350 VC
369.94
NPSD 306
PSD 500
-0.980%
-2.600%
-0.248%
6" PACCOM Underdrain Gradient
347.00
346.00
343.50
343.15
1429+00 - 1445+00
18" Base
365.6 364.9 366.7 366.9 367.3 363.1 360.1 358.2 357.5 358.1 356.9 356.8 354.8 353.6 351.6 350.3 351.6 351.7 351.9 350.9 355.2 362.4 363.3 364.2 366.0 365.0 384.2 380.7 377.1 379.0 376.7 363.2 357.6 361.6 363.5 358.1 357.0 357.5
1429 +50 1430 +25 +50 1431 +50 +75 +65 1432 +50 1433 +50 1434 +50 +55.5 1435 +50 1436 +50 1437 +50 1438 +50 +30 1439 +12 +50 1440 +50 1441 +50 1442 +50 1443 +50 1444 +50 14
BM #33 S/R 24" Elm 35 Lt 1430+24 elev. 364.50
IRASBURG
Proj. 5.66(3)
Sheet 24 of 115