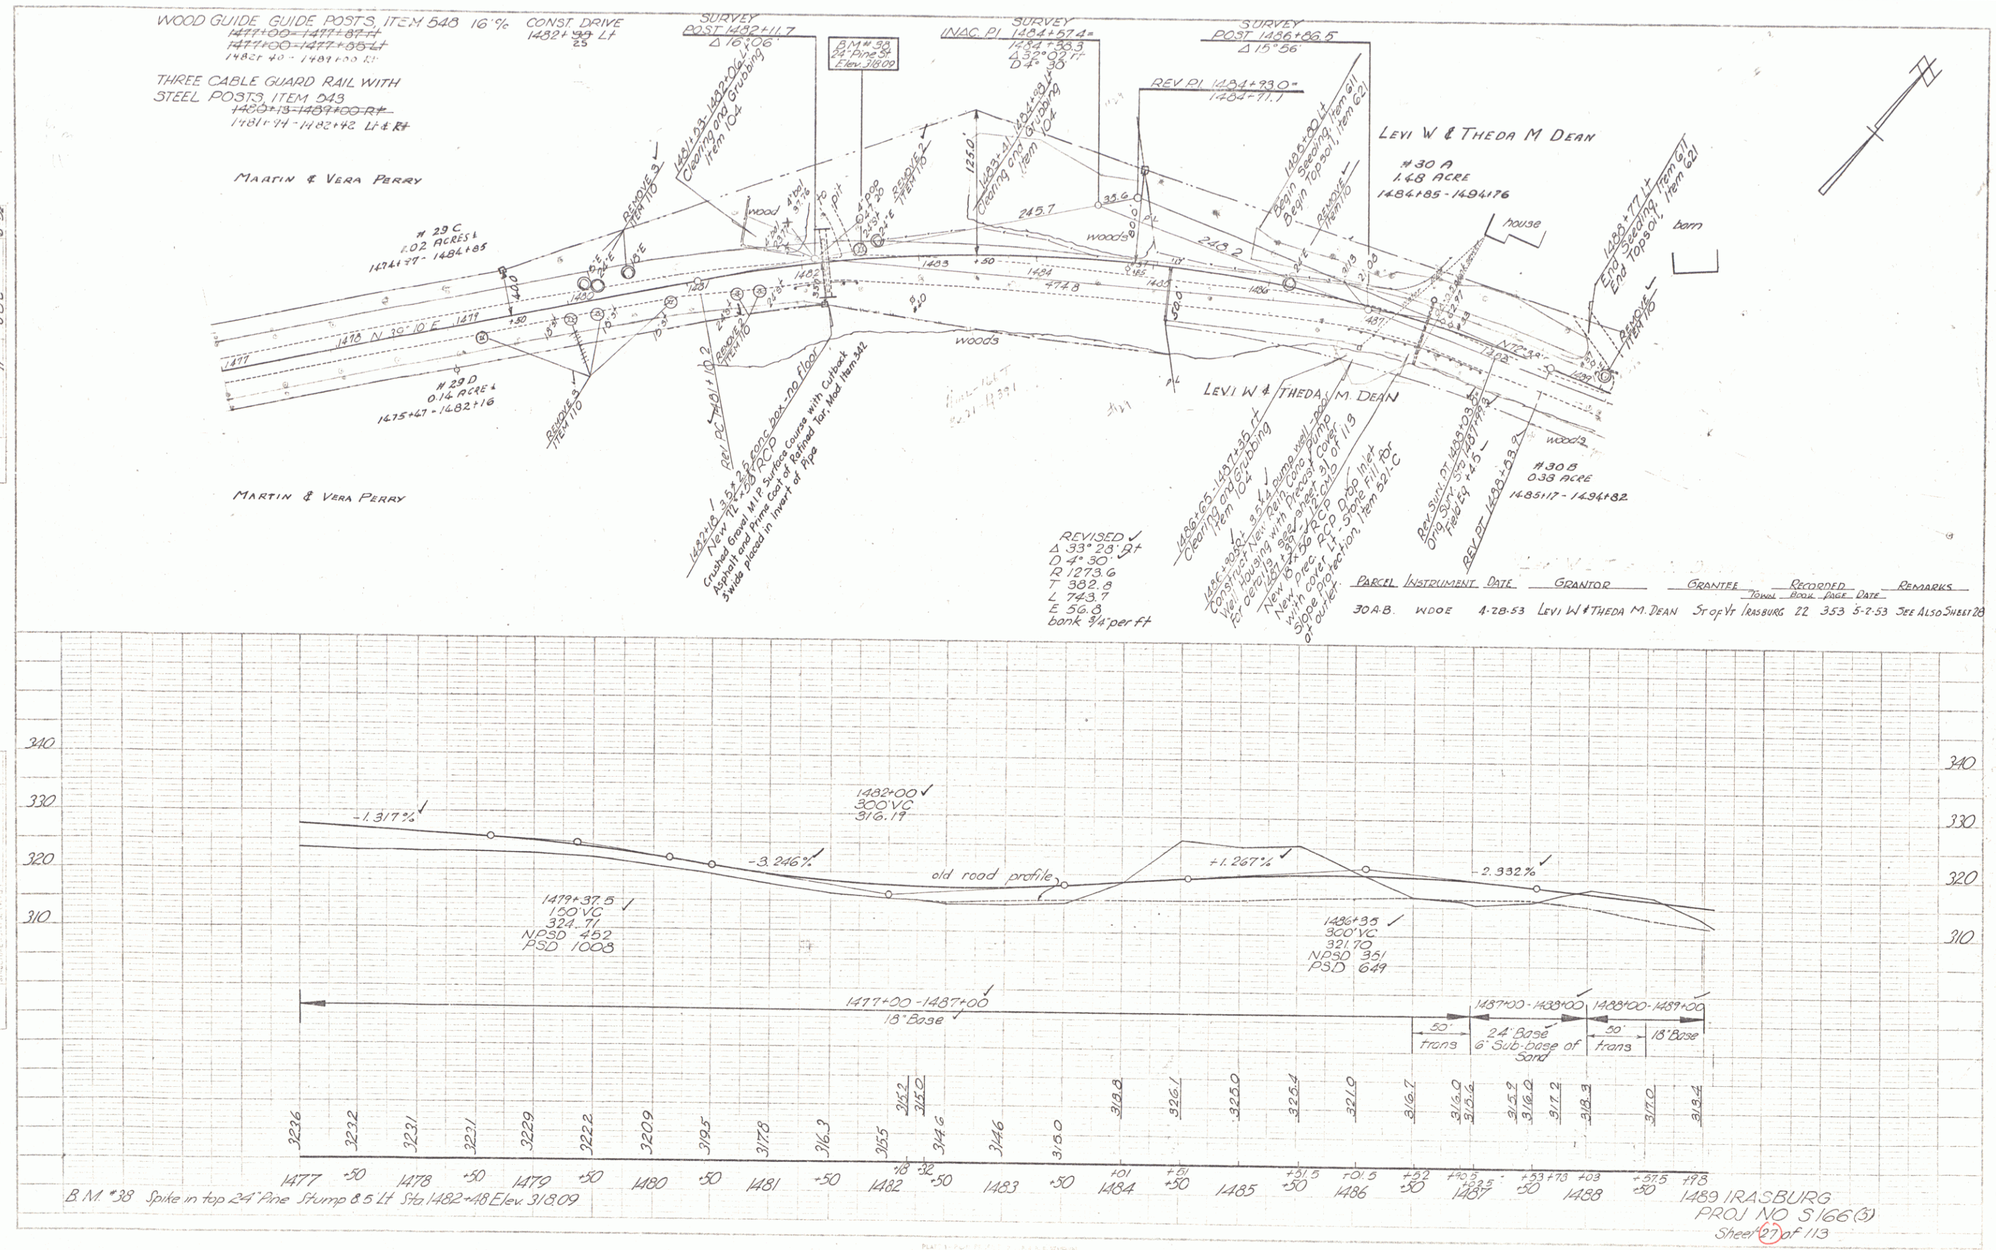
WOOD GUIDE GUIDE POSTS, ITEM 548 16'%
~~1477+00 - 1477+87 Rt~~
~~1477+00 - 1477+35 Lt~~
1482+40 - 1481+00 Rt
CONST DRIVE
1482+ 22 Lt
25
THREE CABLE GUARD RAIL WITH
STEEL POSTS, ITEM 543
~~1480+13 - 1489+00 Rt~~
1481+74 - 1482+42 Lt & Rt
SURVEY
POST 1482+11.7
Δ 16°06'
B.M. #38
24" Pine St
Elev 318.09
INAC. PI 1484+67.4=
1484+53.3
Δ 32°09' Rt
D 4° 30'
SURVEY
POST 1486+86.5
Δ 15°56'
REV PI 1484+93.0=
1484+71.1
MARTIN & VERA PERRY
29 C
1.02 ACRES ±
1476+77 - 1484+85
29 D
0.14 ACRE ±
1475+67 - 1482+16
REMOVE 3 ITEM 110
Clearing and Grubbing Item 104
Begin Seeding, Item 621
End Seeding, Item 621
Begin Topsoil, Item 621
LEVI W & THEDA M DEAN
30 A
1.68 ACRE
1484+85 - 1494+76
house
barn
woods
245.7
243.2
125.0
35.6
New 18" x 28" RCP
Crushed Gravel M1P Surface Course with Cutback Asphalt and Prime Coat of Refined Tar, Mod Item 342
3 Wide placed in Invert of Pipe
REVISED
Δ 33° 28' Rt
D 4° 30'
R 1273.6
T 382.8
L 743.7
E 56.8
bank 3/4 per ft
Clearing and Grubbing Item 104
Construct New Well, Install Pump, Pump Control Box and Pressure Tank for detailed plan see sheet 3 of 11.9
New 18" x 28" RCP D-50 Inlet with cover, Lt. Slope Fill for Slope Protection, Item 521-C
30 B
0.38 ACRE
1485+17 - 1494+82
MARTIN & VERA PERRY
LEVI W & THEDA M. DEAN
N 70° 24' E
1478 N 39° 10' E 1477
1494.8
1486.8
1487.8
1485.0
1483.5
1482.5
