STEEL GUIDE POSTS
Lt.
31+0 – 31+20 @ 16' ℄

CONSTRUCT DRIVE
Lt. 34+25
Rt. 26+50±

TOPSOIL AND SEEDING
Lt.
Rt. ~~27+50 – 28+75~~

THREE CABLE GUARD RAIL WITH STEEL POSTS
Lt.
Rt. ~~27+50 – 32+30~~
27+10 – 32+67

CONSTRUCT APPROACH
32+76 Rt.

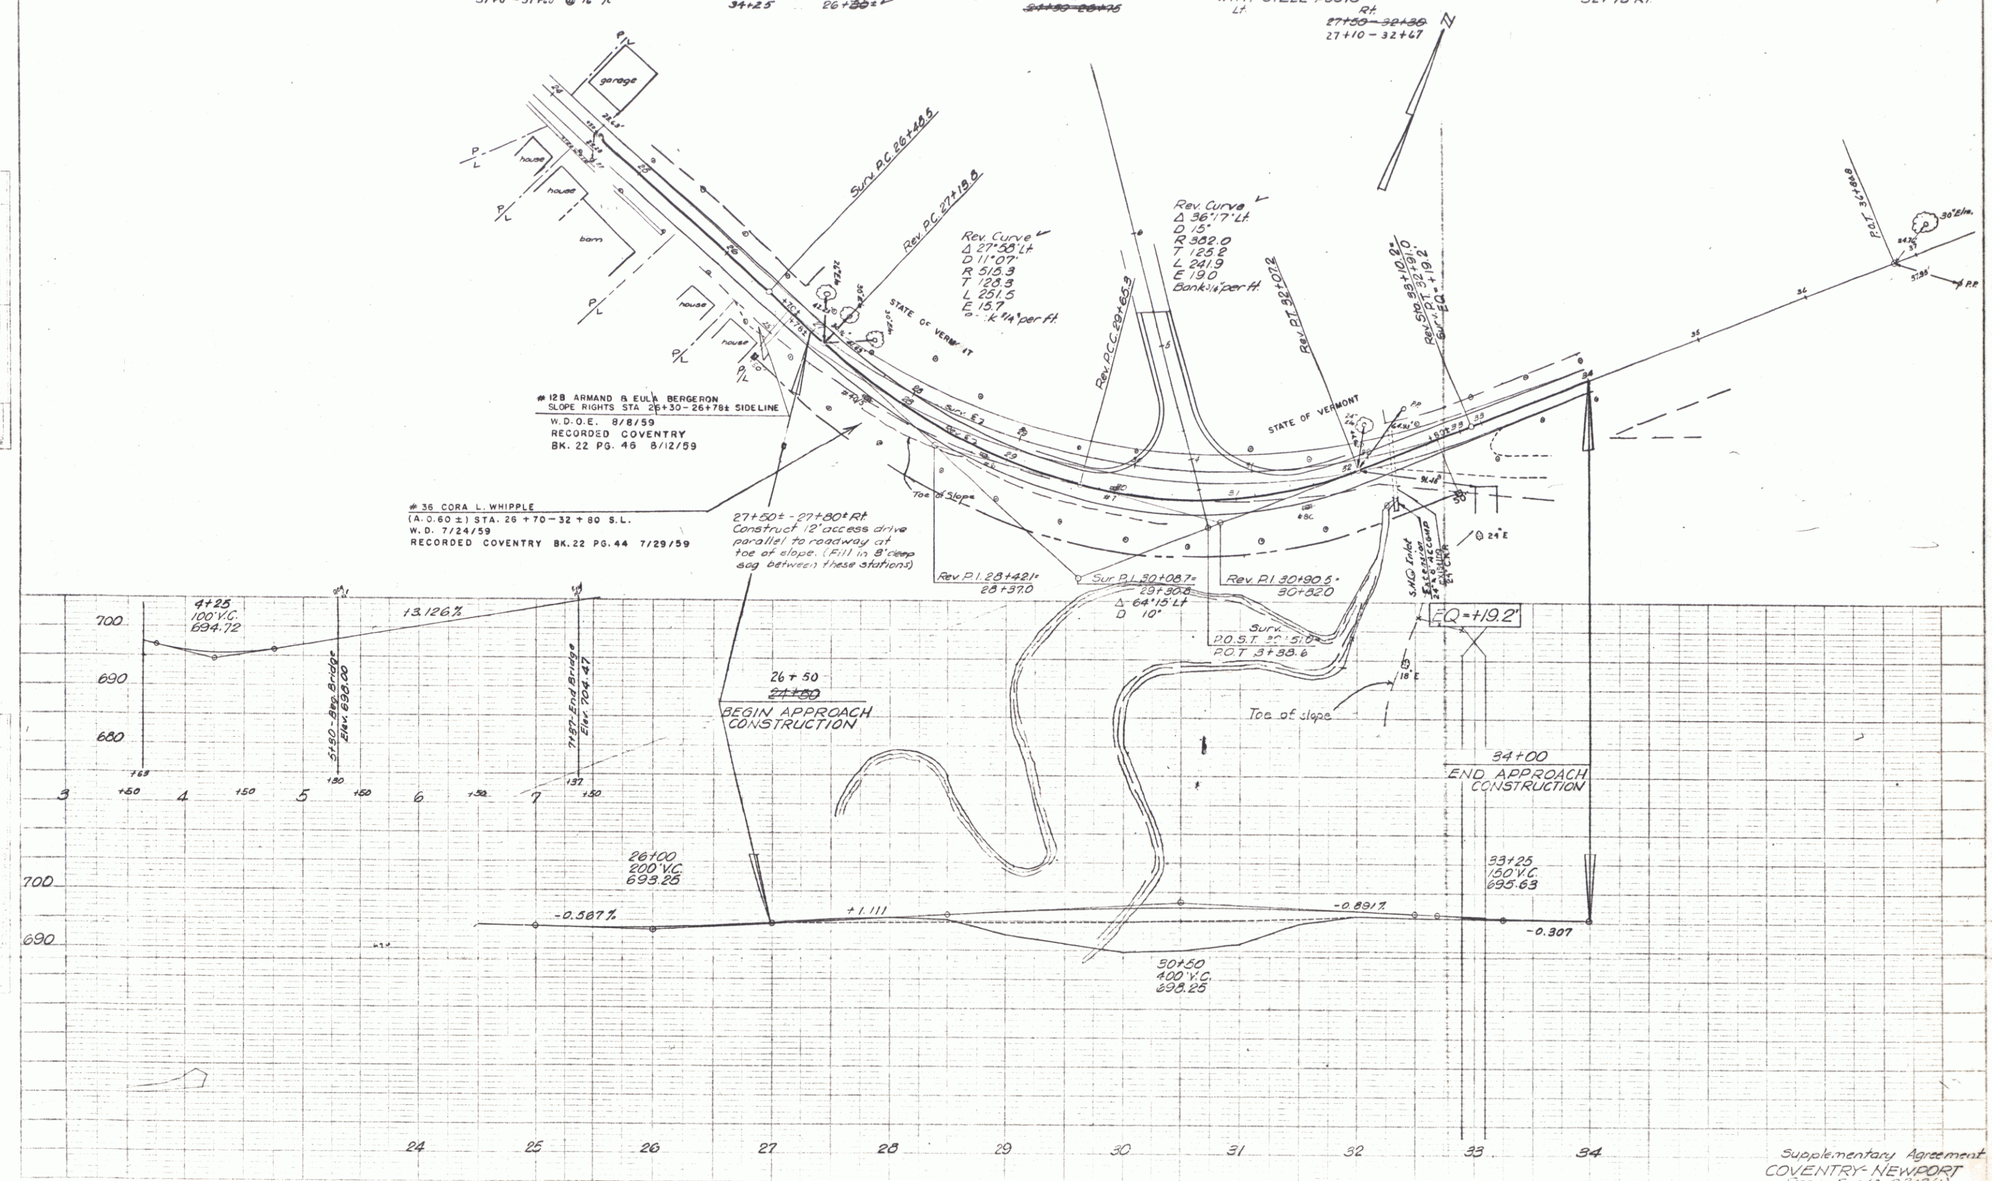

Supplementary Agreement
COVENTRY-NEWPORT
Proj. S ~~N~~ 0513(1)
Sheet ~~23~~ 23A of 143

3