STEEL GUIDE POSTS
Lt 18+60 Rt 16+00

THREE CABLE GUARD RAIL WITH STEEL POSTS
Lt. 12+00-13+35 ~~13+30-18+34~~ 17+77-18+40 15+20-16+00
Rt. 13+50-17+25

DEMOLITION & REMOVAL OF BUILDINGS
Rt.
(2 S.F. Ho.) 12+75±
(Barn) 14+00±

DRILLING & BLASTING OF SOLID ROCK SUBGRADE
~~14+50-15+25~~
~~18+95-19+35~~
13+50-17+25

CONSTRUCT DRIVES
Lt. 18+50 19+50
Rt. ~~12+50~~ 10+75 12+80

REMOVAL & DISPOSAL OF PRESENT GUARD RAIL
Lt. 14+68-16+18 17+80-18+35
Rt. 12+00-13+24

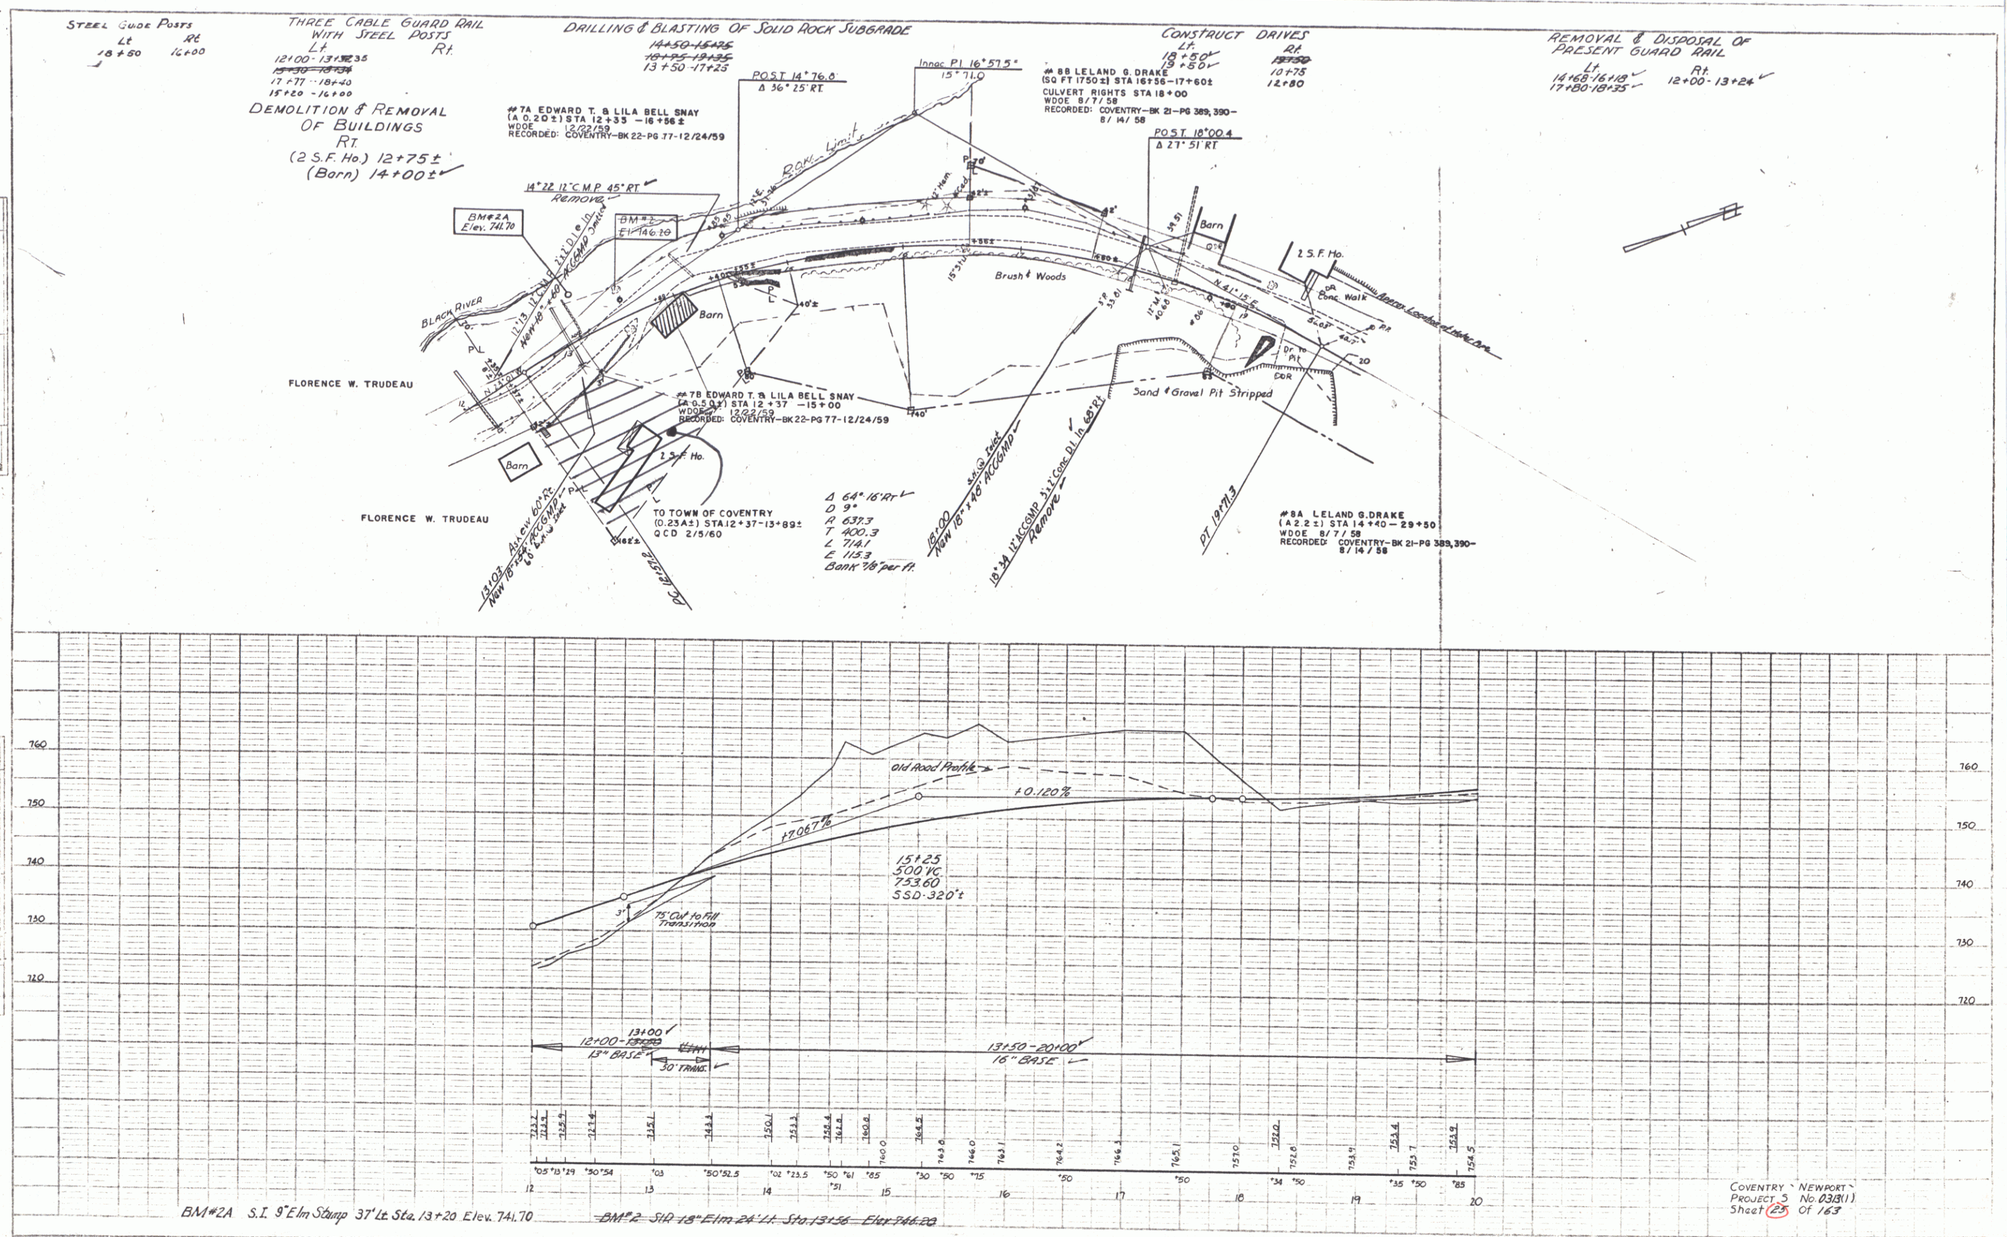

BM#2A S.I. 9" Elm Stump 37' Lt. Sta. 13+20 Elev. 741.70 ~~BM#2 S.I. 18" Elm 24' Lt. Sta. 13+56 Elev. 746.20~~

COVENTRY - NEWPORT
PROJECT 5 No. 03(3)(1)
Sheet 25 Of 163

4