THREE CABLE GUARD RAIL WITH STEEL POSTS
LT. RT.
117+00–126+10
–121+13

STEEL GUIDE POSTS @ 16'%
LT. RT.
128+60 (BARRICADE) ~~130+42–131+06~~

CONSTRUCT DRIVE
121+70 Rt.

STONE FILL for Slope Protection
117+00 - 121+60 Rt.
130+35 - 131+20 Rt.

CONSTRUCT TURNOUT
LT.
128+90 — 132+50 ✓

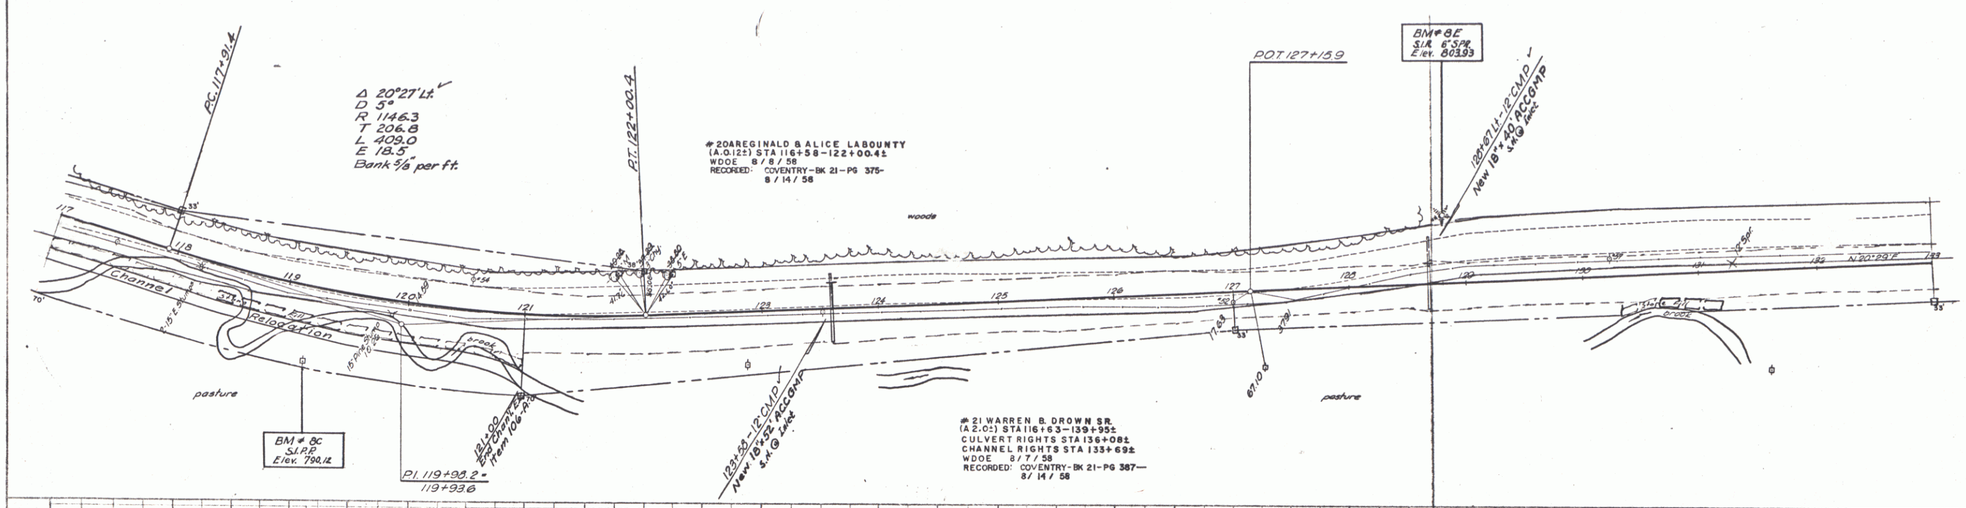

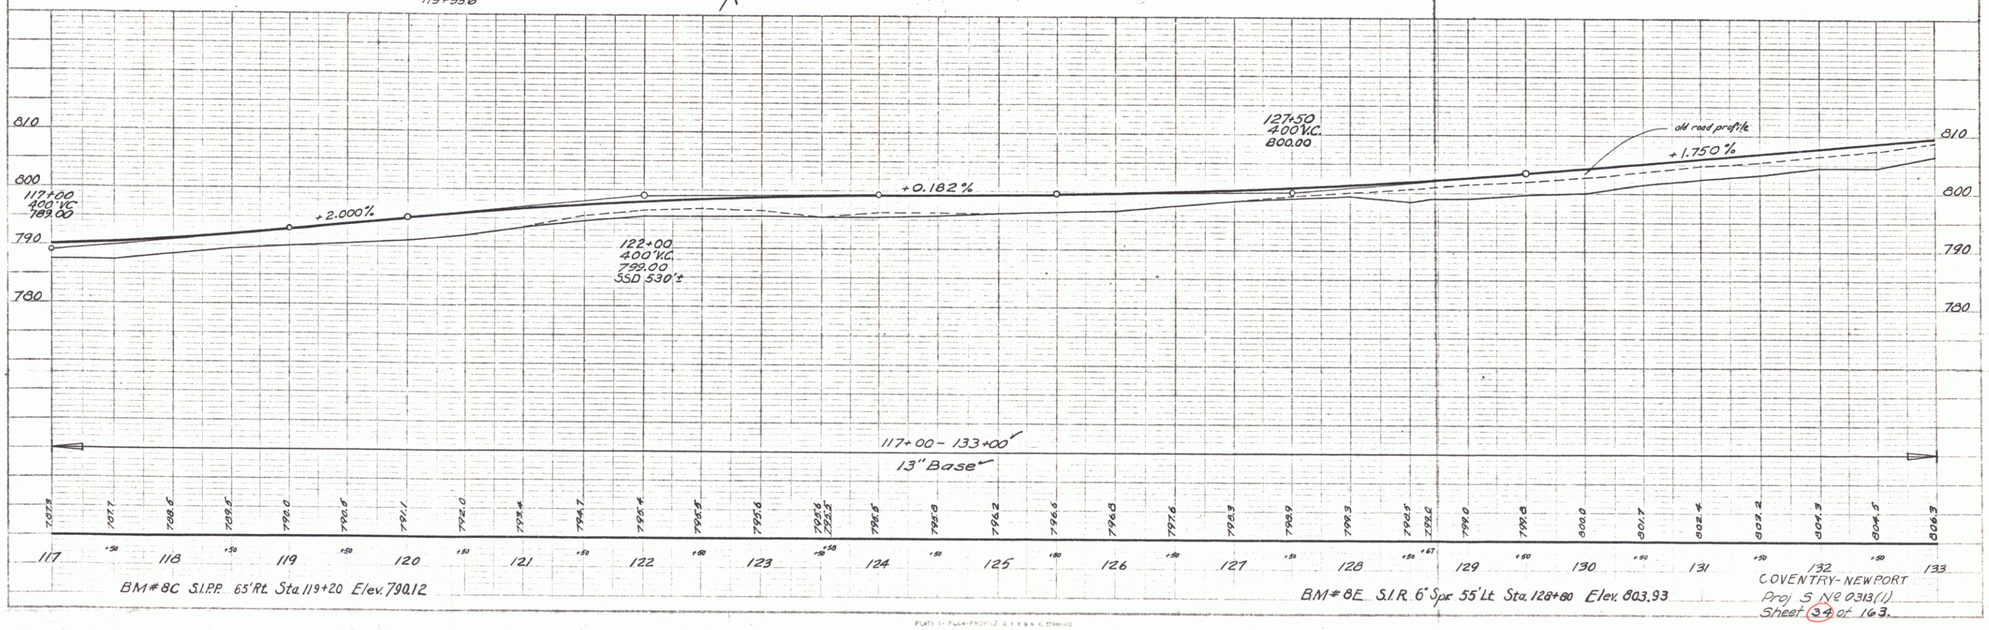

BM#8C S.I.P.P. 65' Rt. Sta. 119+20 Elev. 790.12

BM#8E S.I.R. 6" Spr. 55' Lt. Sta. 128+80 Elev. 803.93

COVENTRY-NEWPORT
Proj. S NO 0313(1)
Sheet 34 of 163.

12