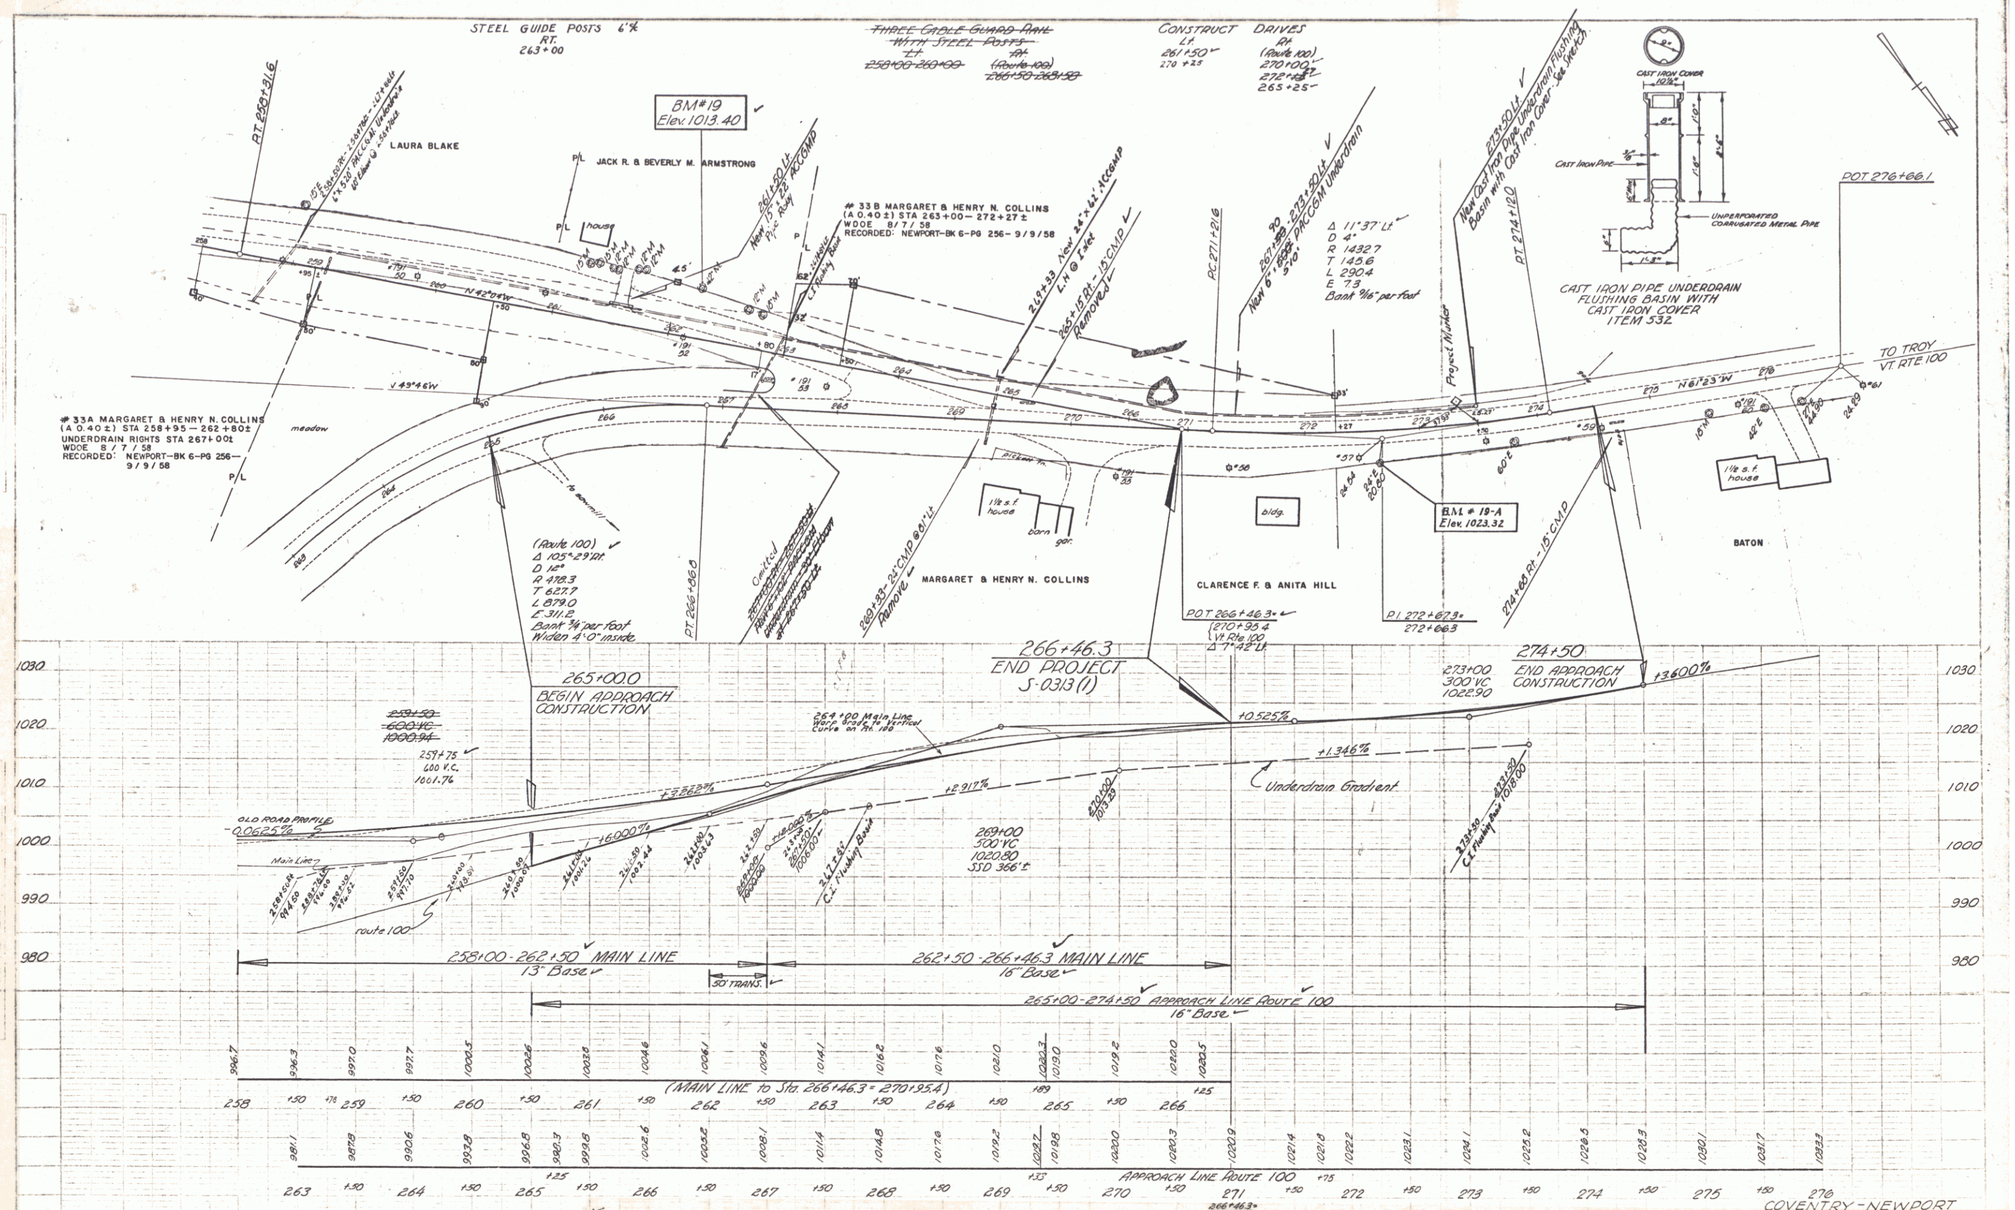

COVENTRY-NEWPORT
Proj. S № 0313(1)
Sheet 17 of 163

22