



PLAN	PROJECT	STATE	NO.
	DATE	BY	SCALE
	REVISIONS	REVISIONS	REVISIONS
	REVISIONS	REVISIONS	REVISIONS

PROFILE	PROJECT	STATE	NO.
	DATE	BY	SCALE
	REVISIONS	REVISIONS	REVISIONS
	REVISIONS	REVISIONS	REVISIONS

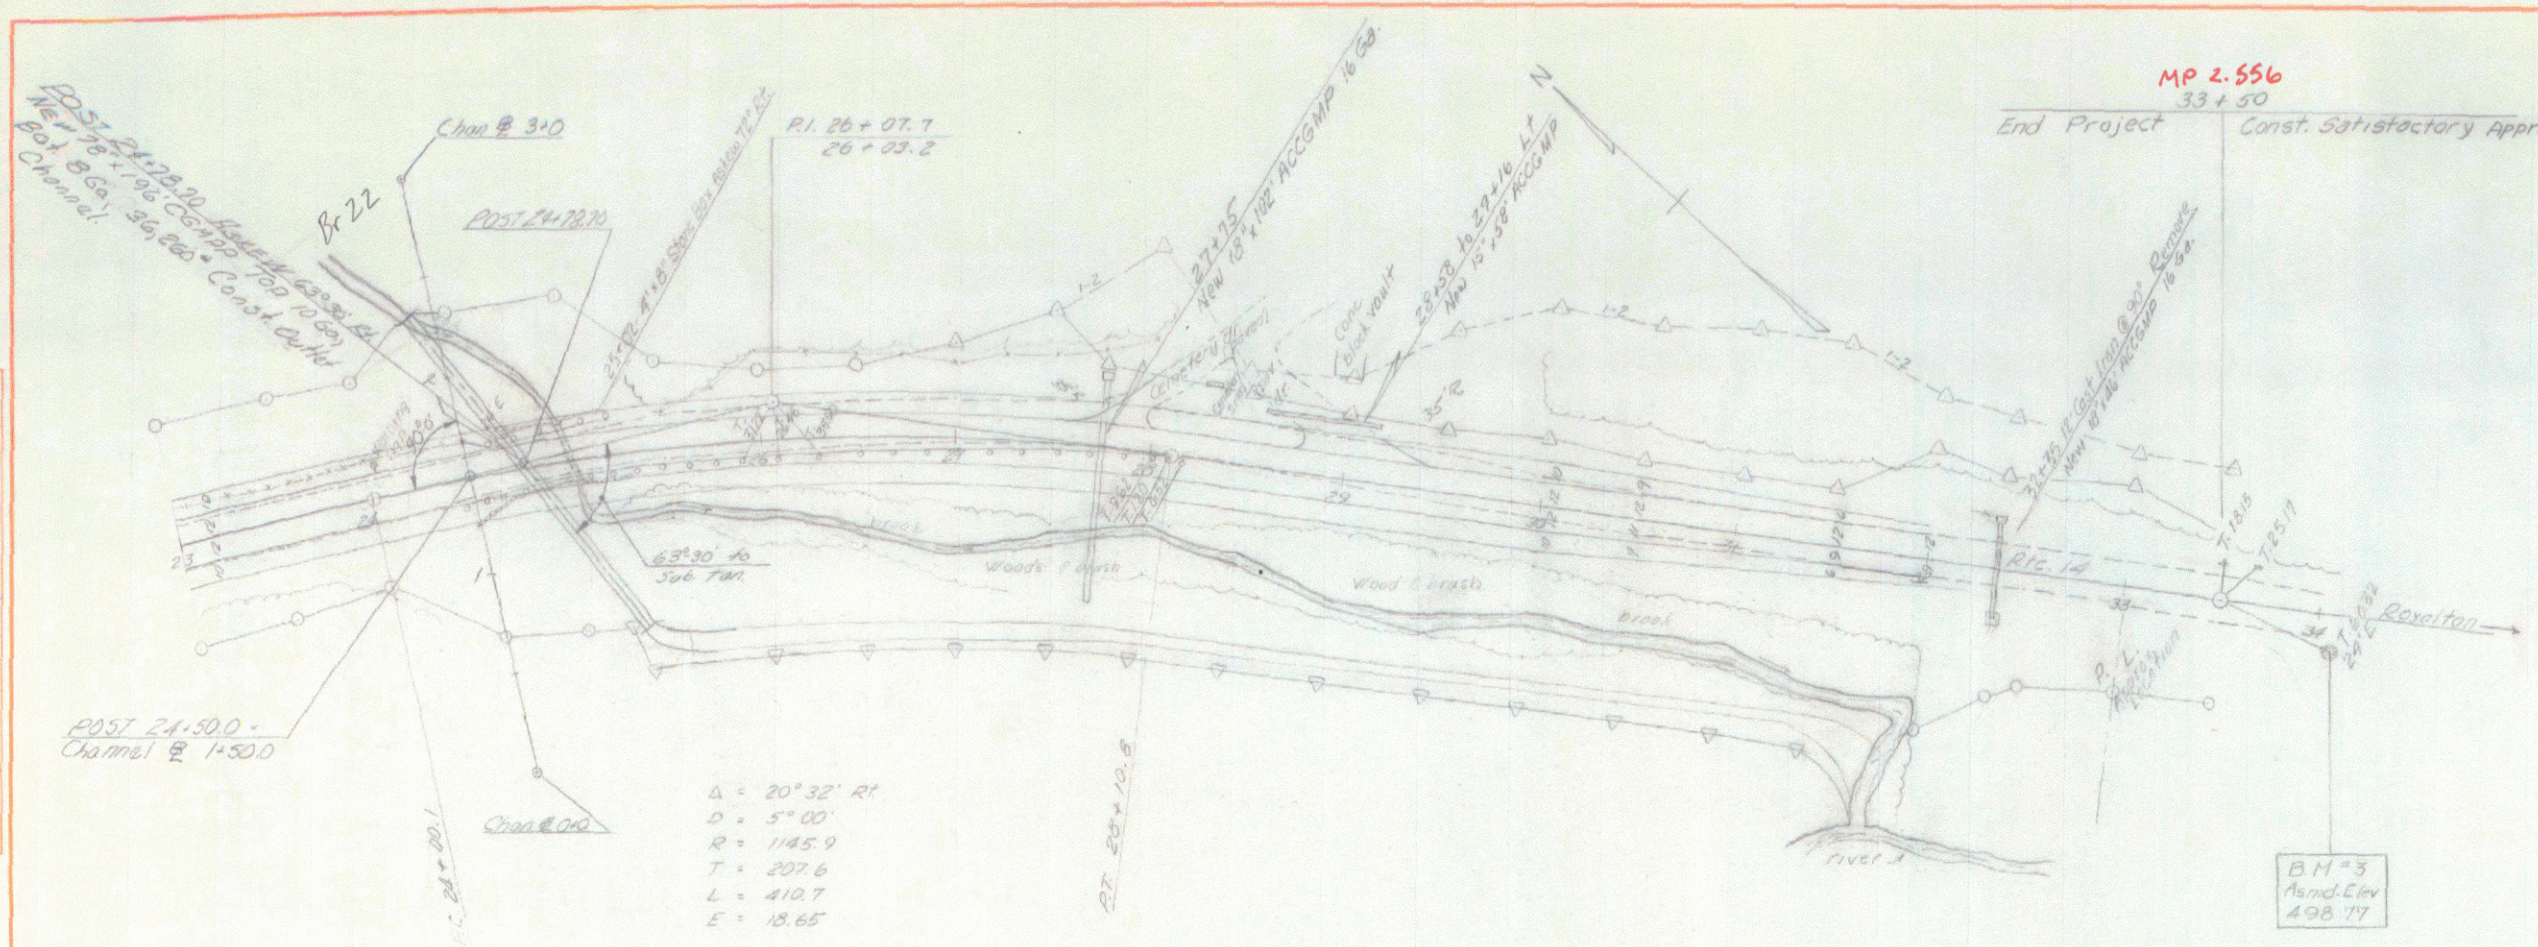

STONE FILL FOR SLOPE PROTECTION ITEM 502
32°35' RT

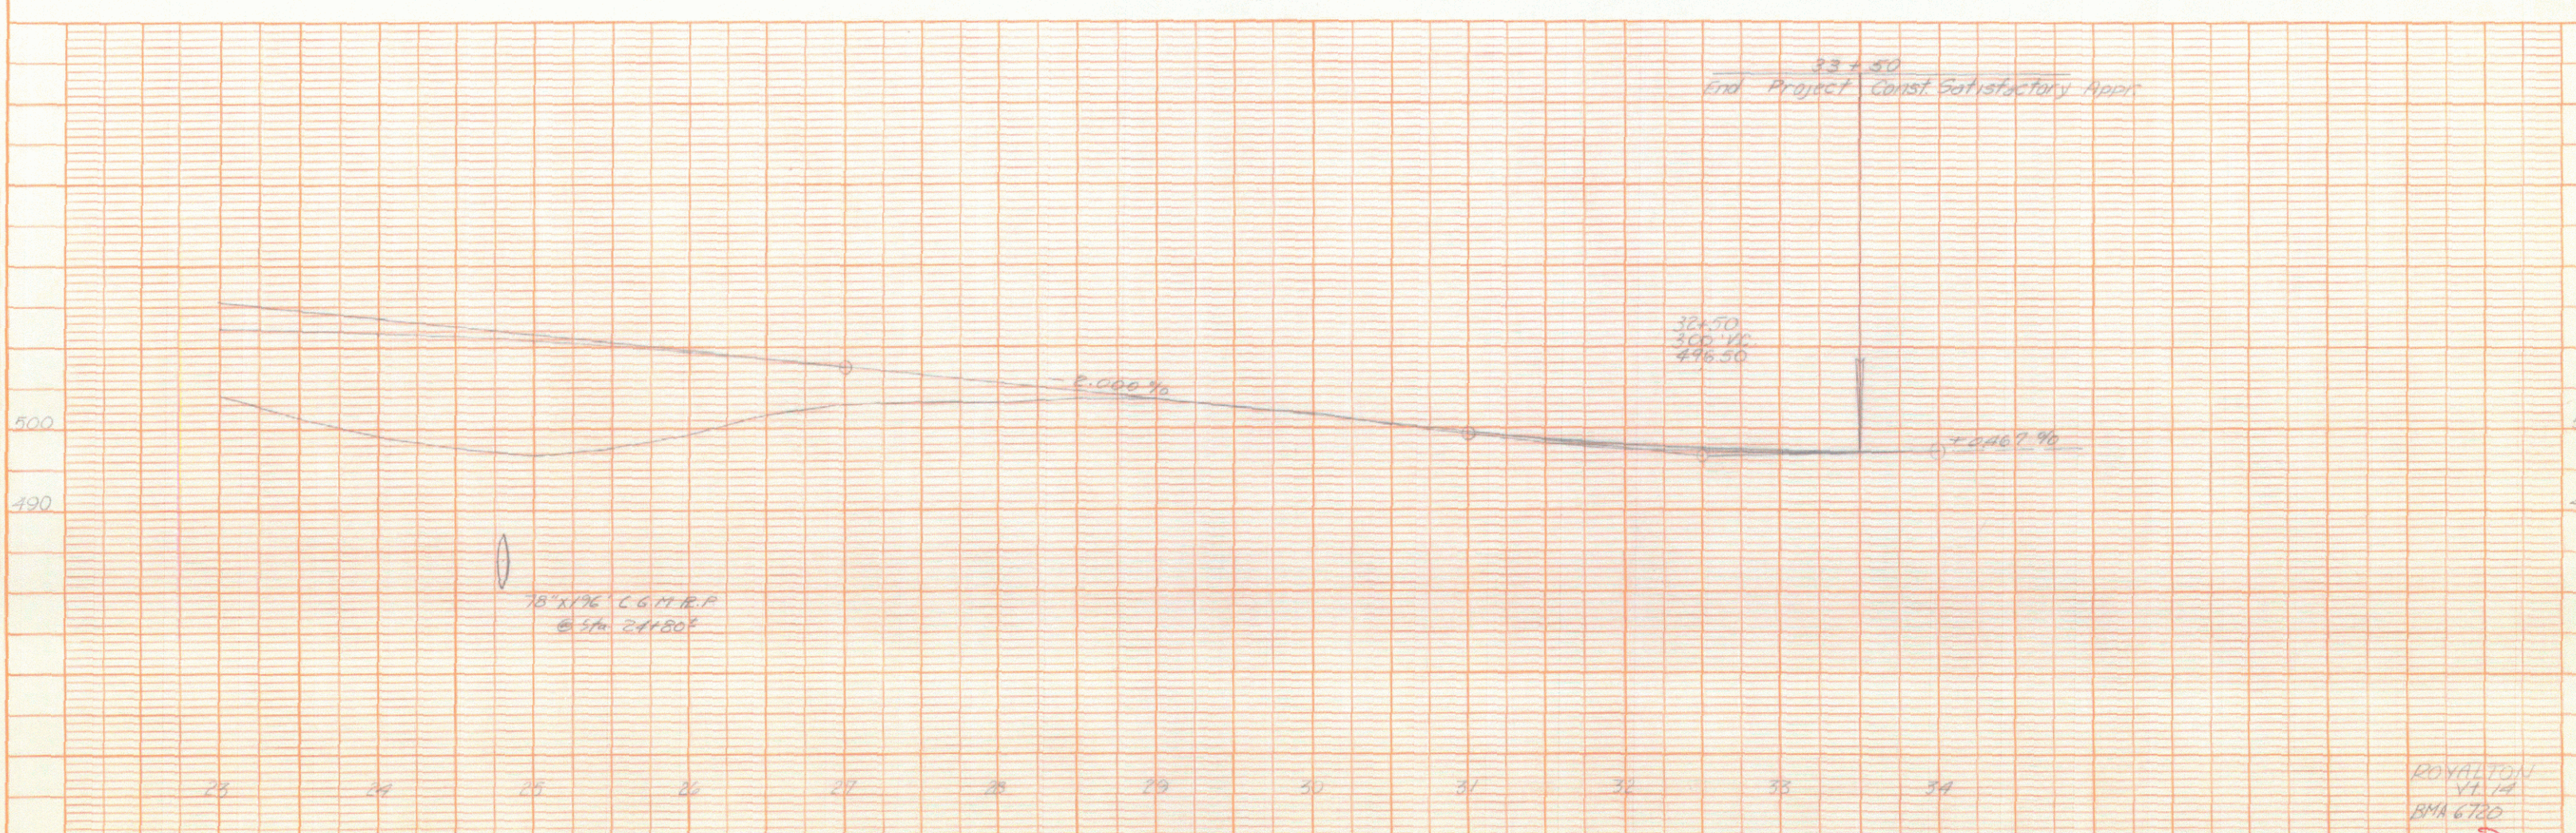

ROYALTON
Vt. 10
BMA 6720
Sheet 3 of 4