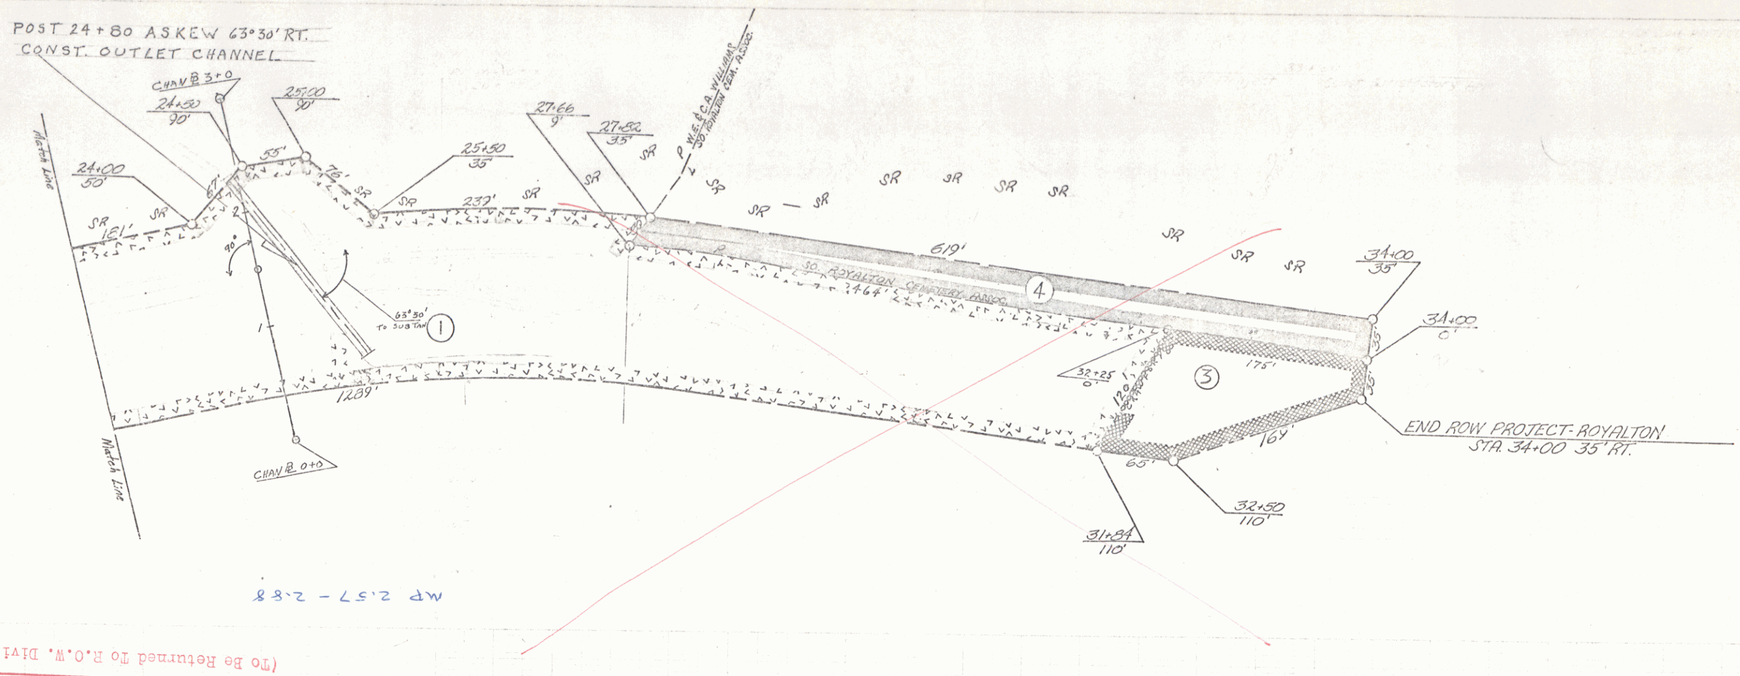


RIGHT-OF-WAY DIVISION
TOWN FILE
PERPETUAL
~~Rec~~ ~~Form~~ of U.I.V
(To Be Returned To R.O.W. Division)