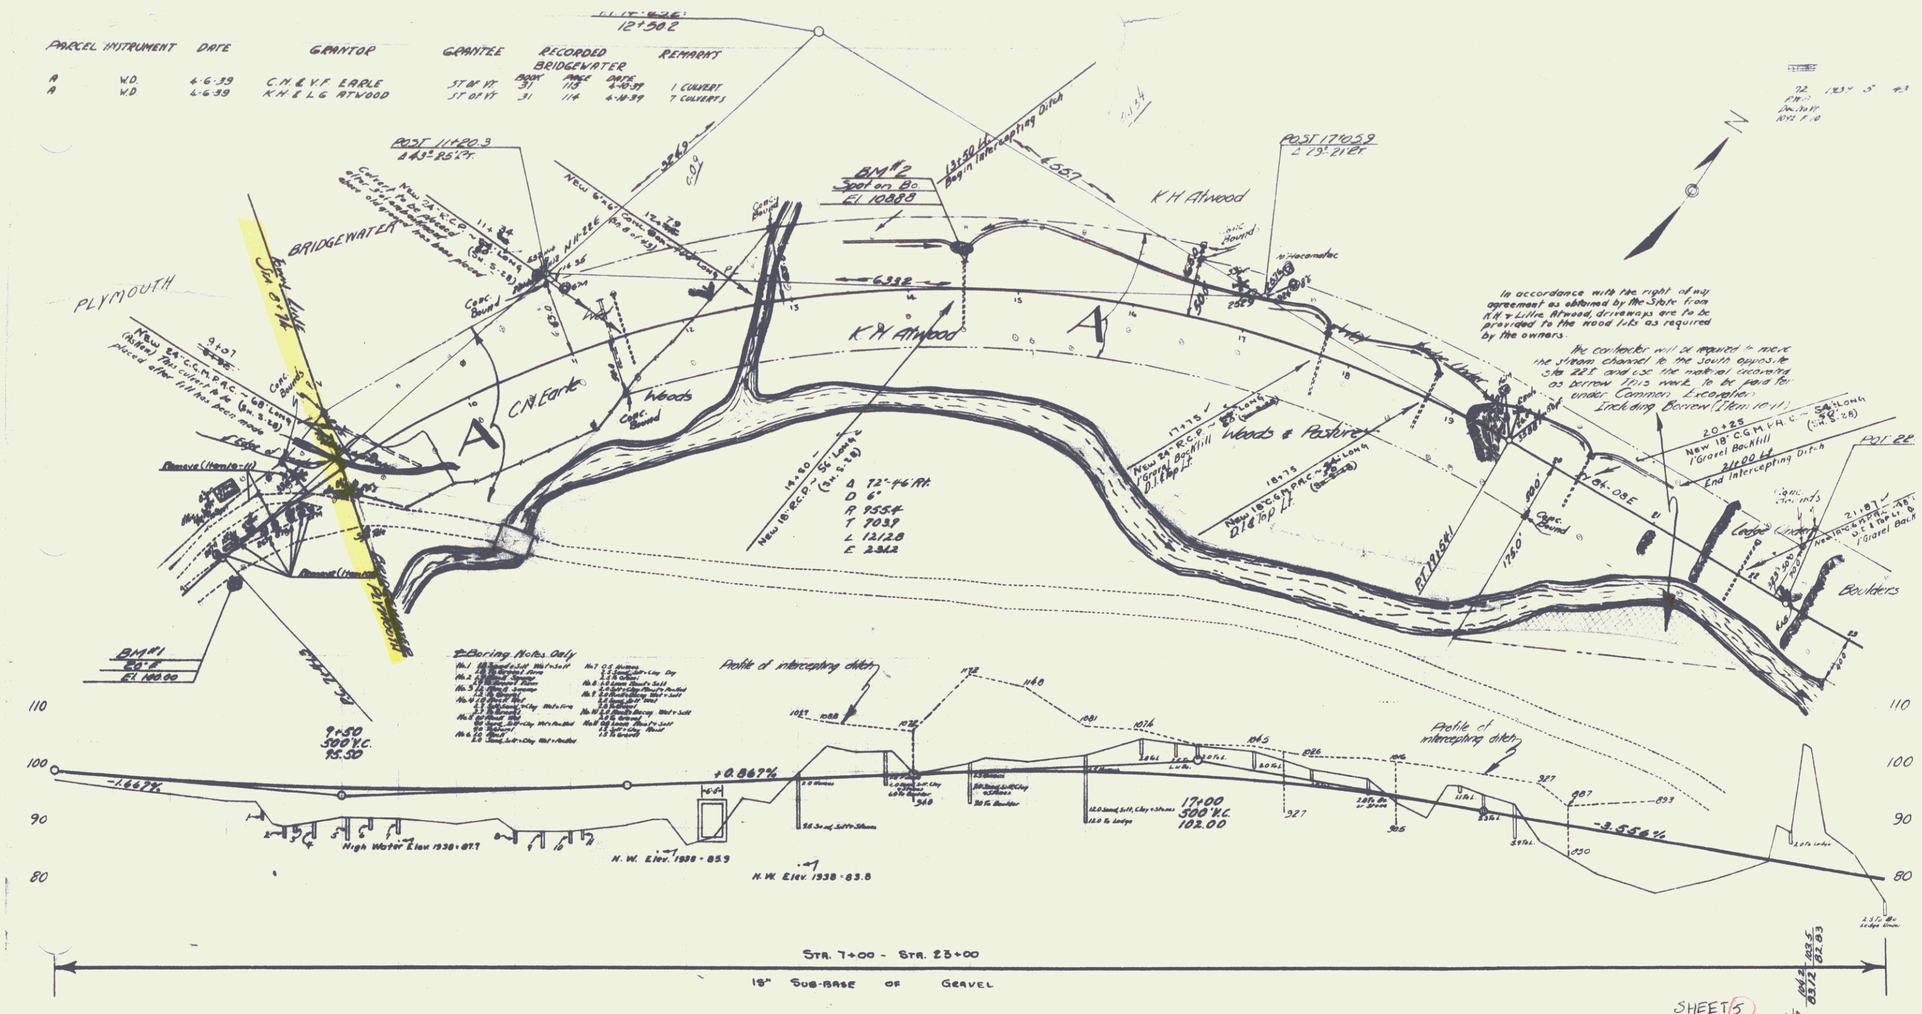PARCEL	INSTRUMENT	DATE	GRANTOR	GRANTEE	RECORDED BRIDGEWATER BOOK	PAGE	DATE	REMARKS
A	W.D.	4-6-39	C.H. & V.F. EARLE	ST OF VT.	31	113	4-10-39	1 CULVERT
A	W.D.	4-6-39	K.H. & L.G. ATWOOD	ST OF VT.	31	114	4-10-39	7 CULVERTS