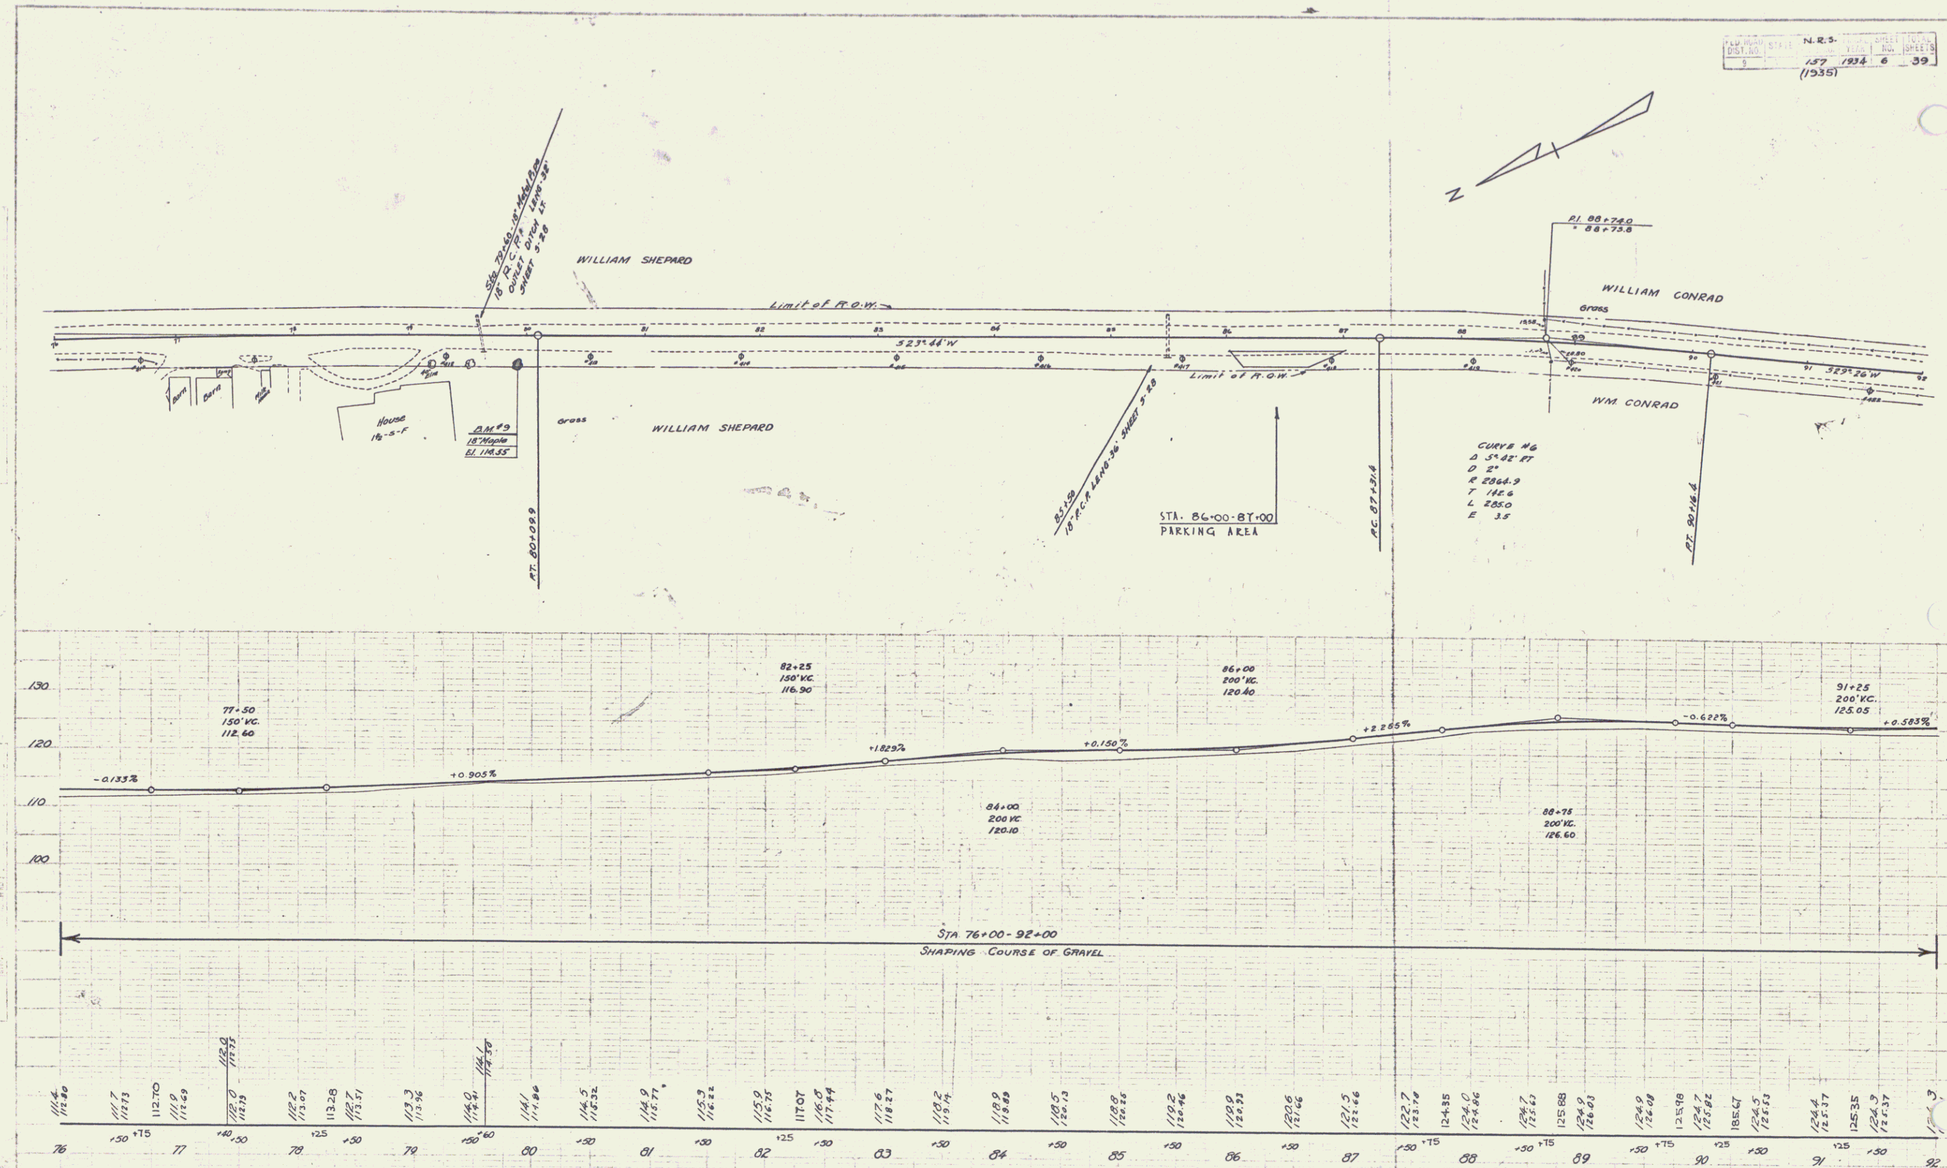| FED. ROAD DIST. NO. | STATE | N.R.S. | | TOTAL SHEETS | SHEET NO. | TOTAL SHEETS |
|---|---|---|---|---|---|---|
| 5 | | 157 (1935) | 1934 | | 6 | 39 |