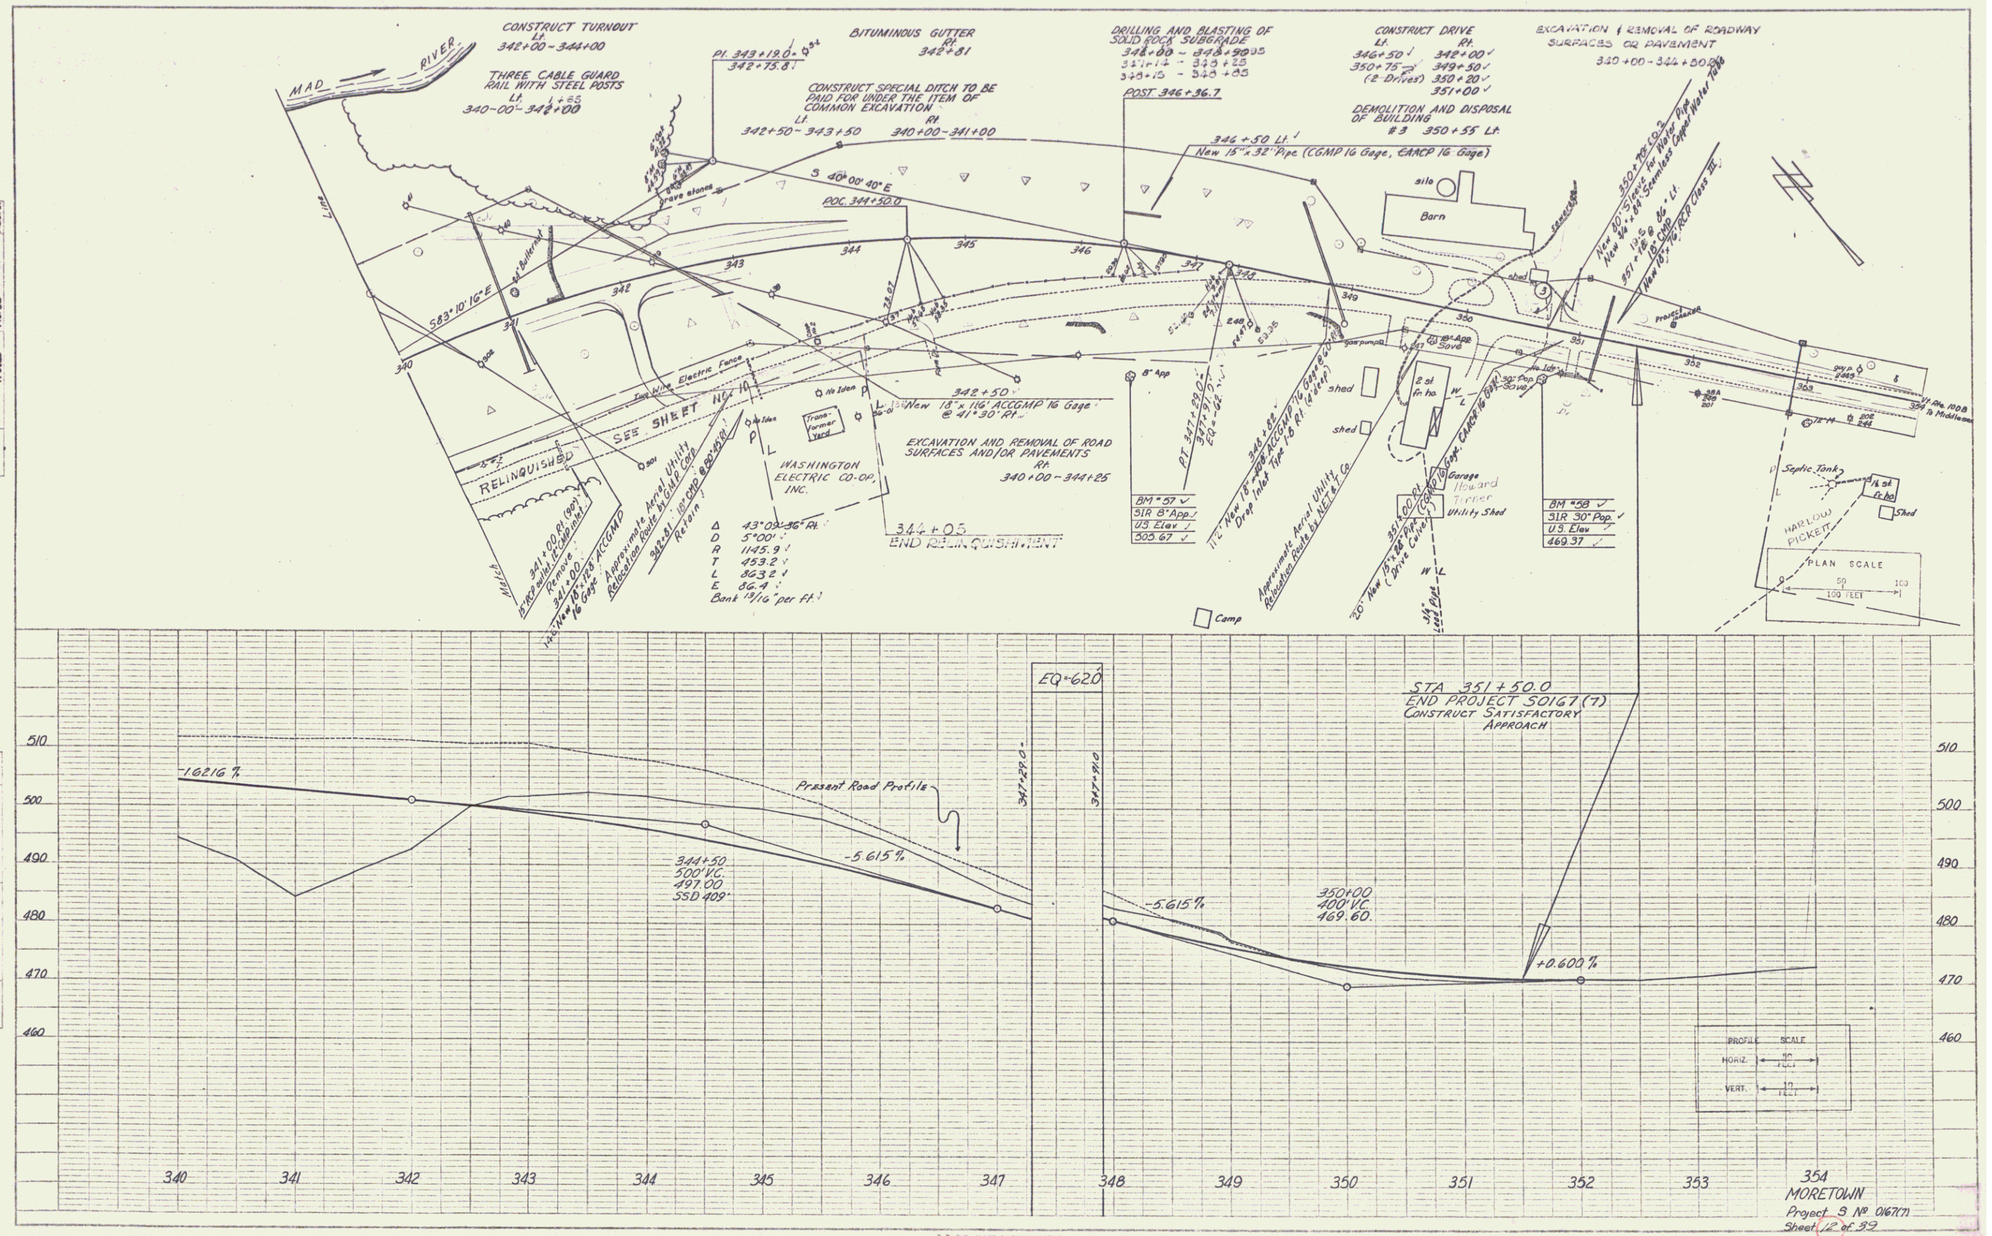

MORETOWN
Project S № 0167(7)
Sheet 12 of 39

PLATE 1 PLAN-PROFILE

8