
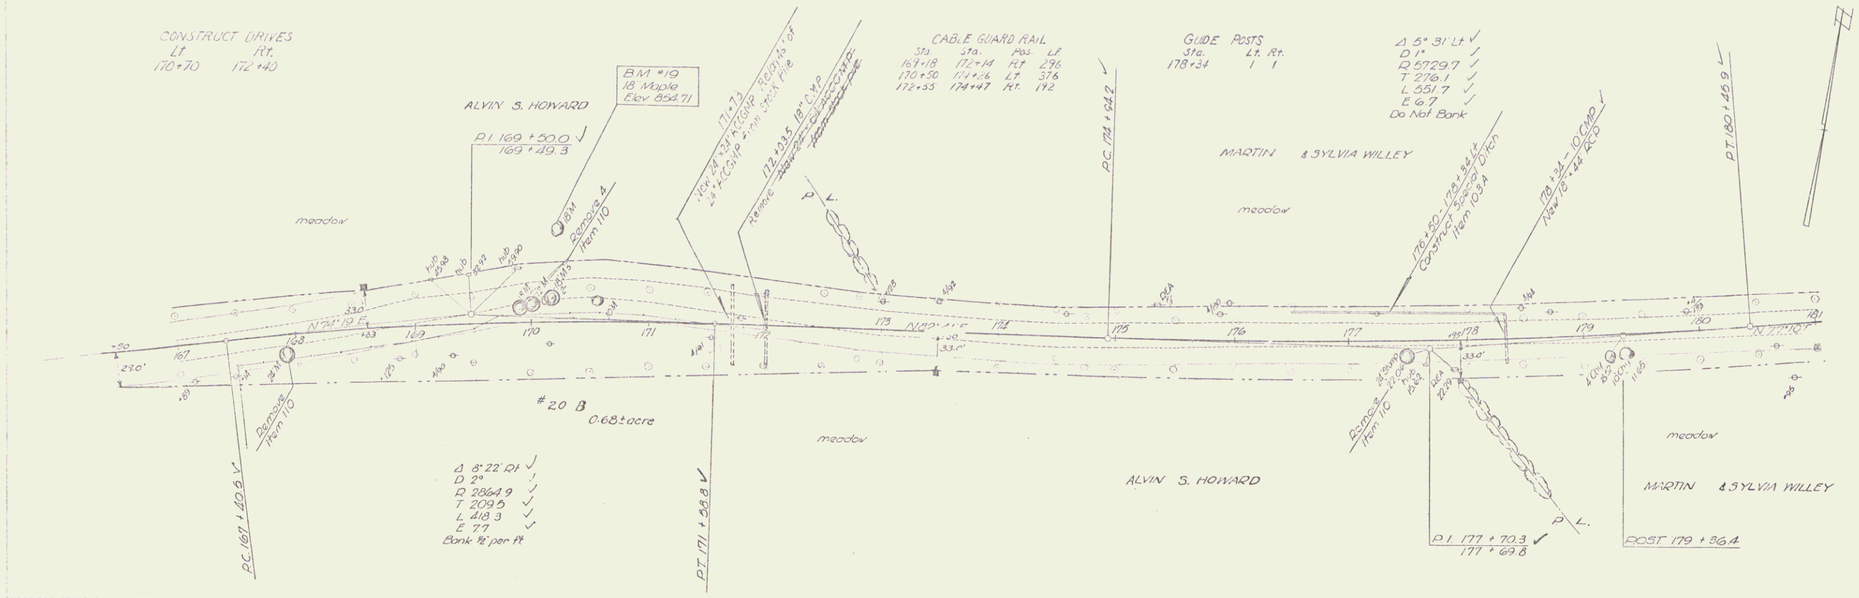


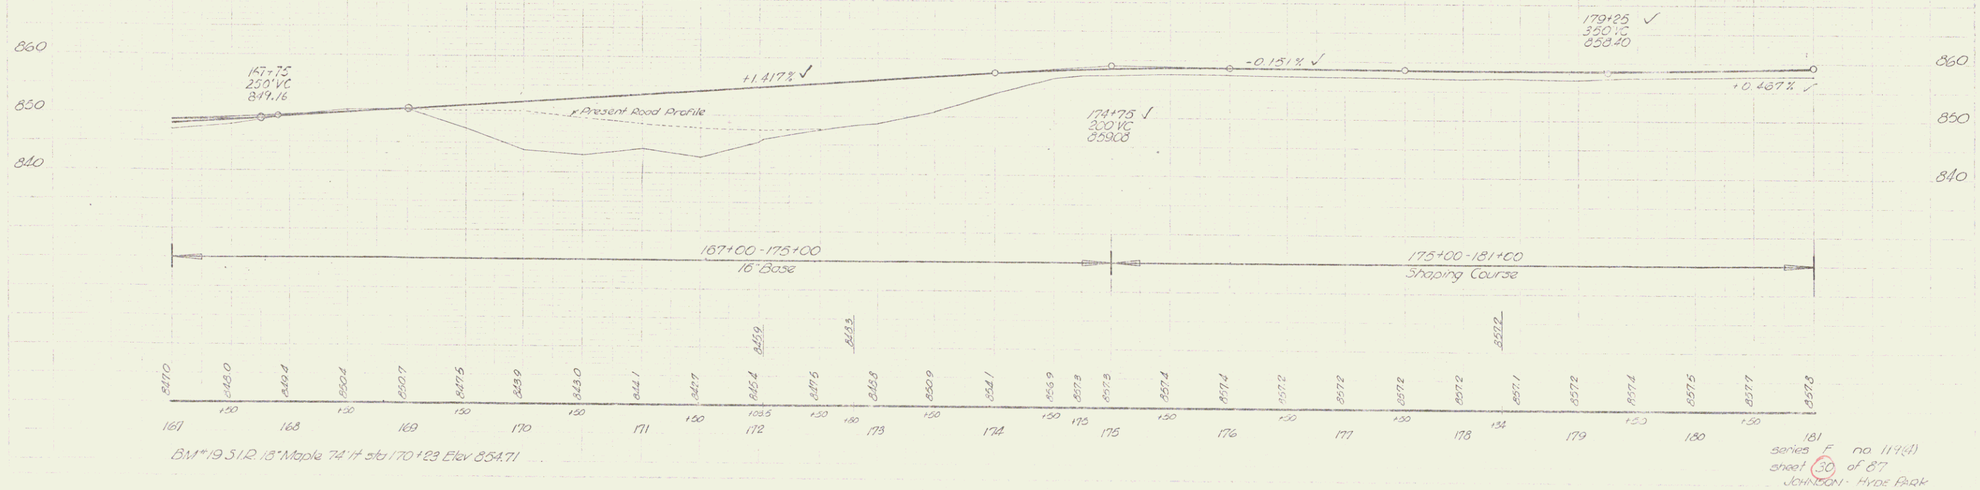

series F no 117(4)
sheet 30 of 87
JOHNSON - HYDE PARK

14