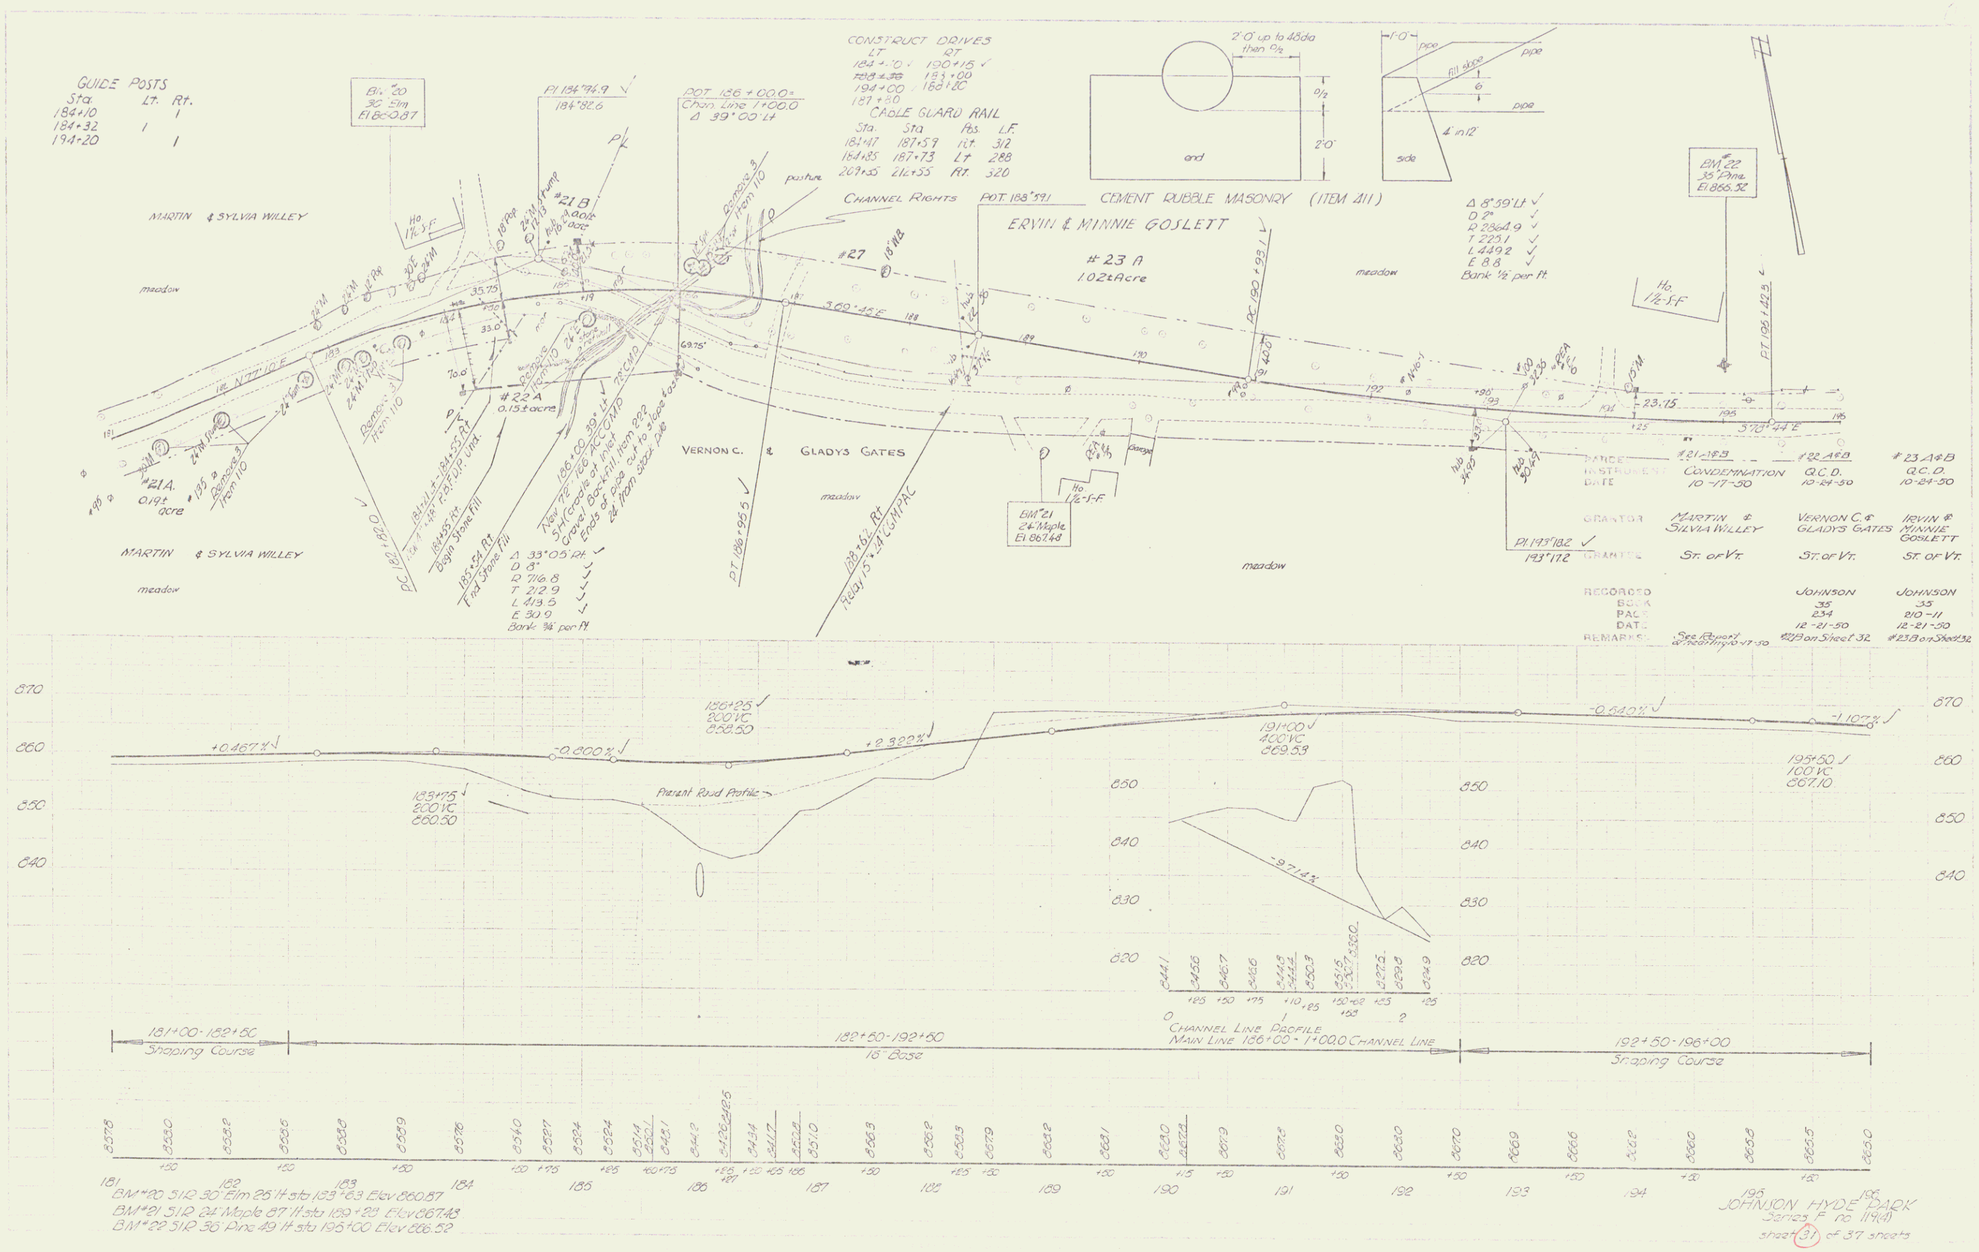
GUIDE POSTS
Sta. Lt. Rt.
184+10 1 1
184+32 1 1
194+20 1 1
CONSTRUCT DRIVES
LT RT
183+70 190+15
194+00 193+00
197+10 198+00
CABLE GUARD RAIL
Sta. Sta. Pos. L.F.
183+47 187+59 Lt. 312
184+85 187+73 Lt. 288
209+55 212+55 Rt. 320
CHANNEL RIGHTS
POT. 188°59.1
CEMENT RUBBLE MASONRY (ITEM 411)
Δ 8°59' Lt
D 2°
R 2864.9
T 225.1
L 449.2
E 8.8
Bank ½ per ft.
MARTIN & SYLVIA WILLEY
meadow
#21A. 0.19± acre
#21B 0.00± acre
#22A 0.13± acre
#23A 1.02± Acre
ERVIN & MINNIE GOSLETT
VERNON C. & GLADYS GATES
S 60°46' E
S 73°44' E
Δ 33°05' Rt.
D 8°
R 716.8
T 212.9
L 413.5
E 30.9
Bank ¾ per ft.
PC 182+82.0
PT 196+95.5
PC 190+93.1
PT 196+42.3
BM #20 30" Elm 26' lt. sta 183+63 Elev 860.87
BM #21 12" 24" Maple 87' lt. sta 189+23 Elev 867.48
BM #22 12" 36" Pine 49' lt. sta 196+00 Elev 866.52
#21-189 | #22 A&B | #23 A&B
CONDEMNATION 10-17-50 | Q.C.D. 10-24-50 | Q.C.D. 10-24-50
GRANTOR: MARTIN & SILVIA WILLEY | VERNON C. & GLADYS GATES | IRVIN & MINNIE GOSLETT
GRANTEE: St. of Vt. | St. of Vt. | St. of Vt.
RECORDED BOOK PAGE DATE: JOHNSON 35 234 12-21-50 | JOHNSON 35 210-11 12-21-50
REMARKS: See Report 10-17-50 | #21B on Sheet 32 | #23B on Sheet 32
+0.467%
-0.800%
+2.320%
-0.640%
-1.107%
-9.714%
Present Road Profile
CHANNEL LINE PROFILE
MAIN LINE 186+00 - 1+00.0 CHANNEL LINE
181+00-182+50 Shaping Course
182+50-192+50 16' Base
192+50-196+00 Shaping Course
JOHNSON HYDE PARK
Sheet 31 of 37 sheets

15